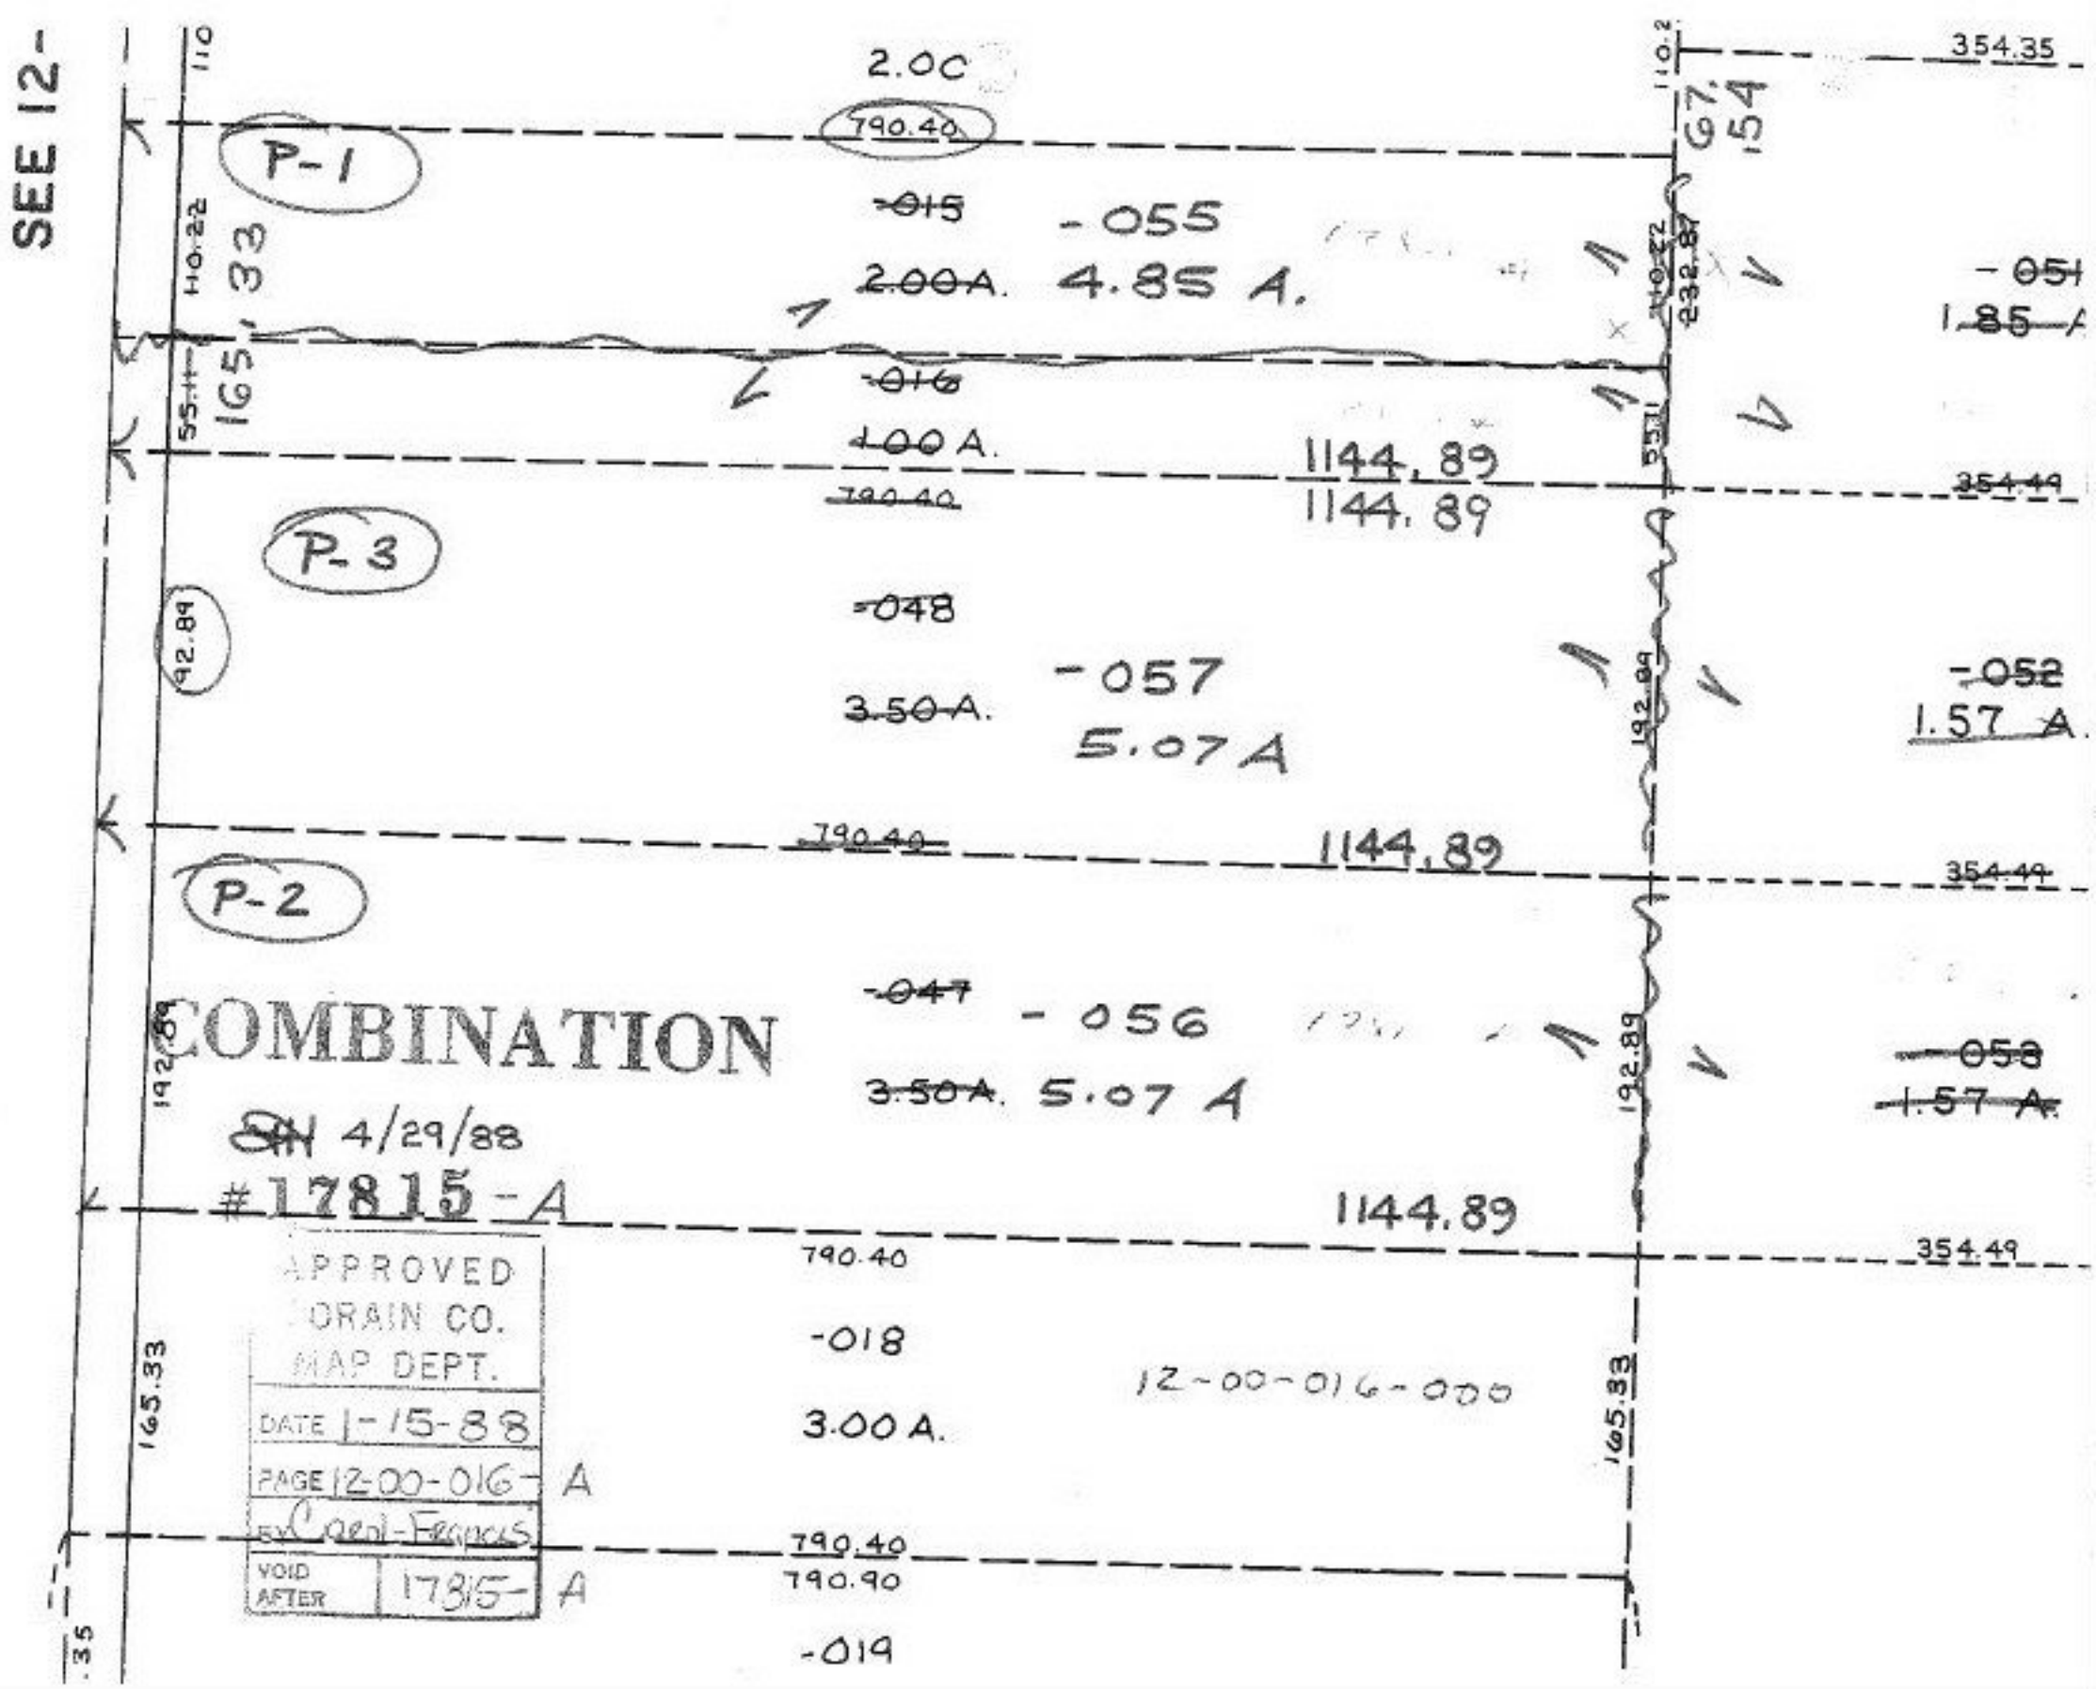
SEE 12-
2.00
790.40
P-1
-015
2.00A.
-055
4.85 A.
-016
1.00 A.
1144.89
1144.89
P-3
-048
3.50A.
-057
5.07 A
P-2
-047
3.50A.
-056
5.07 A
COMBINATION
SH 4/29/88
#17815-A
APPROVED
DRAIN CO.
MAP DEPT.
DATE 1-15-88
PAGE 12-00-016-A
BY Carol-Frances
VOID AFTER 17815-A
790.40
-018
3.00 A.
790.40
790.90
-019
12-00-016-000
354.35
-051
1.85 A
354.49
-052
1.57 A.
354.49
-058
1.57 A.
165.33
192.89
110.22
232.87
55.11
110
110.22
67.154
165.33
92.89
.35