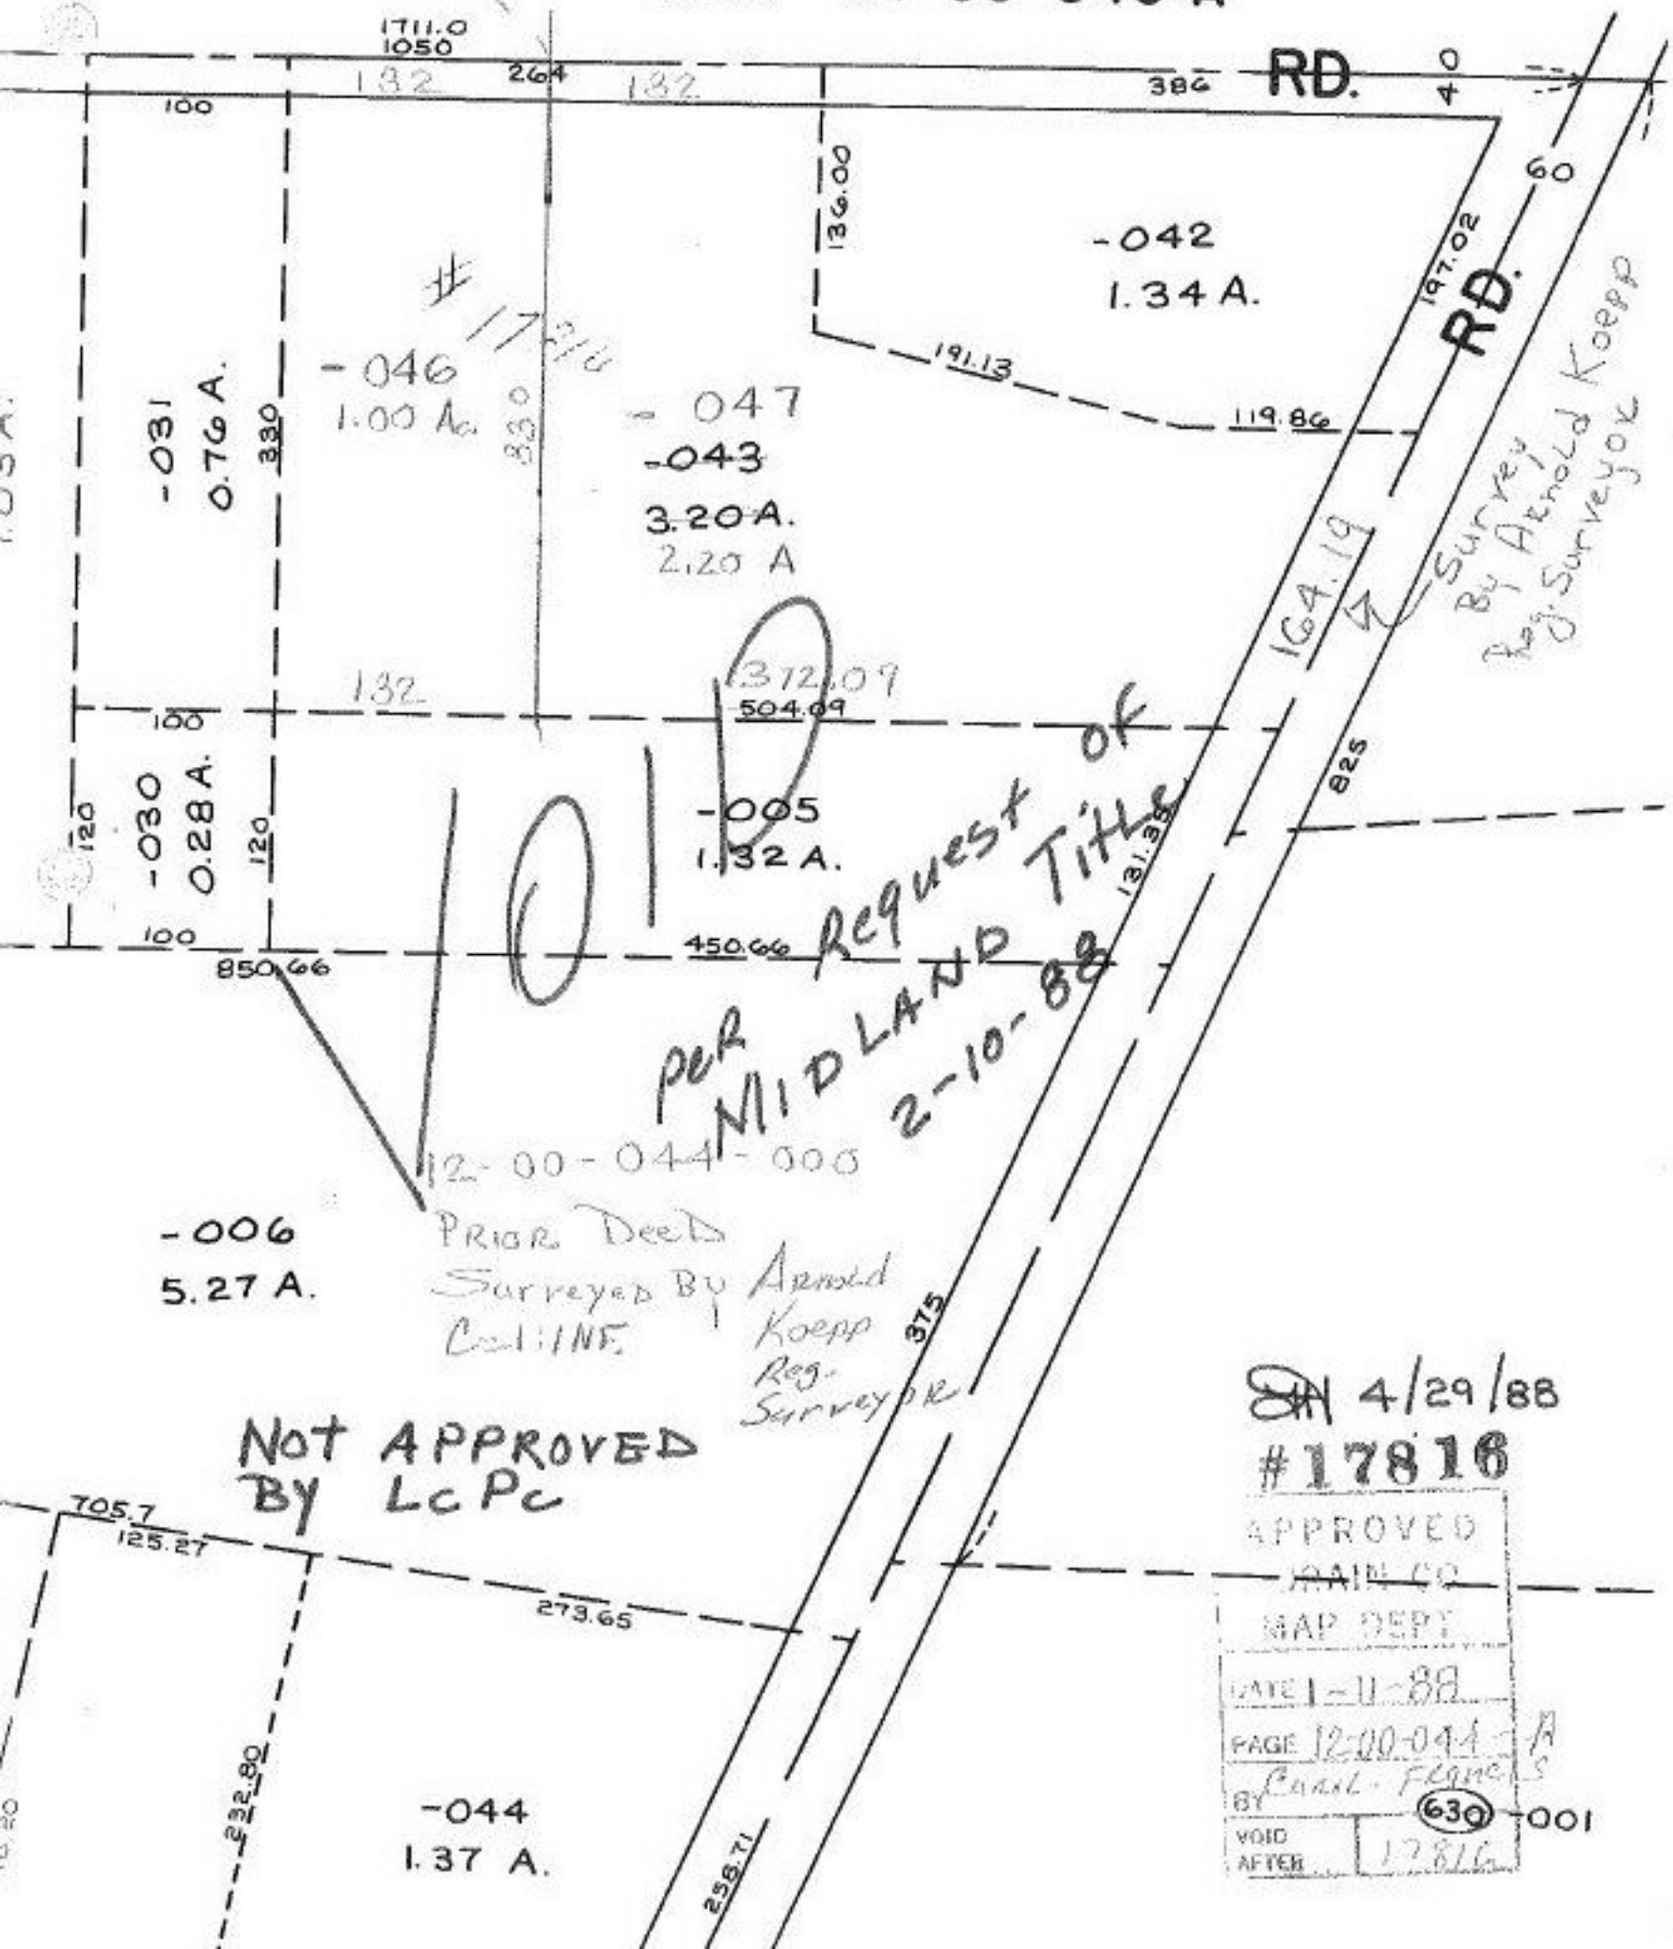SEE 12-00-043-A