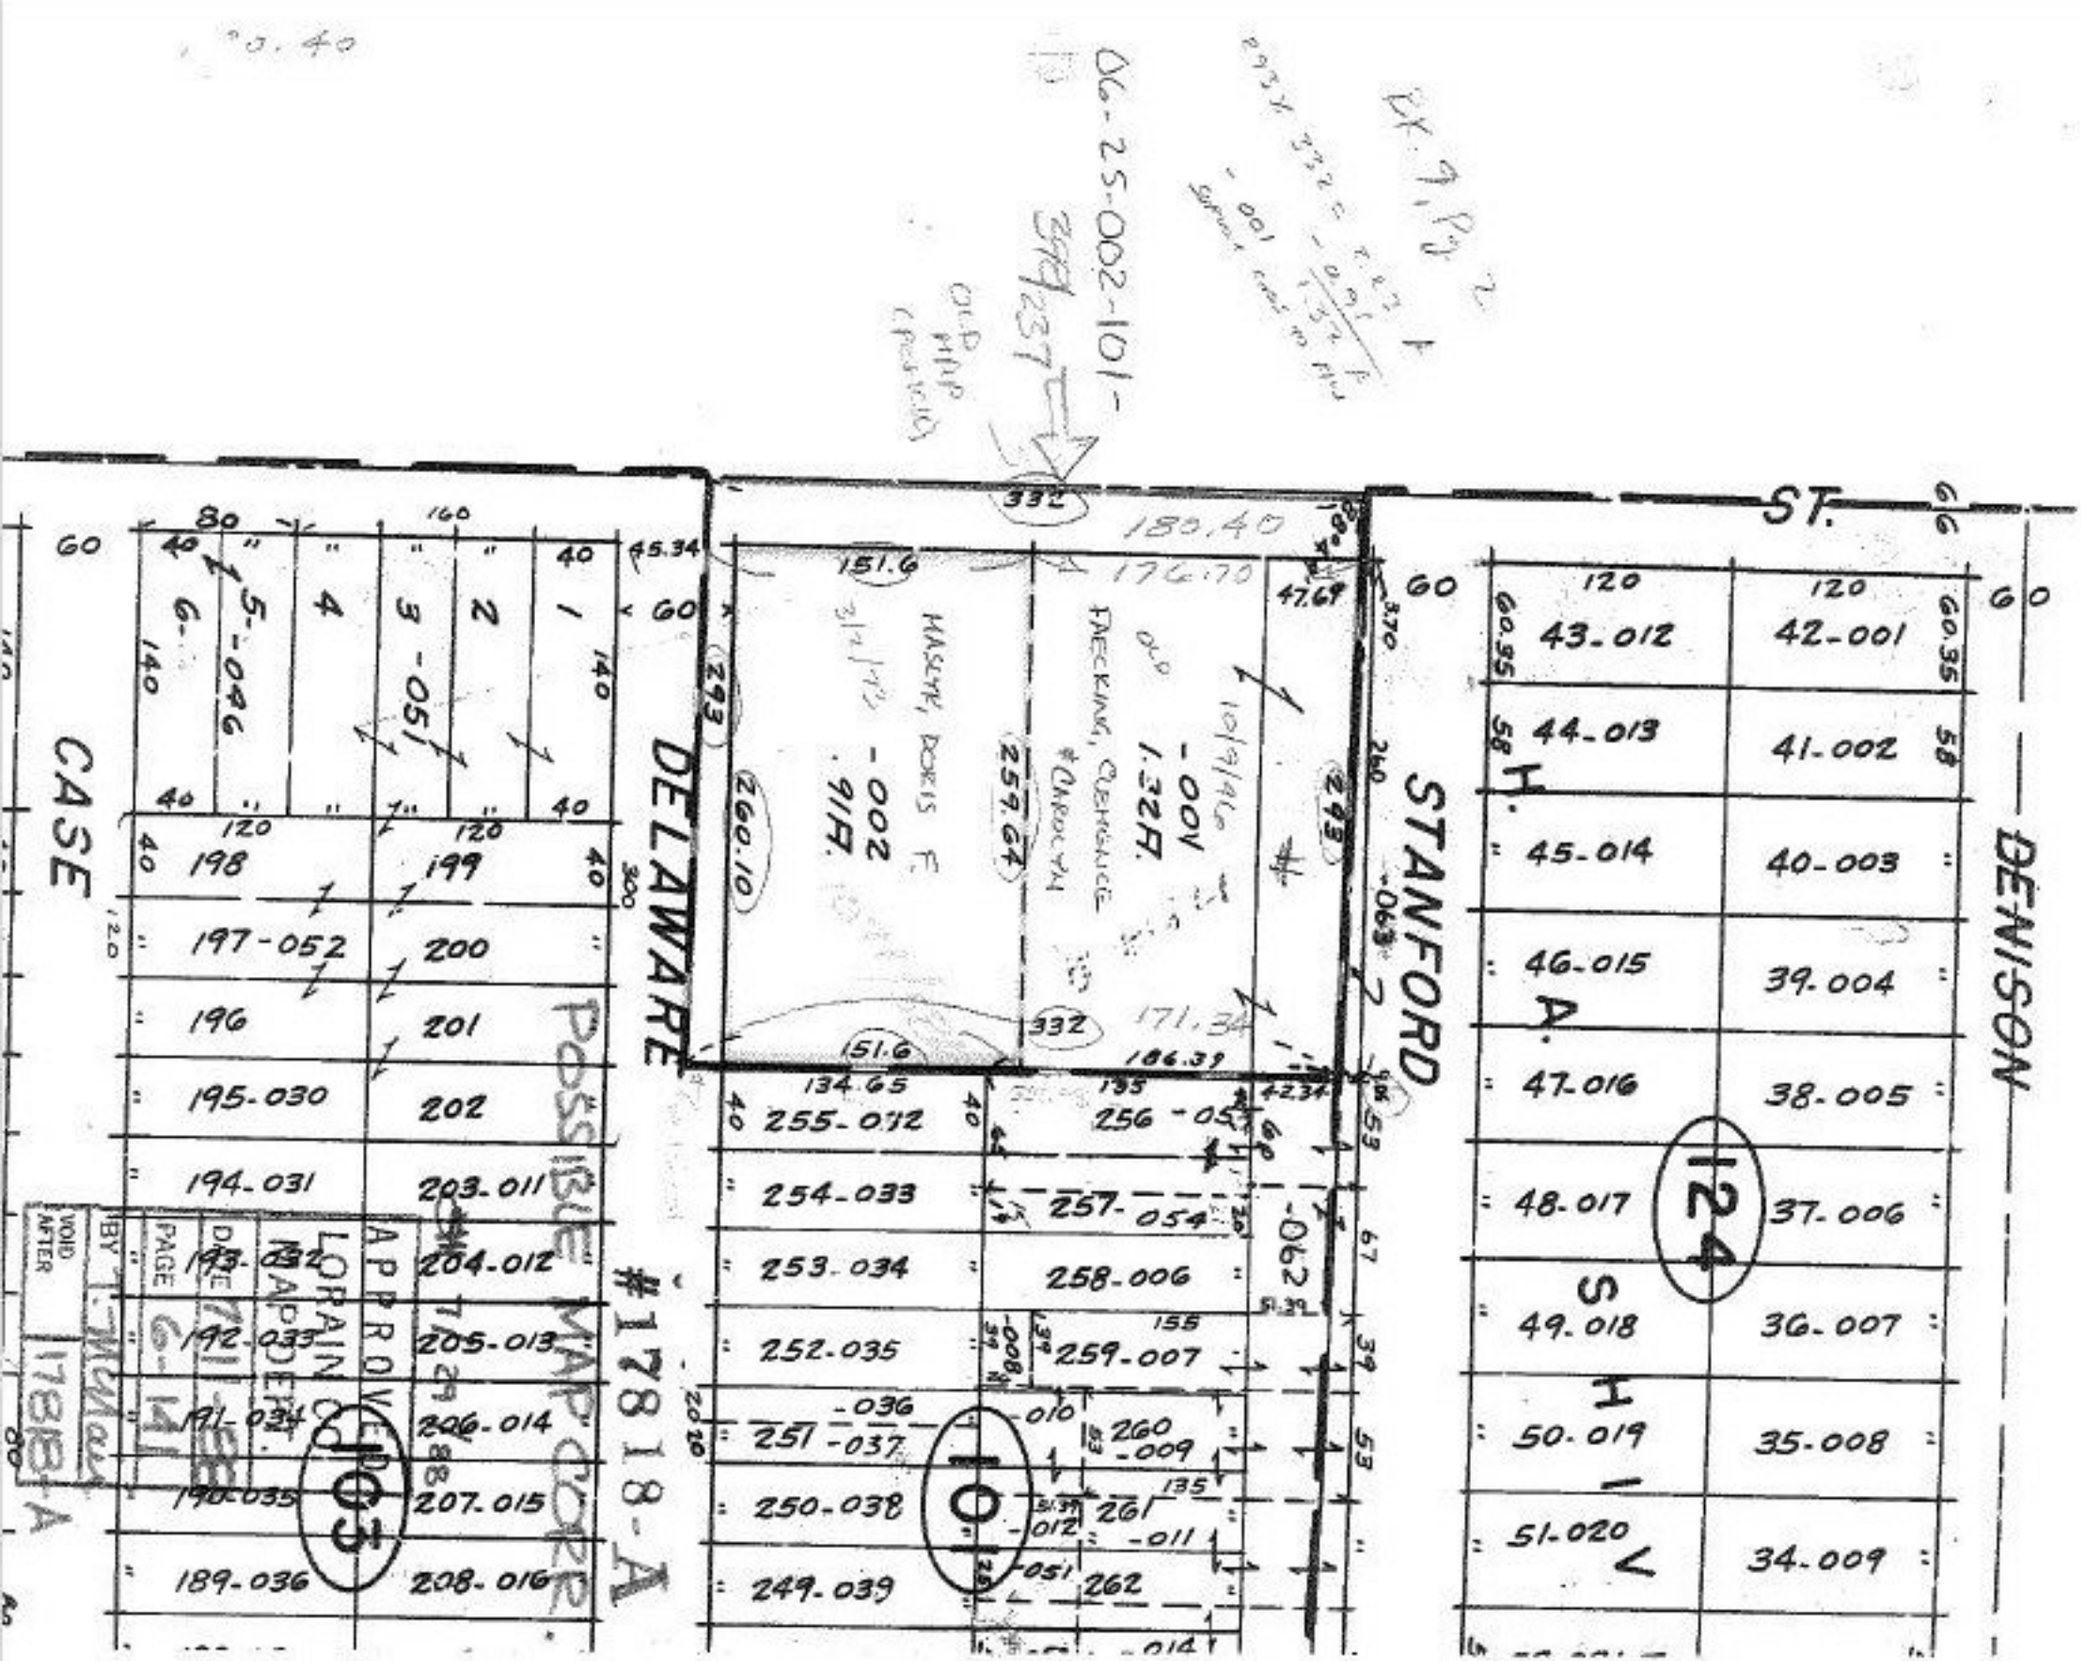
06-25-002-101-
332
180.40
176.70
151.6
47.69
260.10
259.67
171.34
106.39
134.65
DELAWARE
STANFORD
DENISON
ST.
CASE
POSSIBLE MAP CORR.
#17818-A
APPROVED
LORAIN CO.
MAP DEPT.
VOID AFTER
BY
DATE
PAGE
198
199
197-052
200
196
201
195-030
202
194-031
203-011
193-
204-012
192-033
205-013
191-034
206-014
190-035
207-015
189-036
208-016
255-012
256-05
254-033
257-054
253-034
258-006
252-035
259-007
251-037
260
250-038
261
249-039
262
43-012
42-001
44-013
41-002
45-014
40-003
46-015
39-004
47-016
38-005
48-017
37-006
49-018
36-007
50-019
35-008
51-020
34-009
124
H
A
S
H
I
L
L