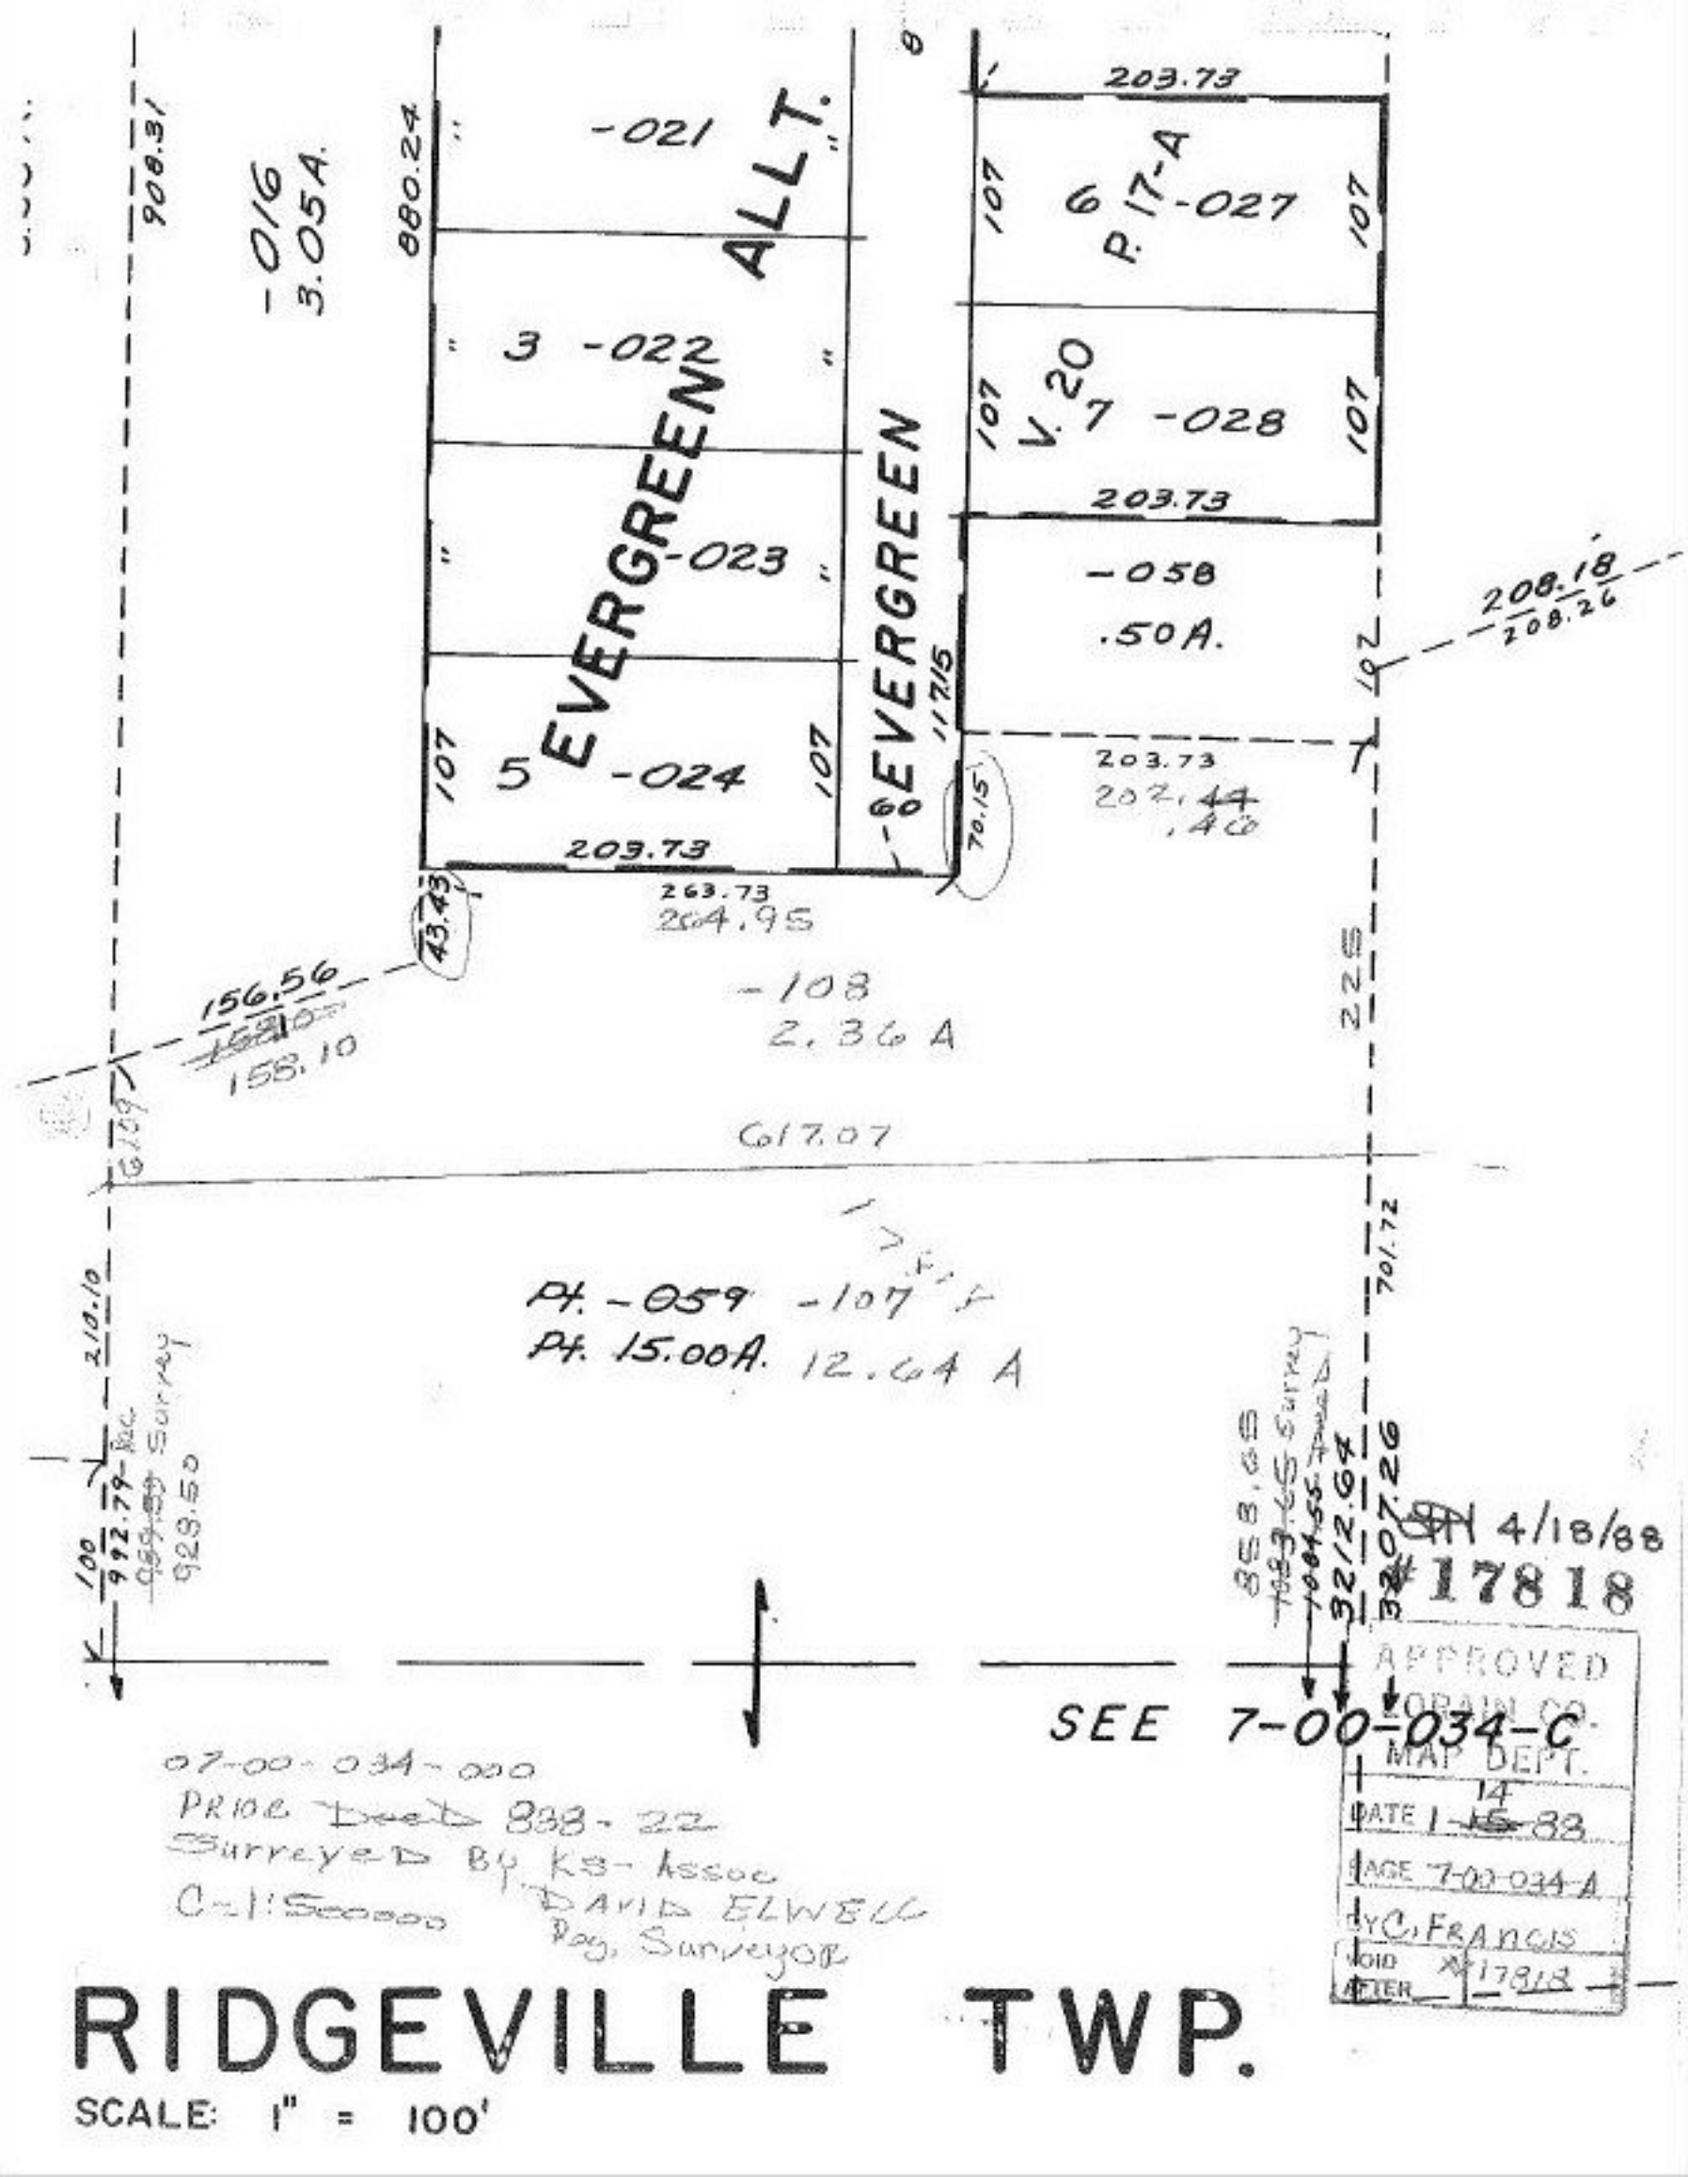

07-00-034-000
PRIOR Deed 888-22
Surveyed By KS-Assoc
C-1:50000
DAVID ELWELL
Reg. Surveyor

RIDGEVILLE TWP.

SCALE: 1" = 100'

4/18/88
#17818

APPROVED
LORAIN CO.
MAP DEPT.
DATE 1-15-88
PAGE 7-00-034-A
BY C. FRANCIS
VOID AFTER 17818