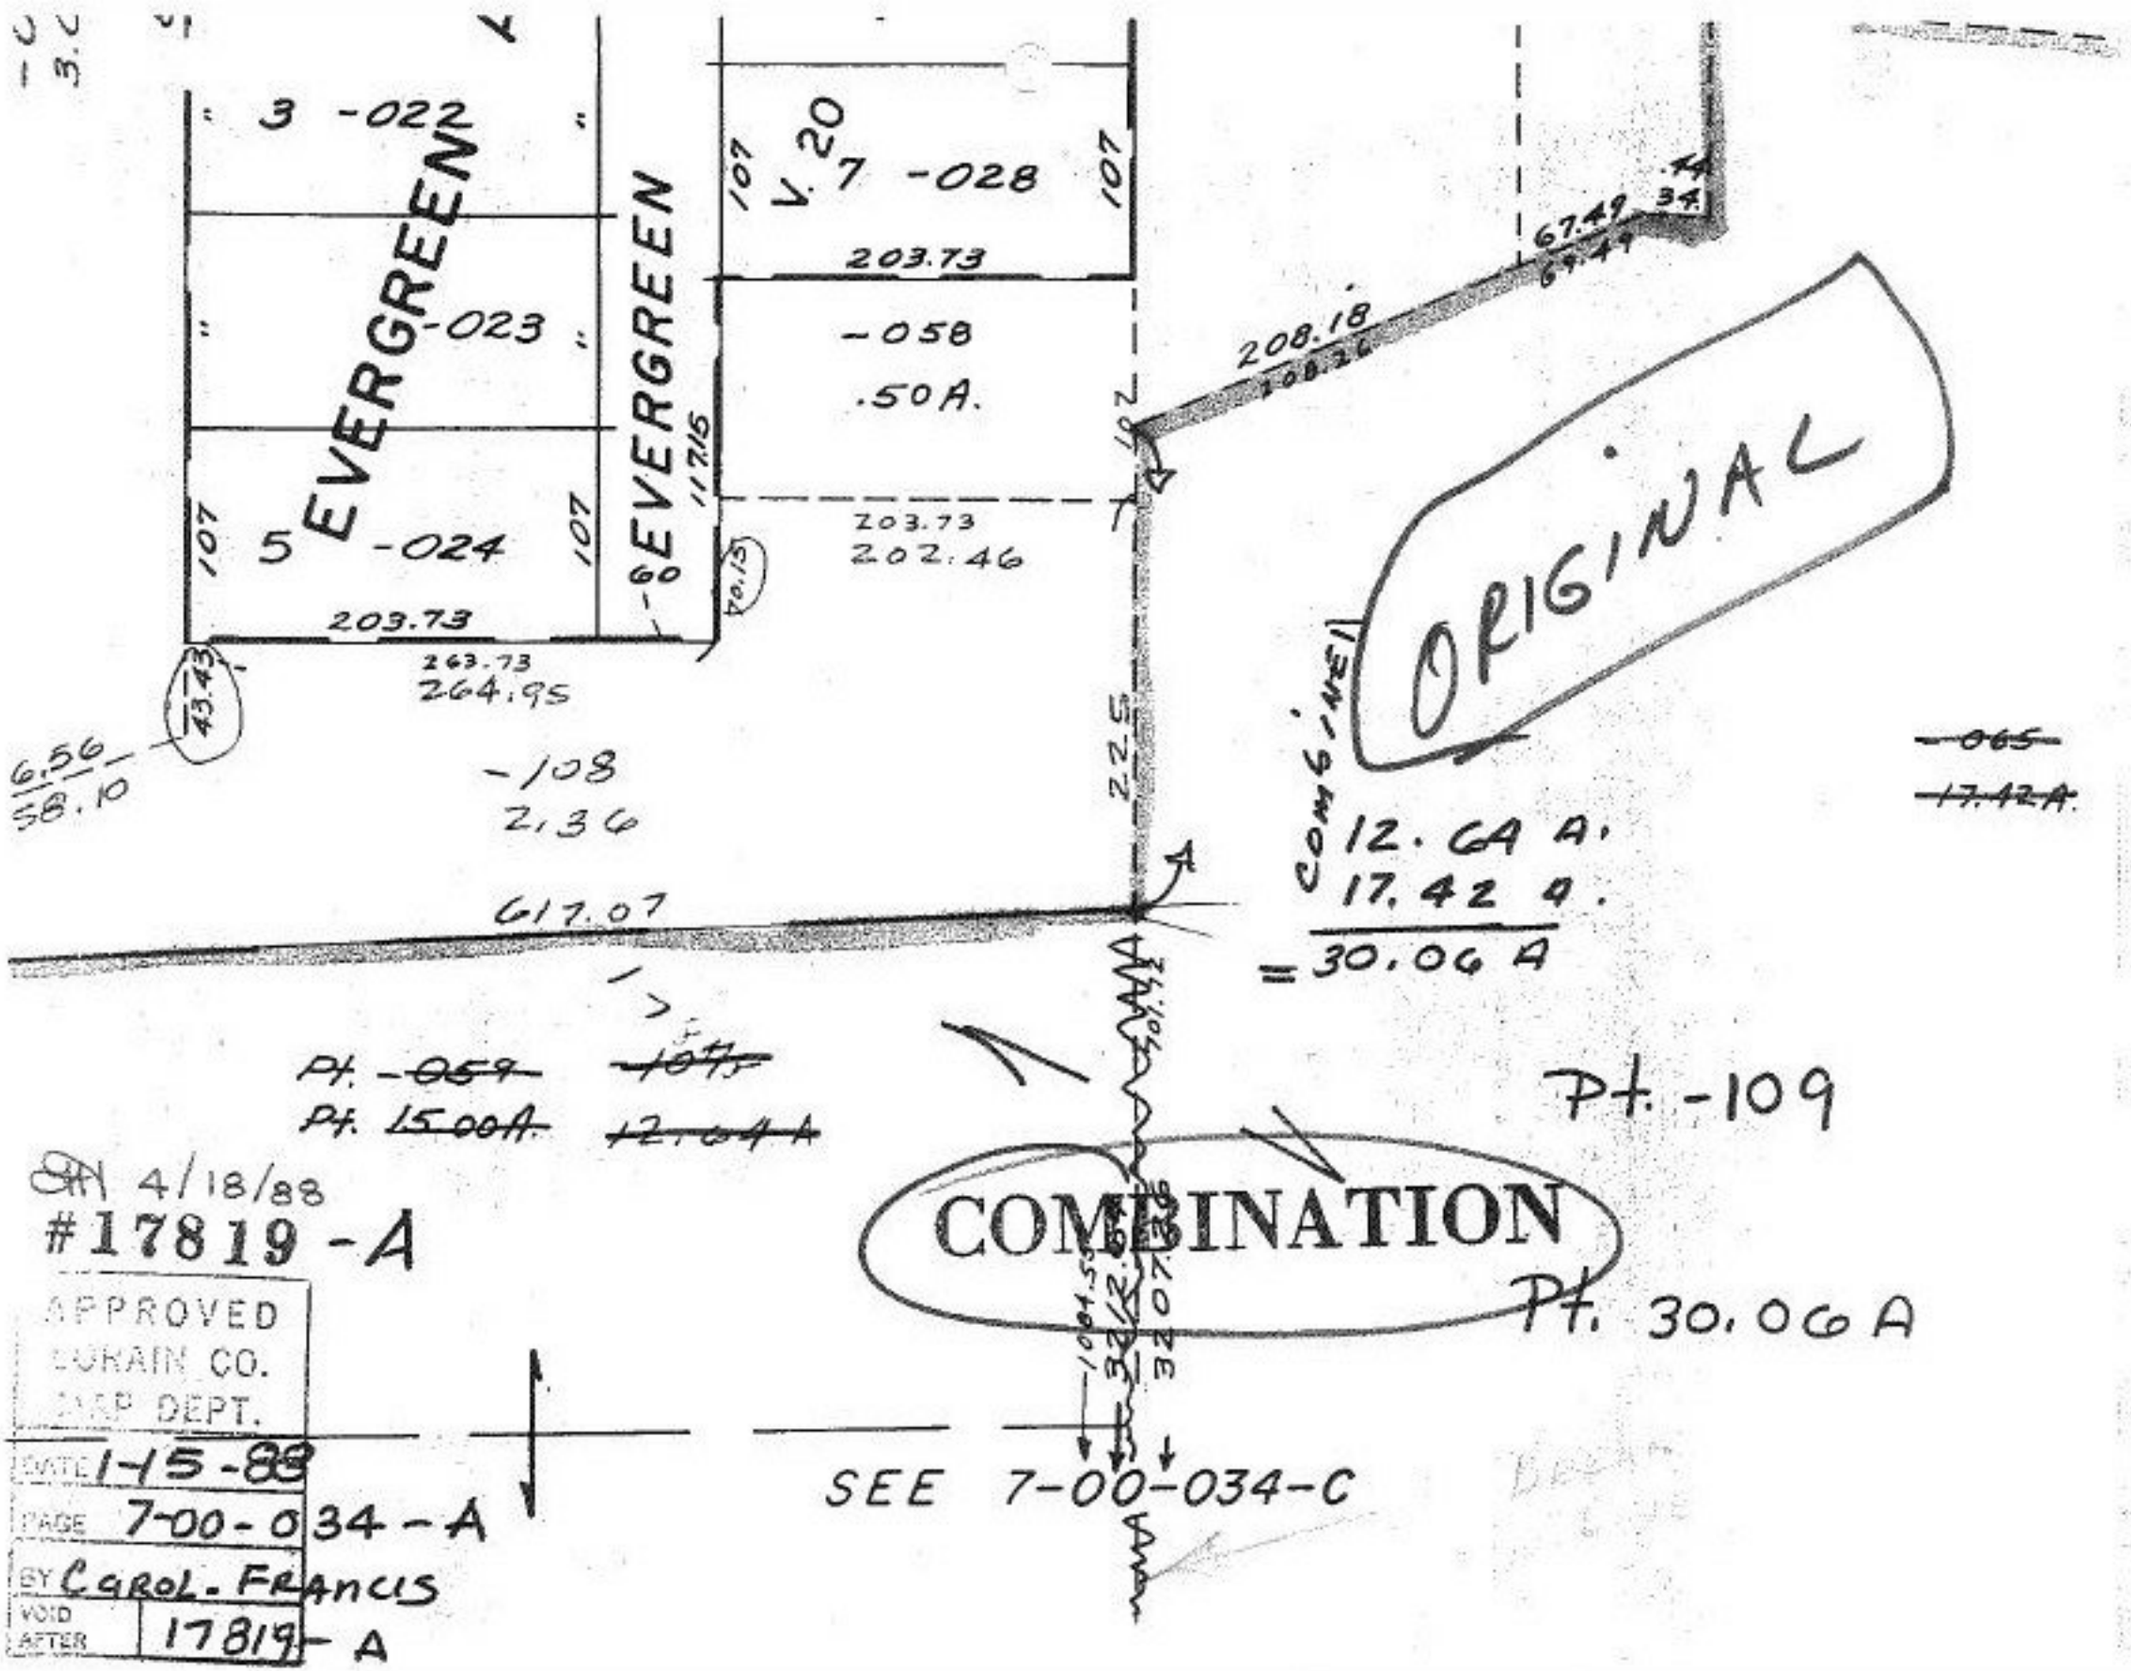
3-022
EVERGREEN
-023
5
-024
107
203.73
263.73
264.95
43.43
EVERGREEN
60
117.16
107
V. 20
7-028
107
203.73
-058
.50A.
203.73
202.46
208.18
67.49
34.
67.49
208.18
182
22.5
ORIGINAL
COMBINE
-065
17.42A.
12.64 A.
17.42 A.
=30.06 A
617.07
6.56
58.10
-108
2.36
Pt. -059
Pt. 15.00A.
-107-
12.64A
Pt. -109
4/18/88
#17819-A
COMBINATION
Pt. 30.06 A
SEE 7-00-034-C
APPROVED
LORAIN CO.
MAP DEPT.
DATE 1-15-88
PAGE 7-00-034-A
BY CAROL-FRANCIS
VOID AFTER 17819-A