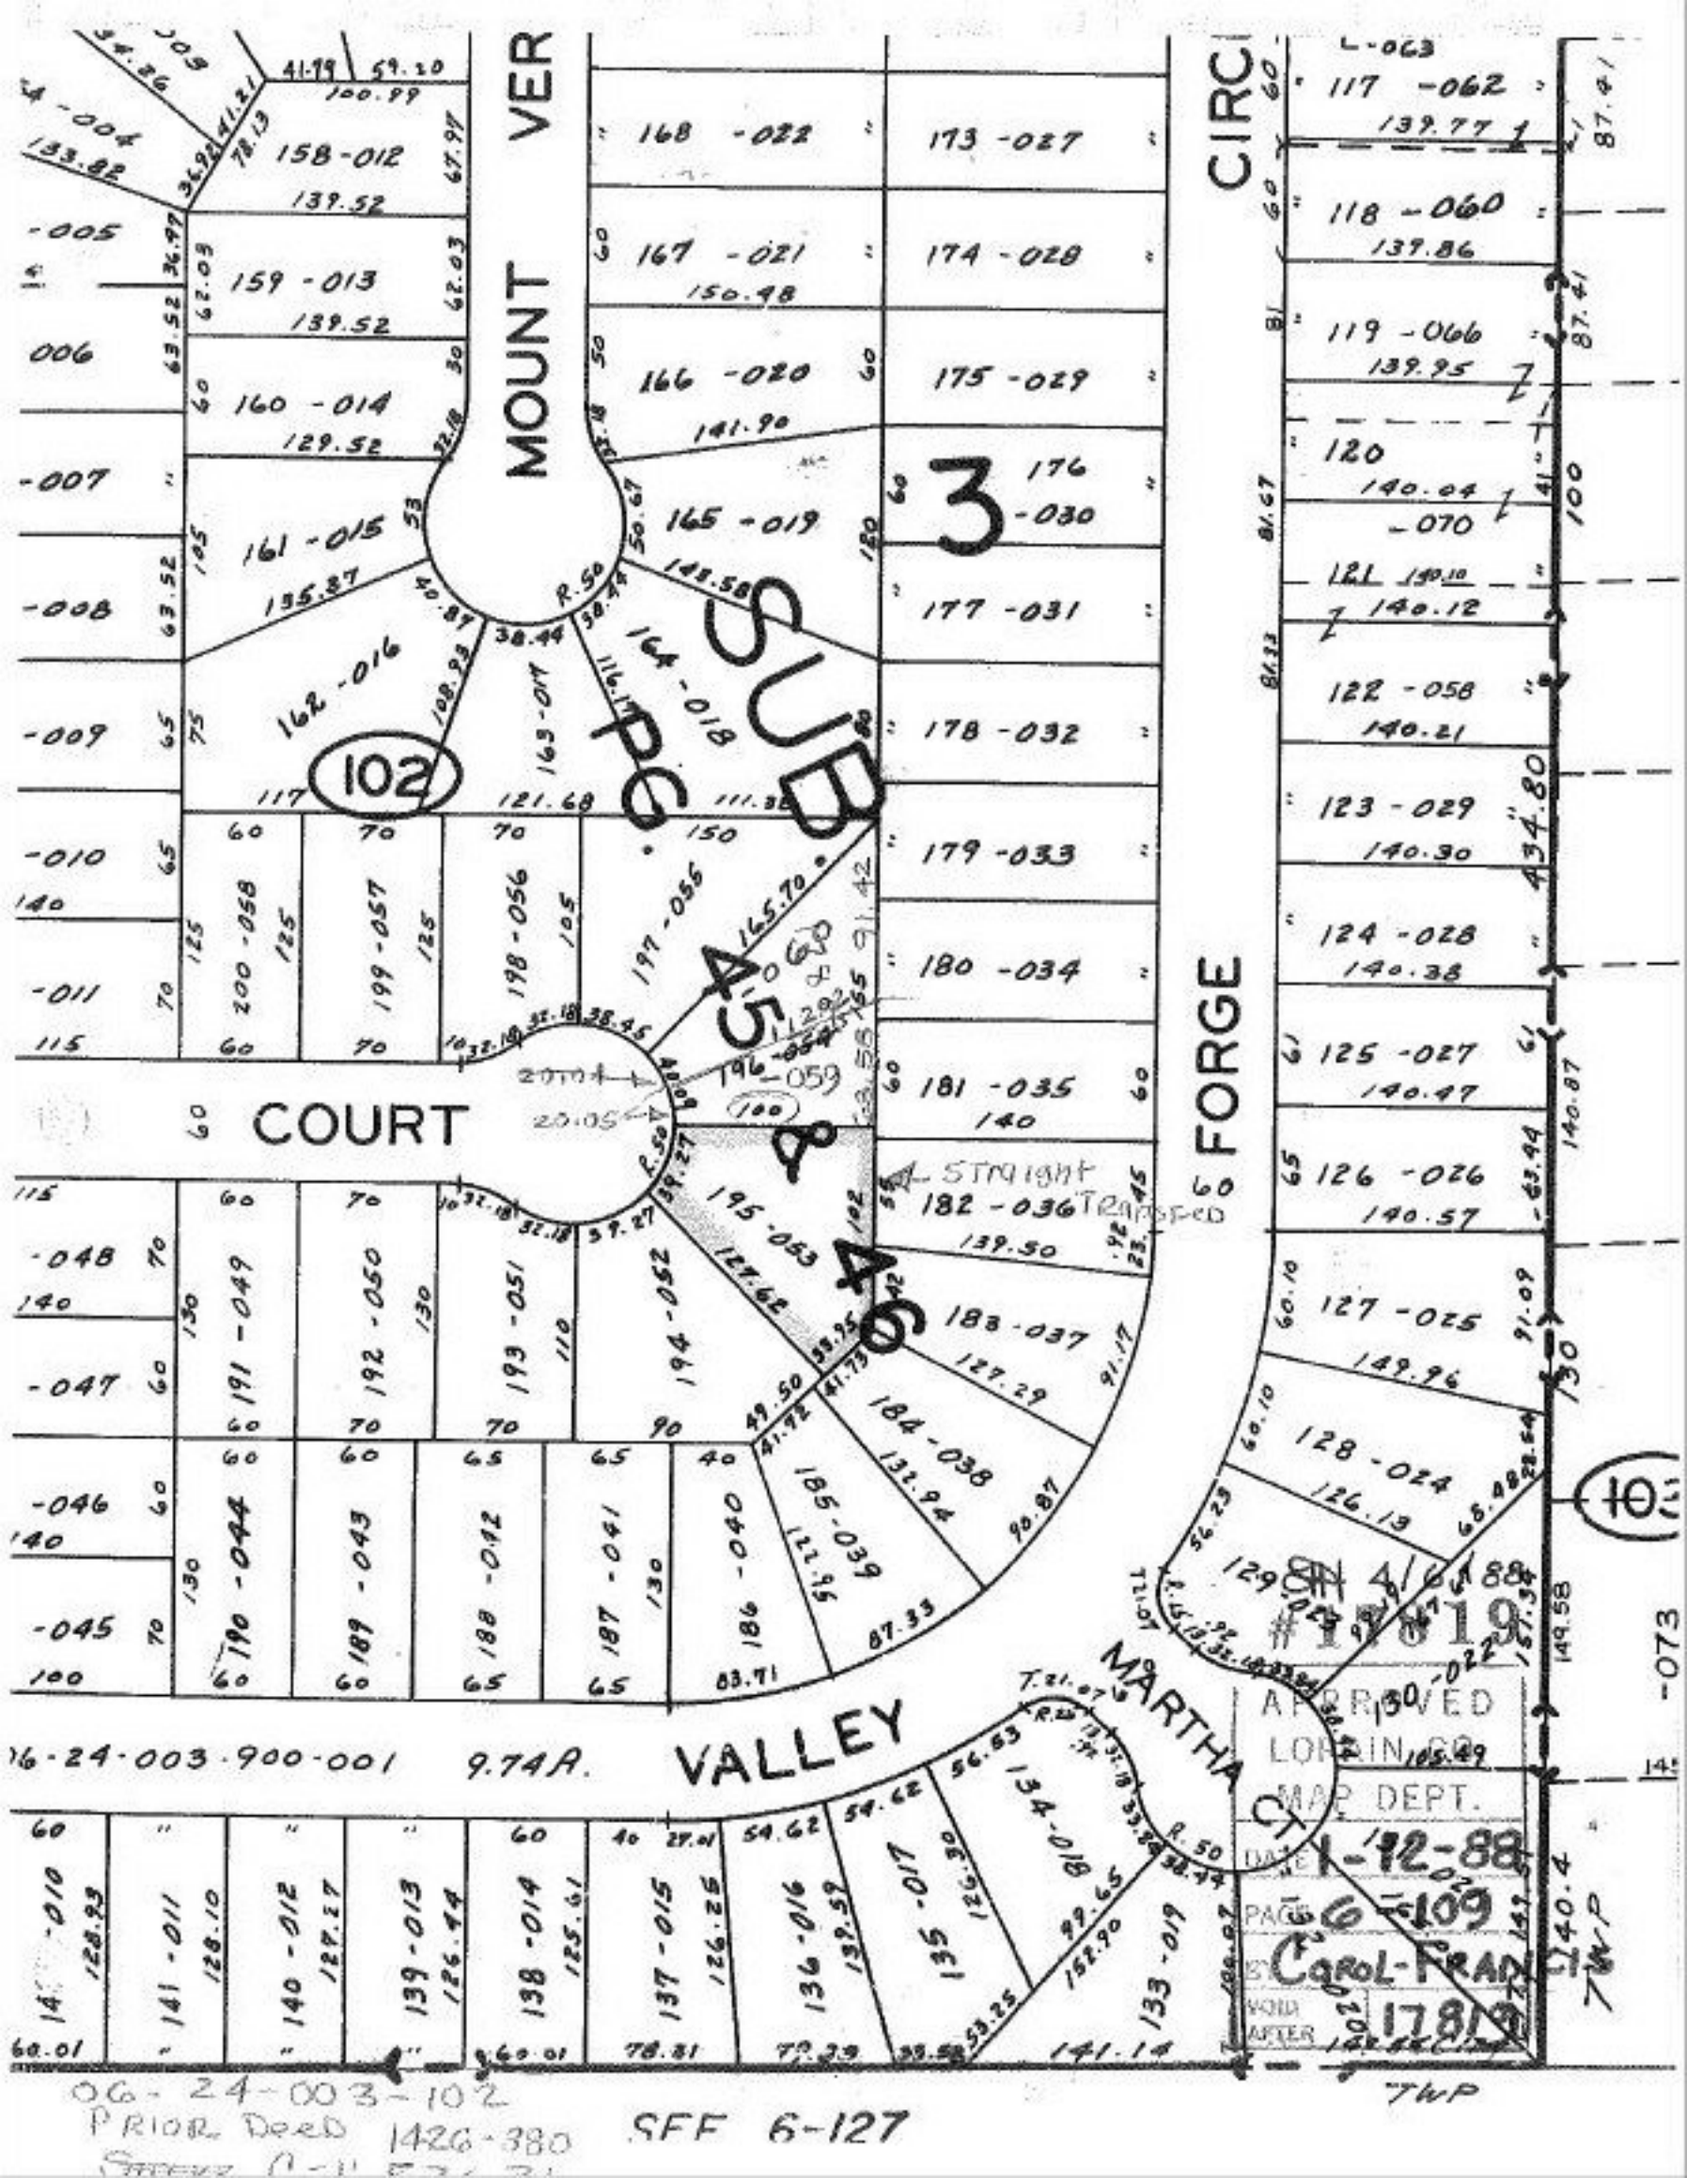
MOUNT VER
CIRC
SUB
PG. 45 & 46
3
102
COURT
FORGE
VALLEY
MARTHA CT
Straight Transfer
06-24-003-900-001 9.74A.
SN 4/6/88
#17819
APPROVED
LORAIN CO.
MAP DEPT.
DATE 1-12-88
PAGE 6-109
BY Carol-Francis
VOID AFTER 17819
TWP
06-24-003-102
PRIOR DEED 1426-380
SEE 6-127