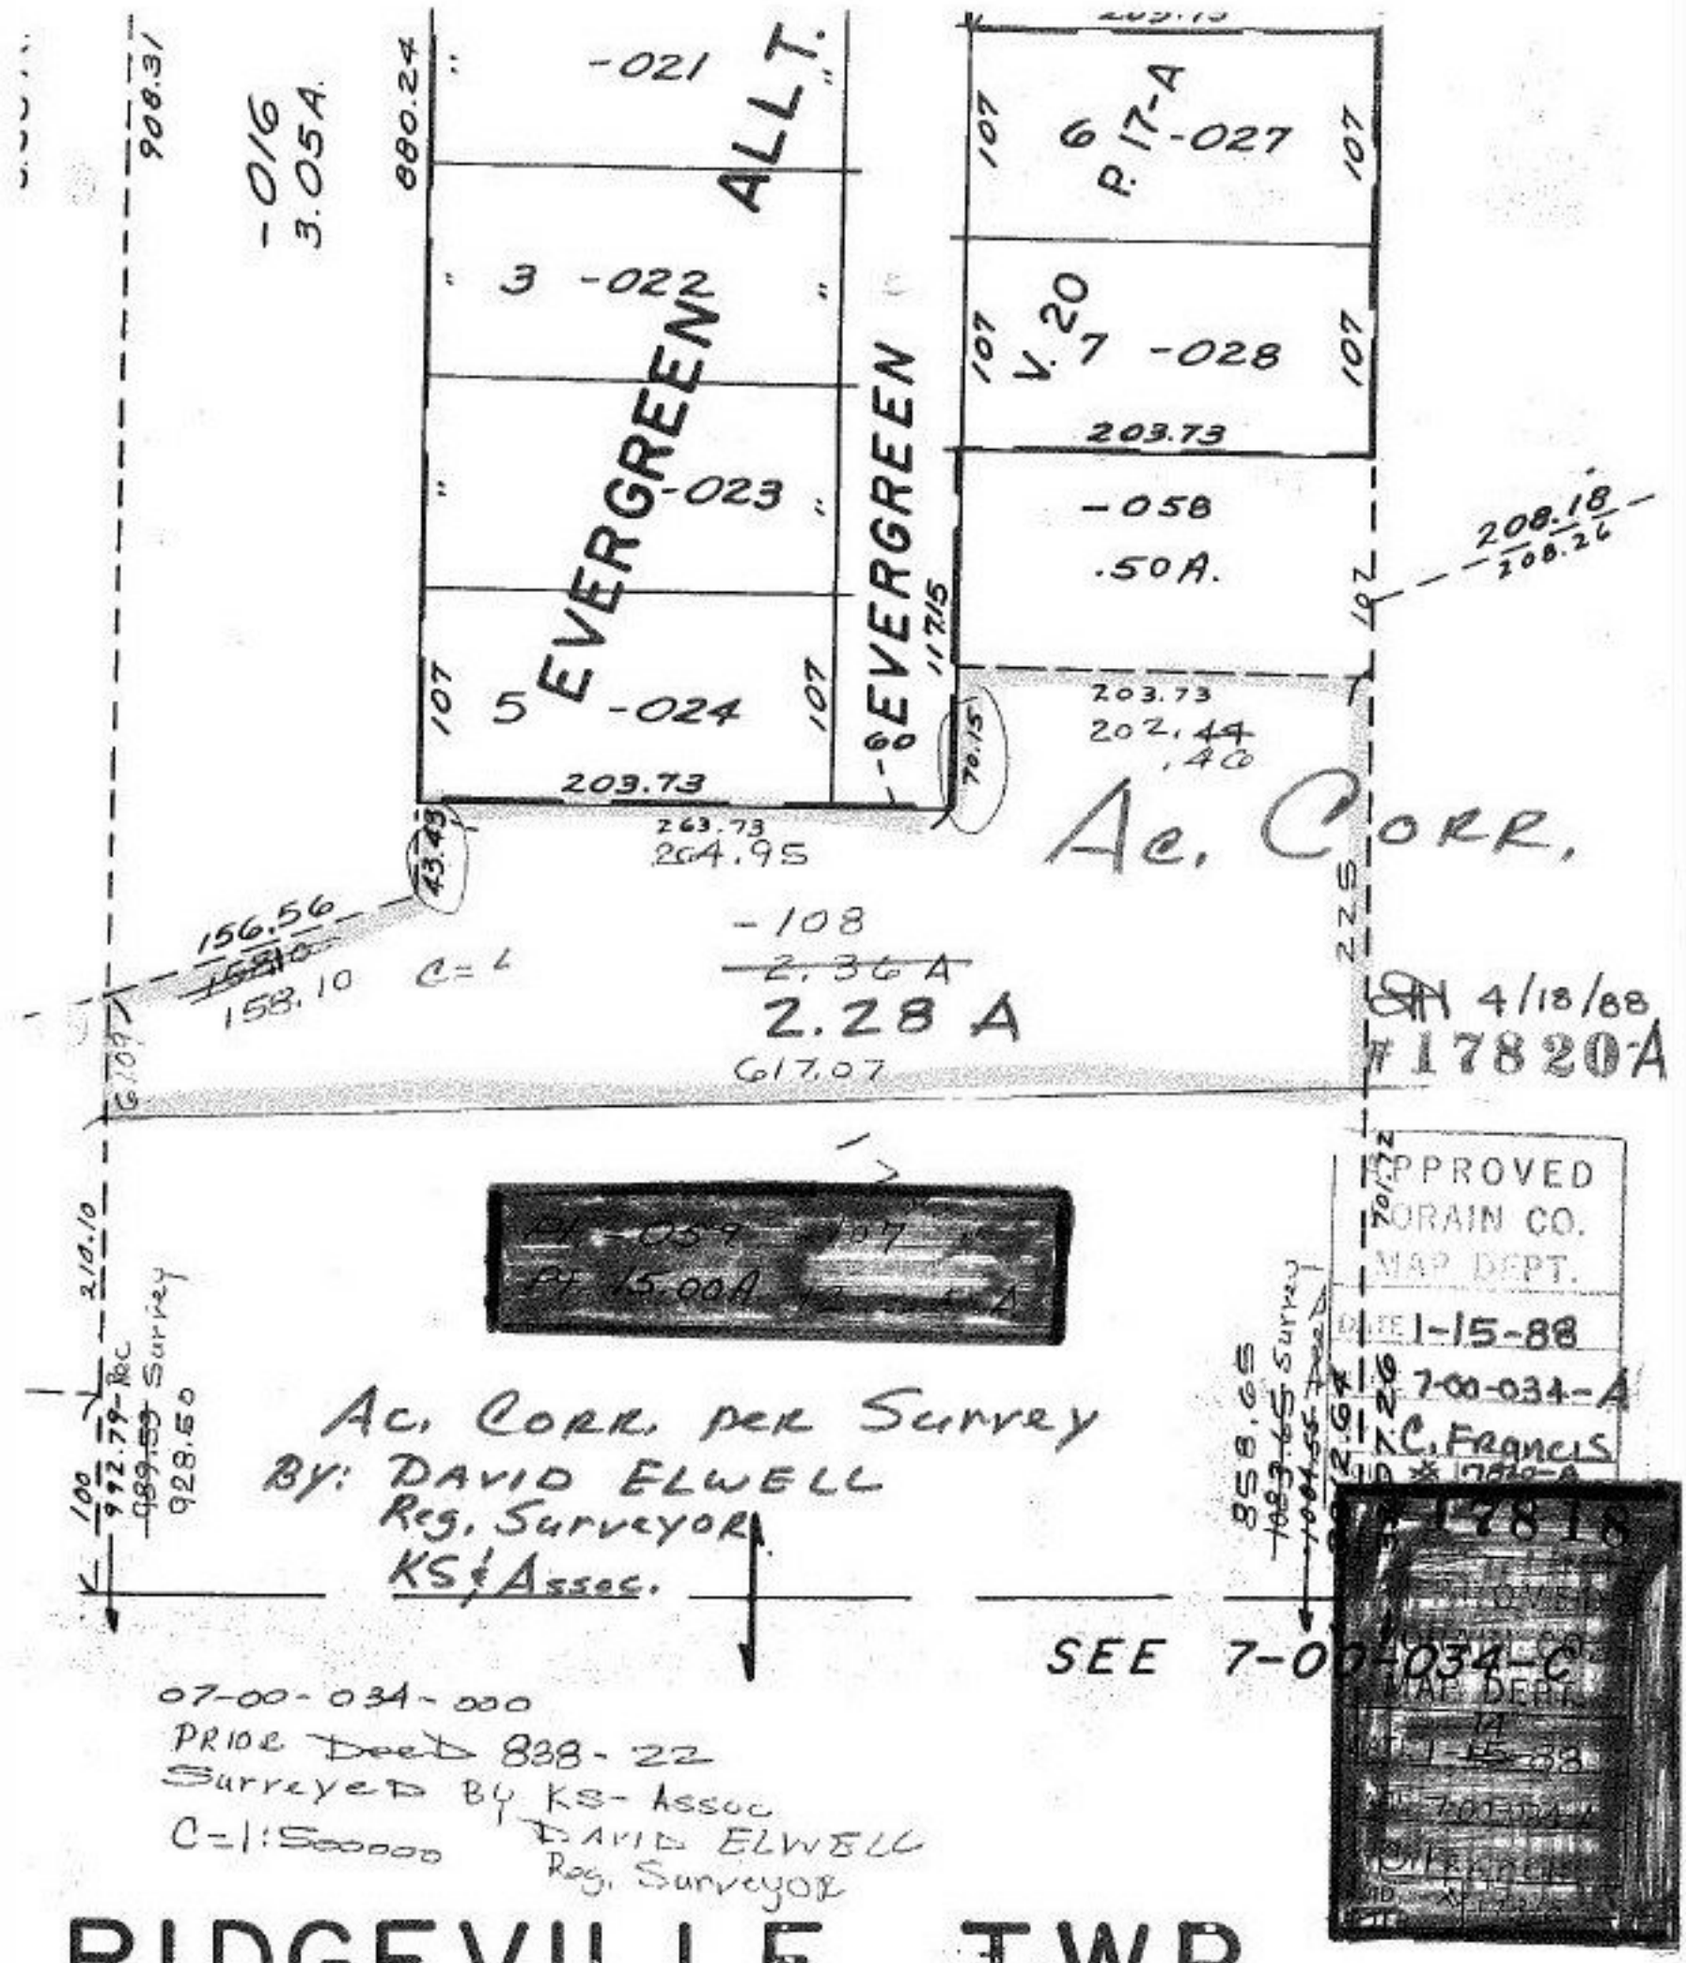

07-00-034-000
PRIOR Deed 838-22
Surveyed By KS-Assoc
C=1:500000
David Elwell
Reg. Surveyor

RIDGEVILLE TWP.

SCALE: 1" = 100'