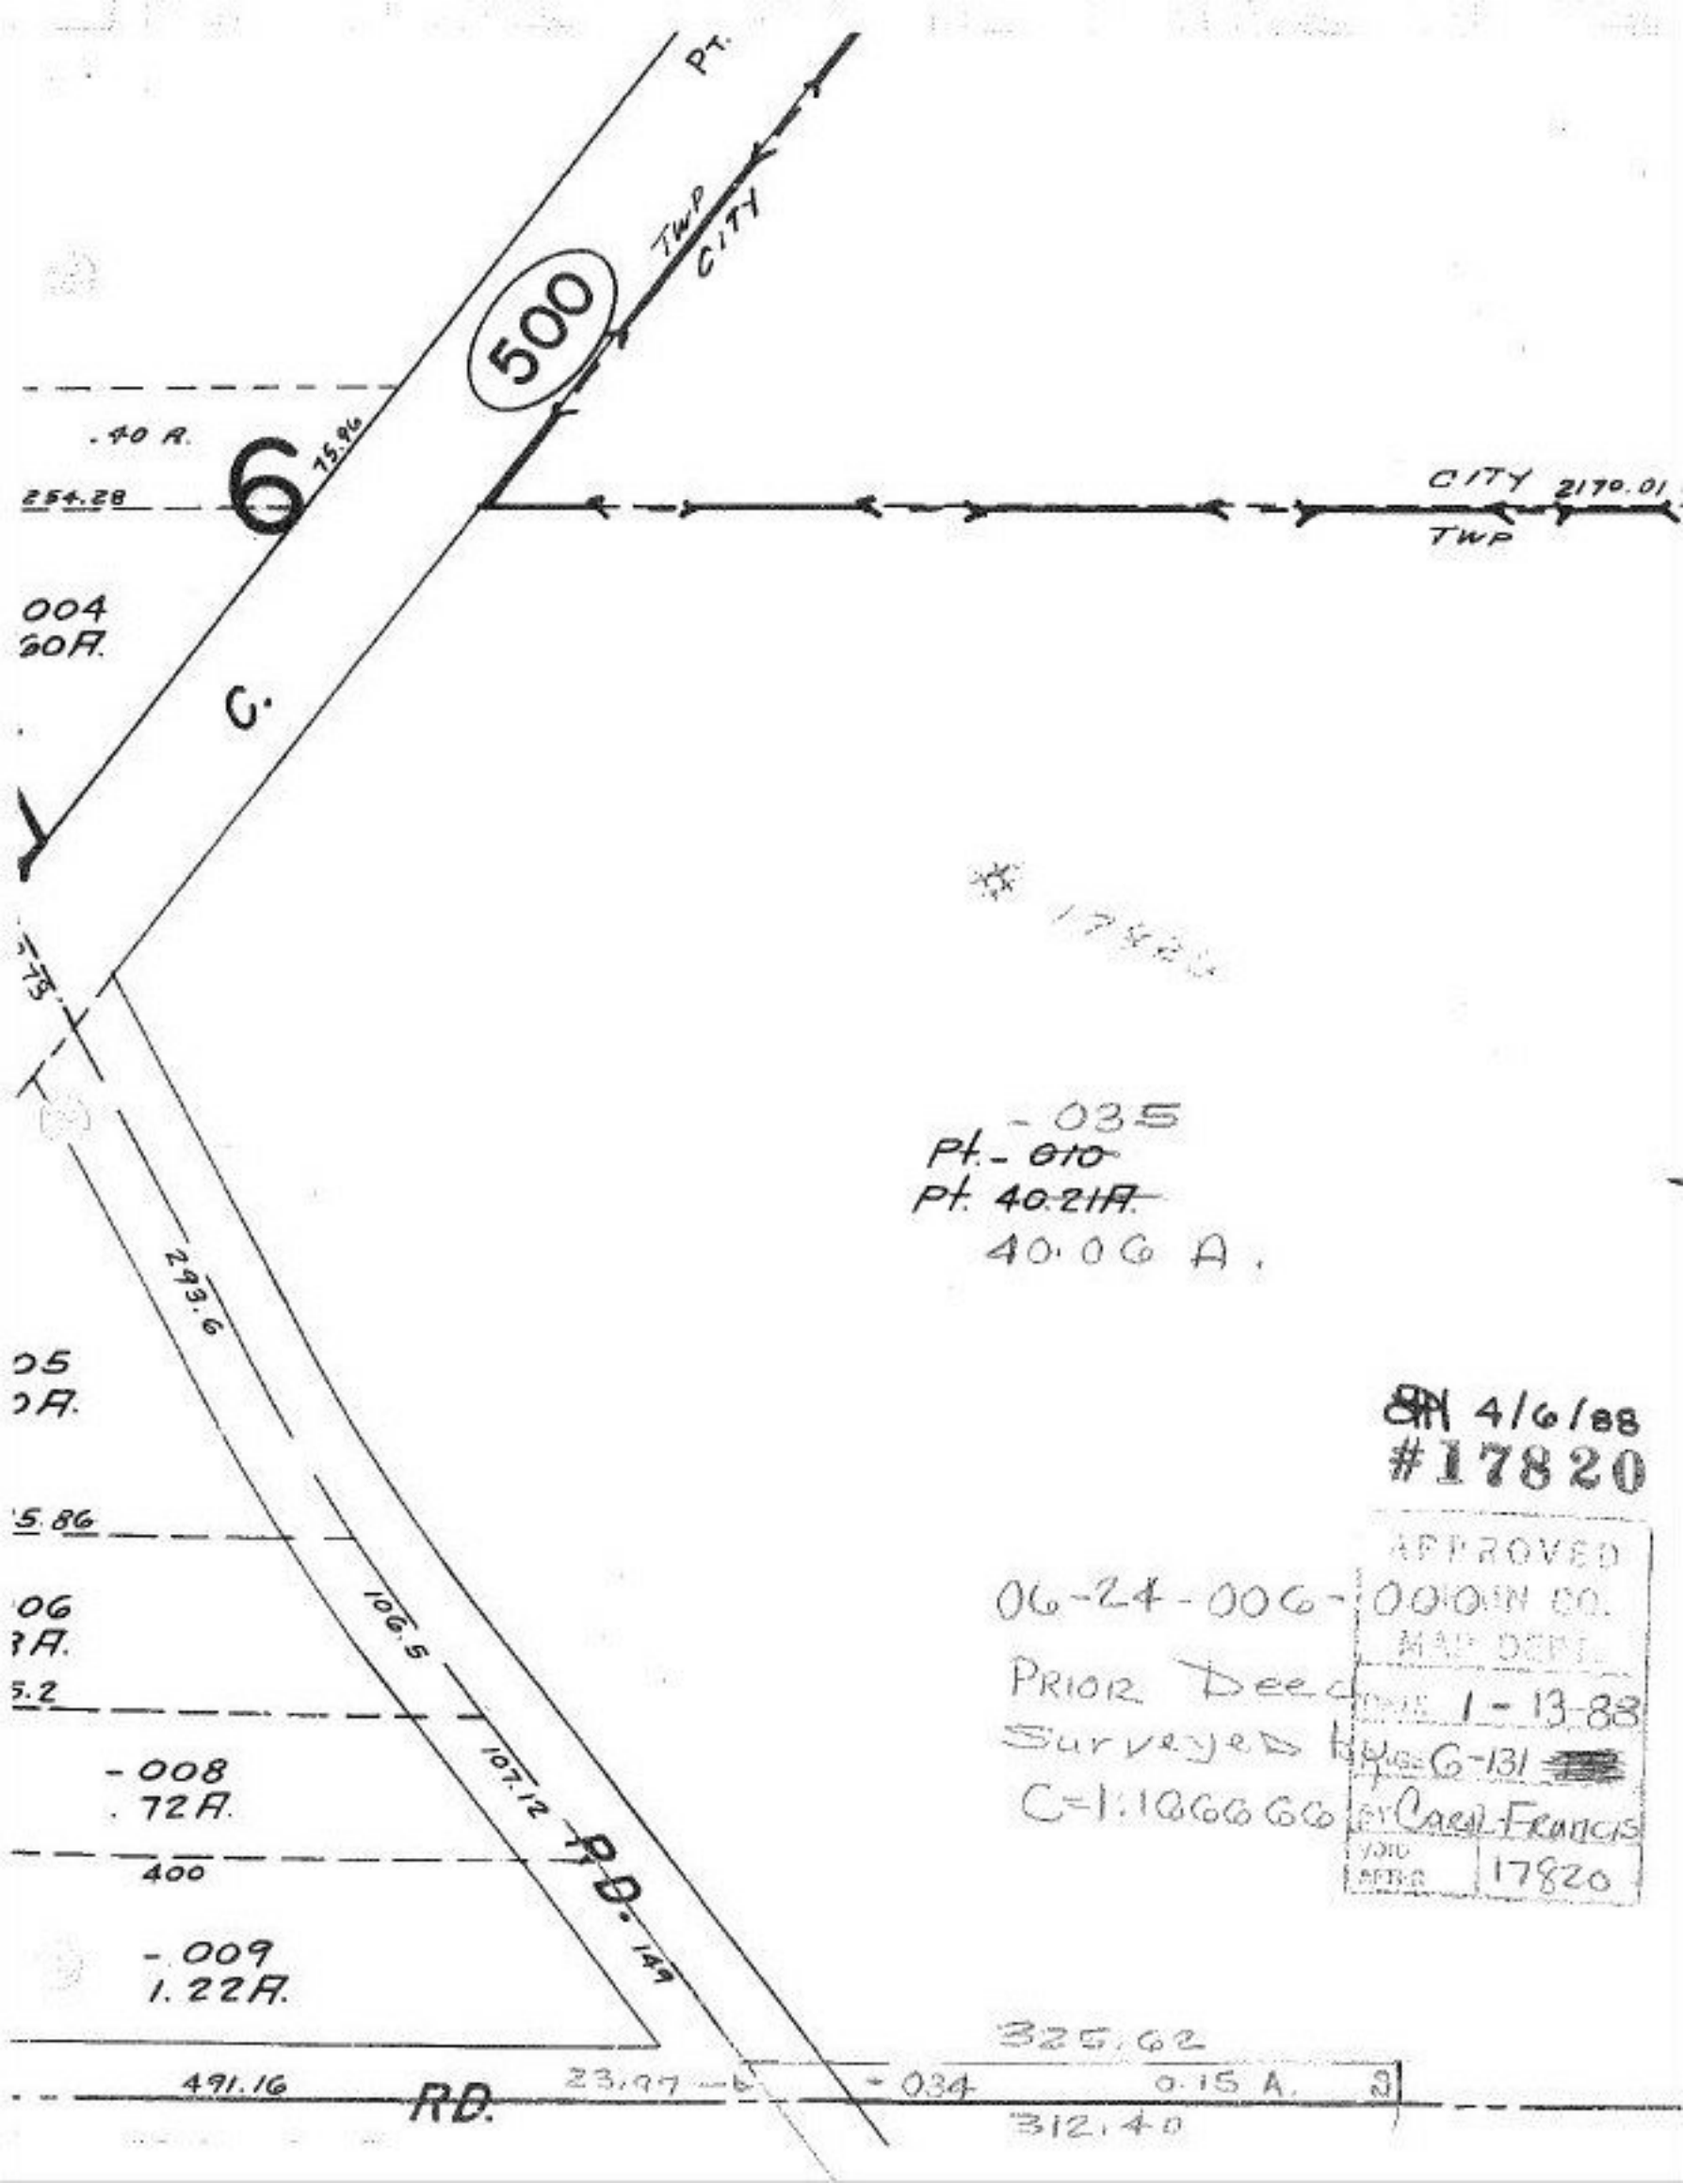

PT.
TWP
CITY
500
.40 A.
6
75.96
254.28
CITY
2170.01
TWP
004
60A.
C.
-035
Pt.- ~~010~~
Pt. ~~40.21A.~~
40.06 A.
293.6
05
0A.
5.86
06
3A.
5.2
106.5
107.12
-008
.72A.
400
R.D.
149
-.009
1.22A.
325.62
491.16
RD.
23.97
-034
0.15 A.
312.40
4/6/88
#17820
06-24-006-
PRIOR Deed
Surveyed by
C=1:1066666
APPROVED
MAP DEPT.
DATE 1-13-88
PAGE 6-131
BY Carol Francis
17820