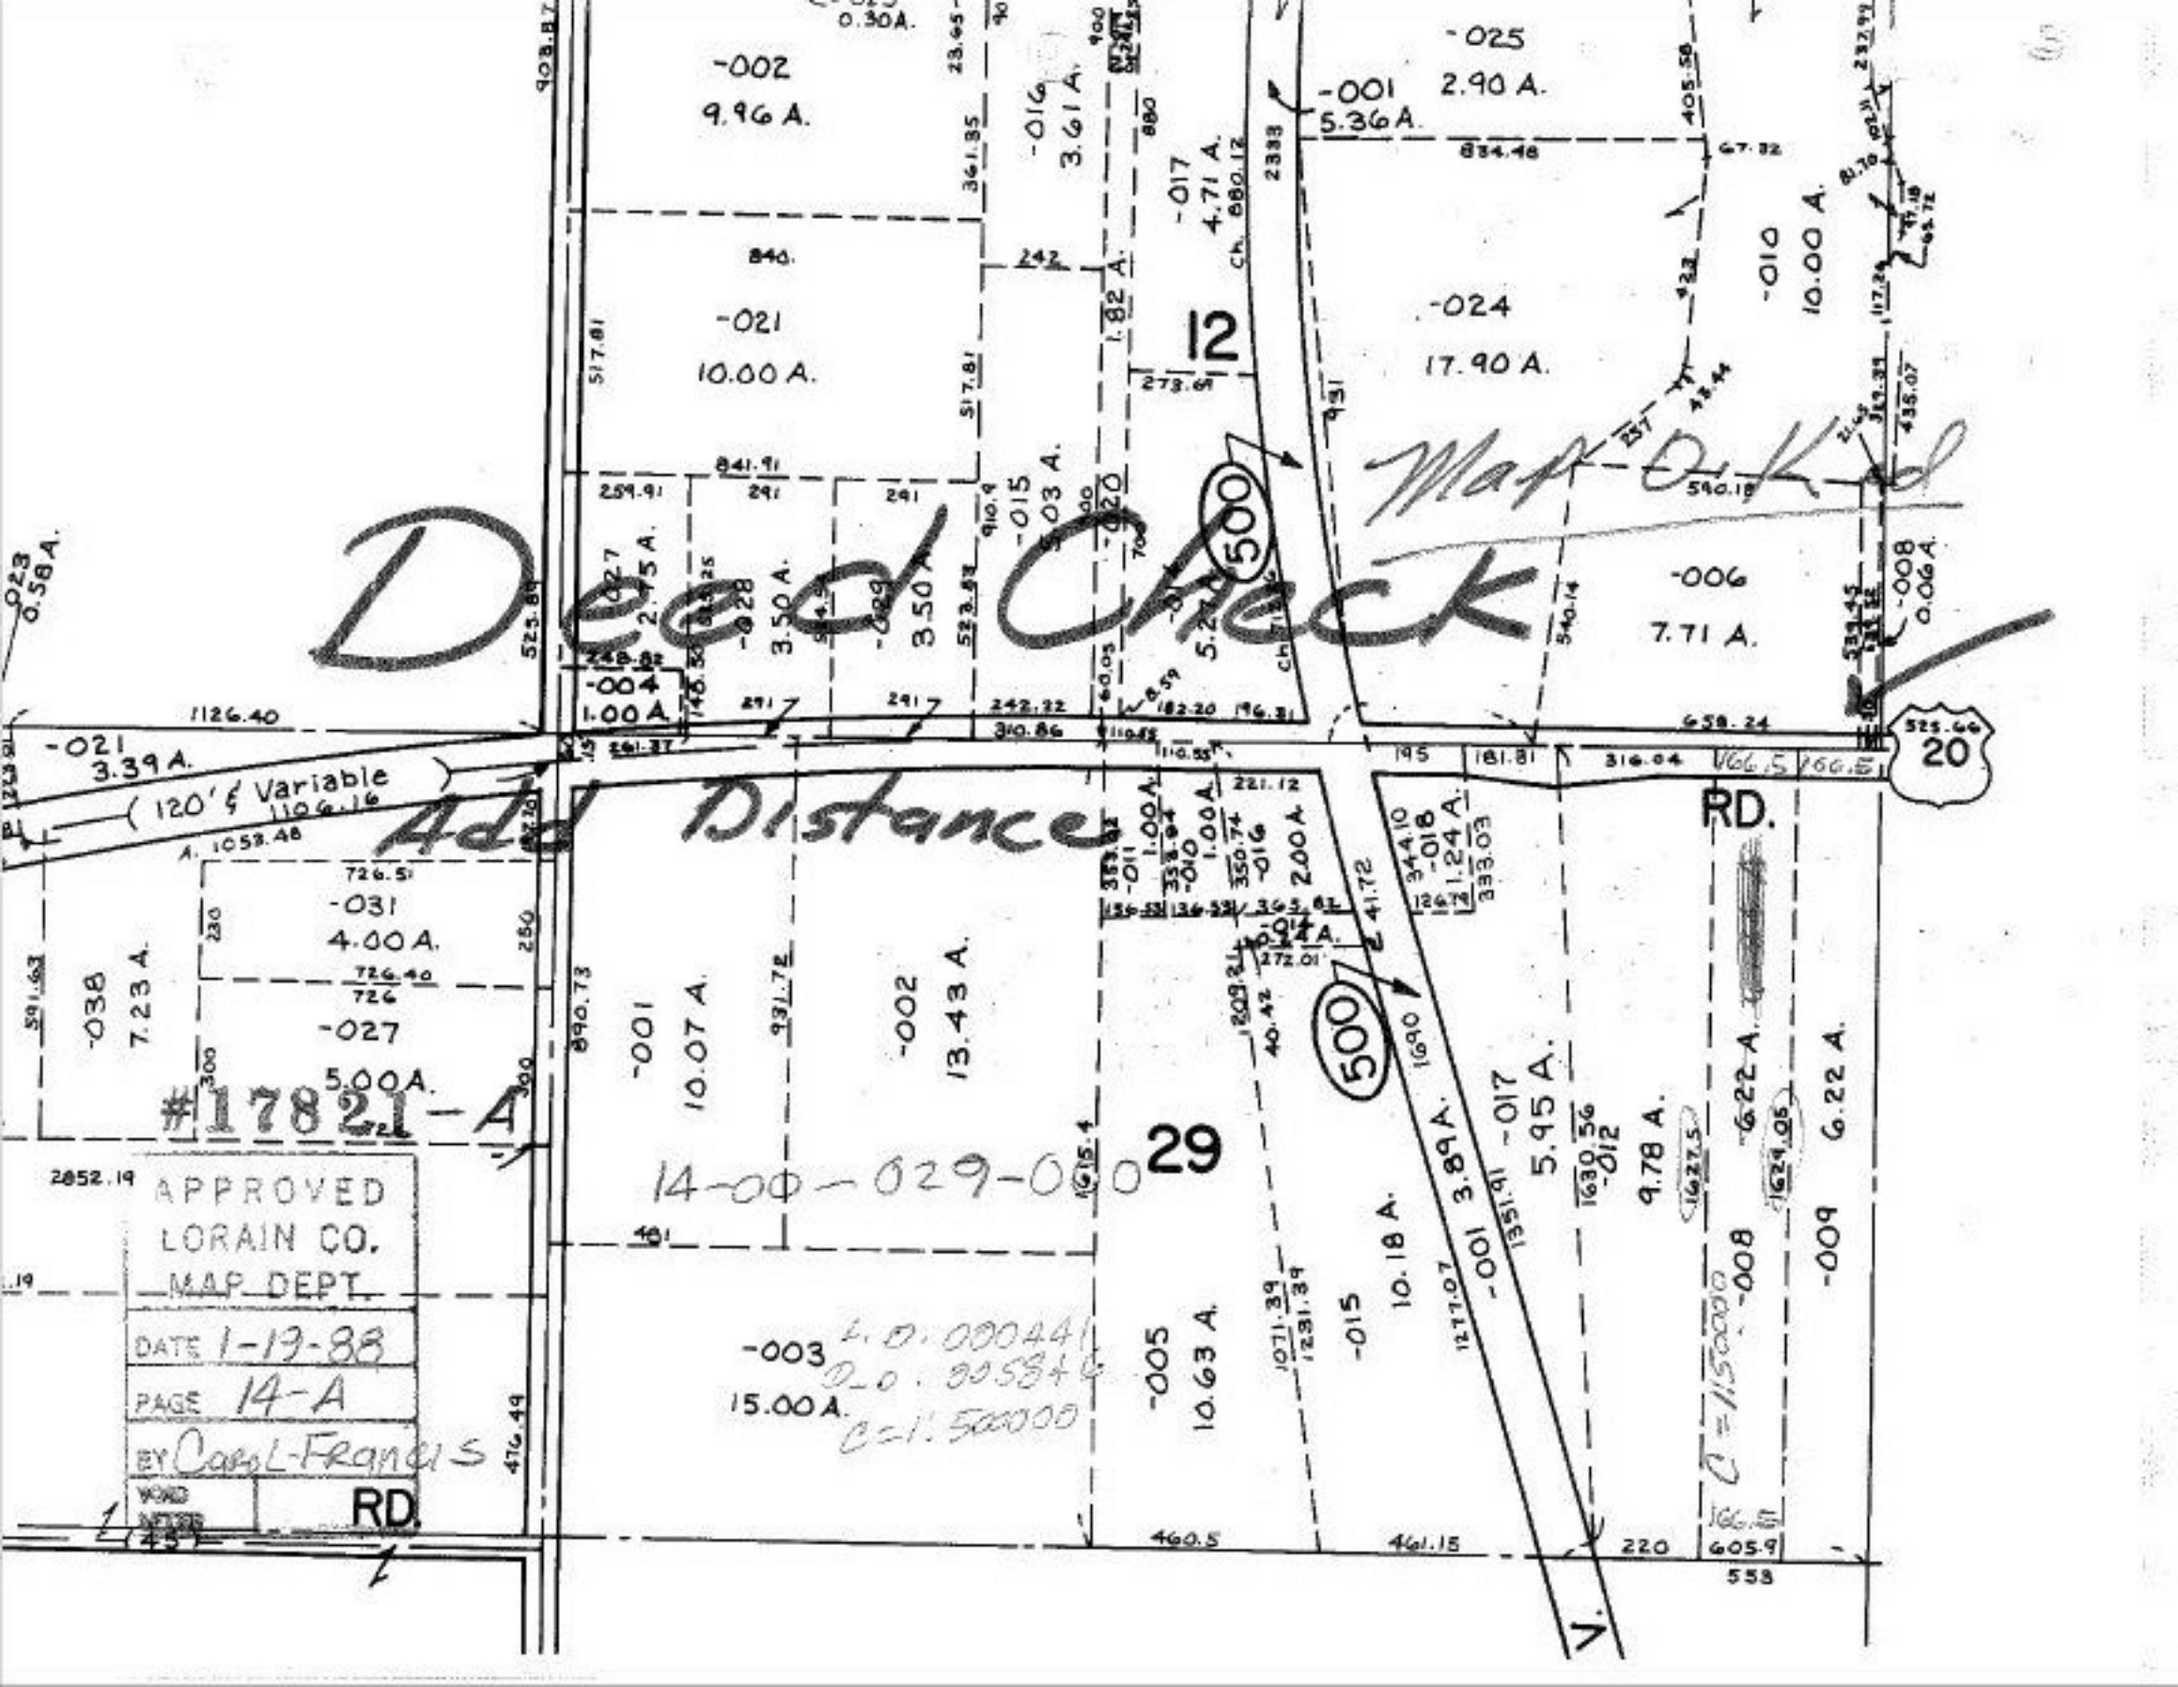
Deed Check
Map O.K.
Add Distance
#17821-A
14-00-029-000
APPROVED
LORAIN CO.
MAP DEPT.
DATE 1-19-88
PAGE 14-A
BY Carol Francis
RD.
12
29
20
500
-002
9.96 A.
-021
10.00 A.
-025
2.90 A.
-001
5.36 A.
-024
17.90 A.
-010
10.00 A.
-006
7.71 A.
-008
0.06 A.
-004
1.00 A.
-021
3.39 A.
120' & Variable
-031
4.00 A.
-027
5.00 A.
-038
7.23 A.
-001
10.07 A.
-002
13.43 A.
-003
15.00 A.
-005
10.63 A.
-015
10.18 A.
-017
5.95 A.
-012
9.78 A.
-008
6.22 A.
-009
6.22 A.
-001
3.89 A.
-016
3.61 A.
-017
4.71 A.
-015
5.03 A.
-020
1.82 A.
-028
3.50 A.
-029
3.50 A.
-027
2.75 A.
-011
1.00 A.
-010
1.00 A.
-016
2.00 A.
-018
1.24 A.
-014
0.24 A.
-023
0.58 A.
C=1:500000
C=1:150000