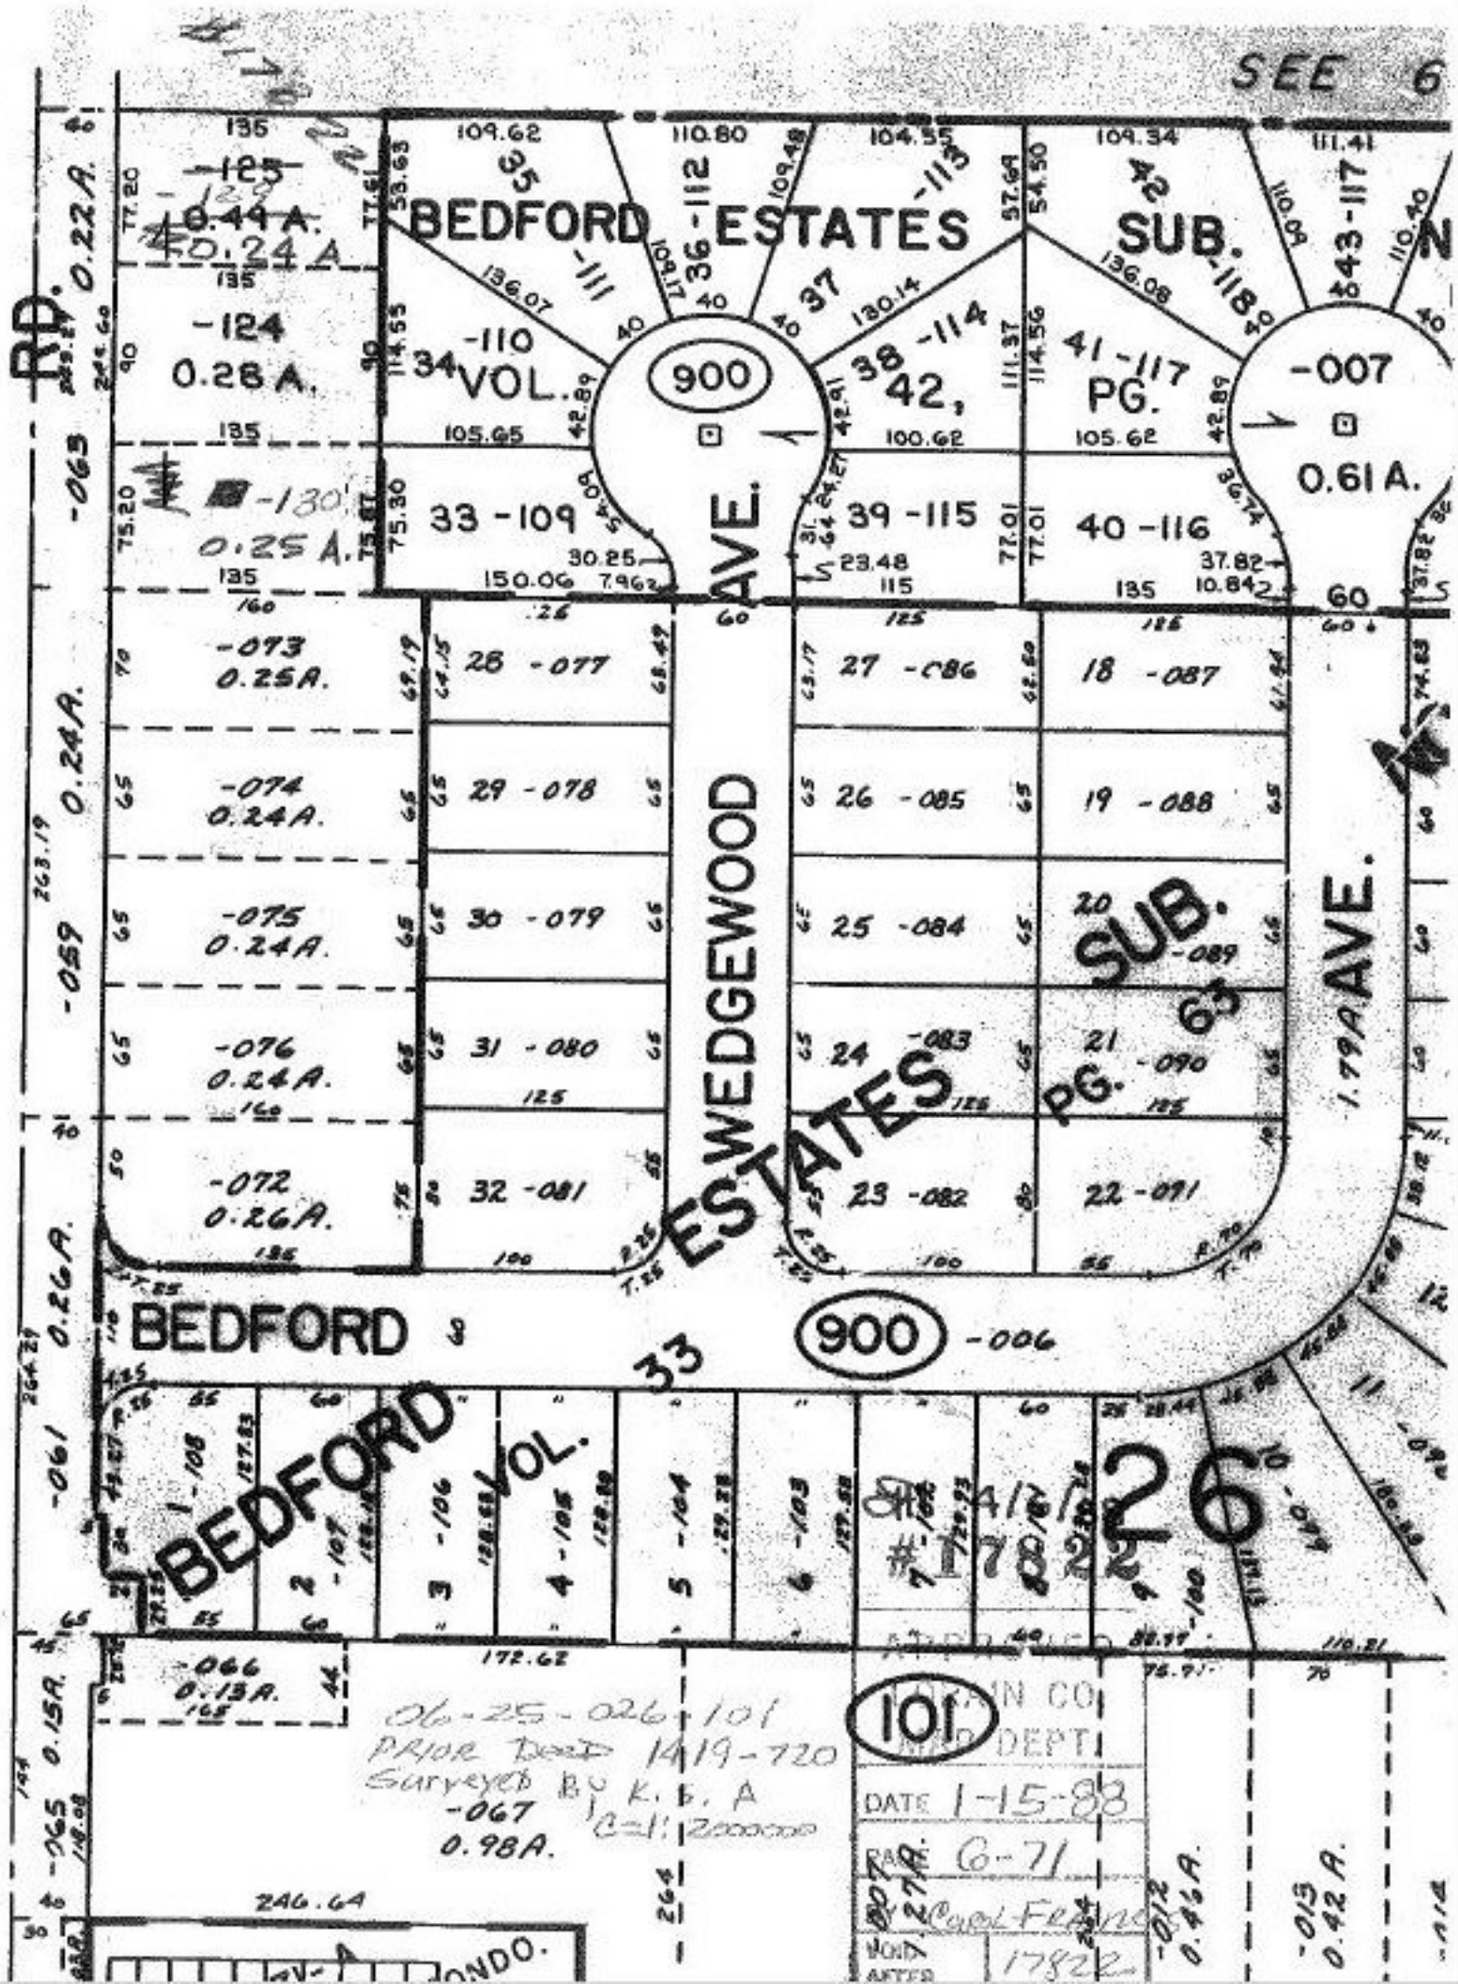
SEE 6
BEDFORD ESTATES SUB.
VOL. 34 PG. 42
900
WEDGEWOOD AVE.
ESTATES SUB. PG. 63
AVE.
BEDFORD
BEDFORD VOL. 33
900 -006
RD.
-125 0.49 A.
-124 0.28 A.
-130 0.25 A.
-073 0.25A.
-074 0.24A.
-075 0.24A.
-076 0.24A.
-072 0.26A.
-066 0.13A.
-067 0.98A.
-007 0.61 A.
-063 0.22A.
-059 0.24A.
-061 0.26A.
-065 0.15A.
-012 0.46A.
-013 0.42 A.
1.79A
26
101
06-25-026-101
PRIOR DEED 1419-720
Surveyed BY K. S. A
C=1:2000000
APPROVED
LORAIN CO
MAP DEPT.
DATE 1-15-88
PAGE 6-71
BY Carol Frame
17822