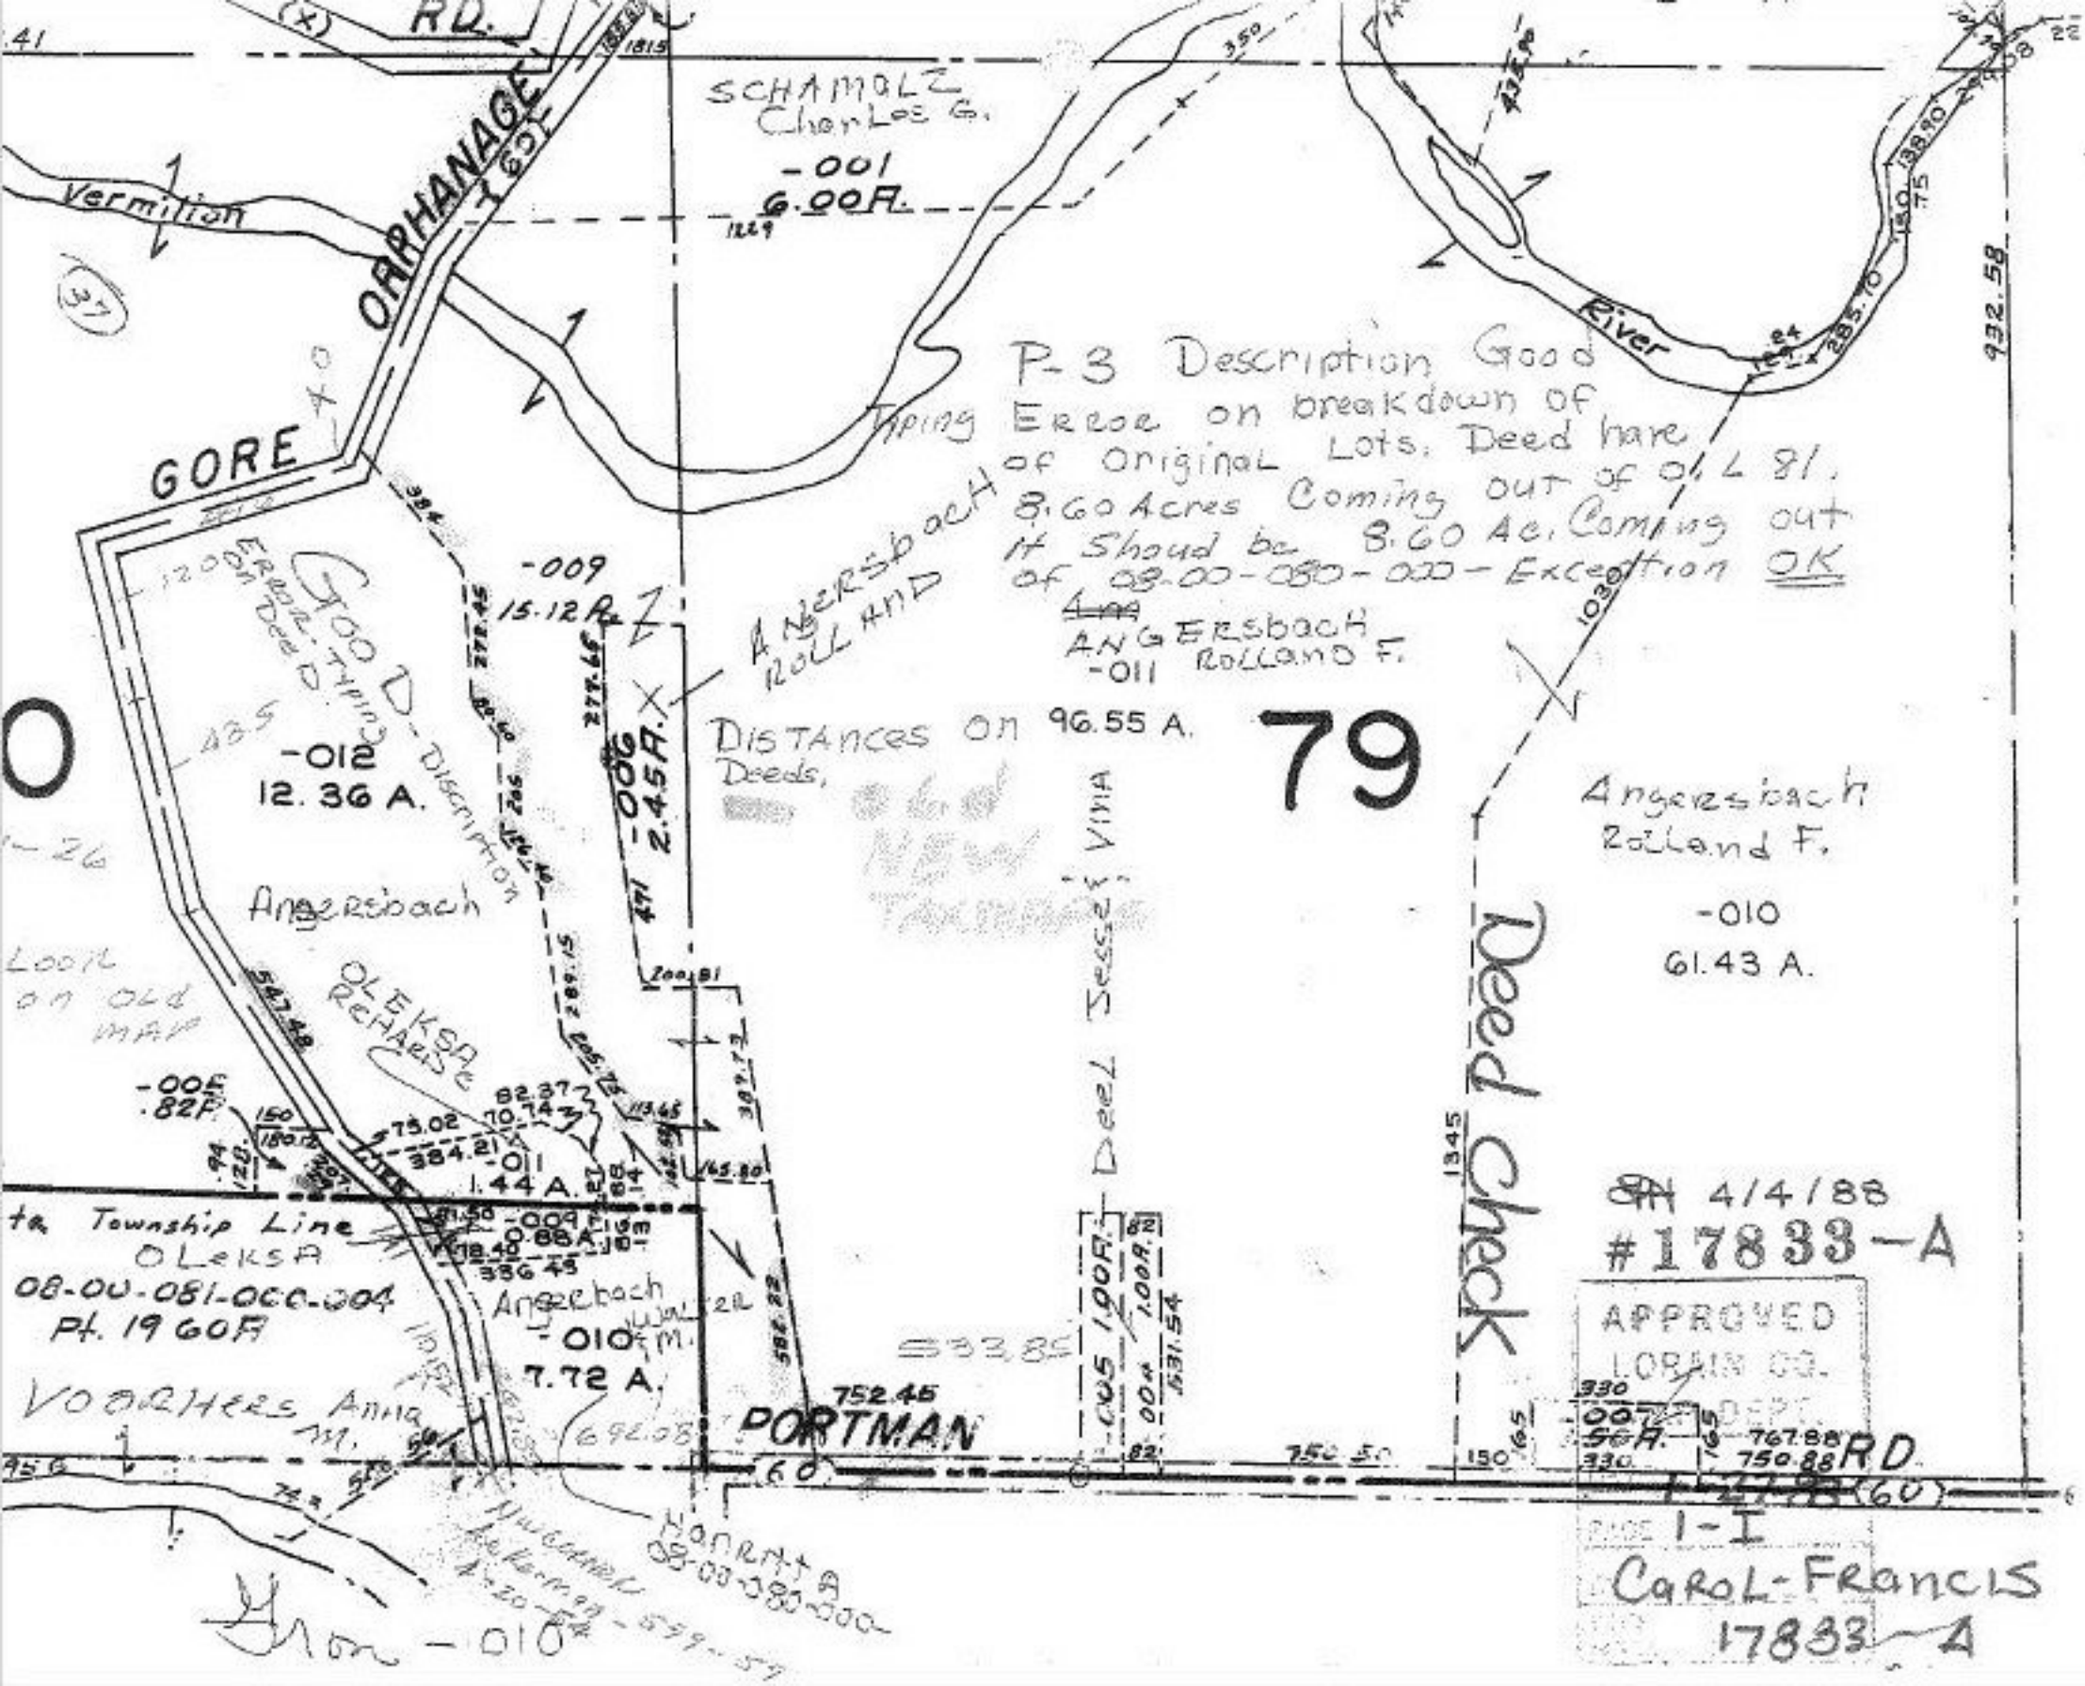
RD.
ORRHANAGE
Vermilion
SCHAMALZ
Charles G.
-001
6.00 A.
River
P-3 Description Good
Typing Error on breakdown of
Angersbach of Original Lots. Deed have
8.60 Acres Coming out of 01 L 81.
It Should be 8.60 Ac. Coming out
of 08-00-080-000-Exception OK
ANGERSBACH
-011 Rolland F.
GORE
GOOD DESCRIPTION
Error on Deed
-009
15.12 A.
-012
12.36 A.
Angersbach
Rolland
-006
2.45 A.
DISTANCES ON 96.55 A.
Deeds,
79
Angersbach
Rolland F.
-010
61.43 A.
Deed Check
Deed Jessee Vina
OLEKSA
-005
.82 A.
-011
1.44 A.
-009
0.88 A.
Township Line
OLEKSA
08-00-081-000-004
Pt. 19 60 A
Angersbach
-010
7.72 A.
VOORHEES Anna M.
PORTMAN
RD
4/4/88
#17833-A
APPROVED
LORAIN CO.
DEPT.
CAROL-FRANCIS
17833-A