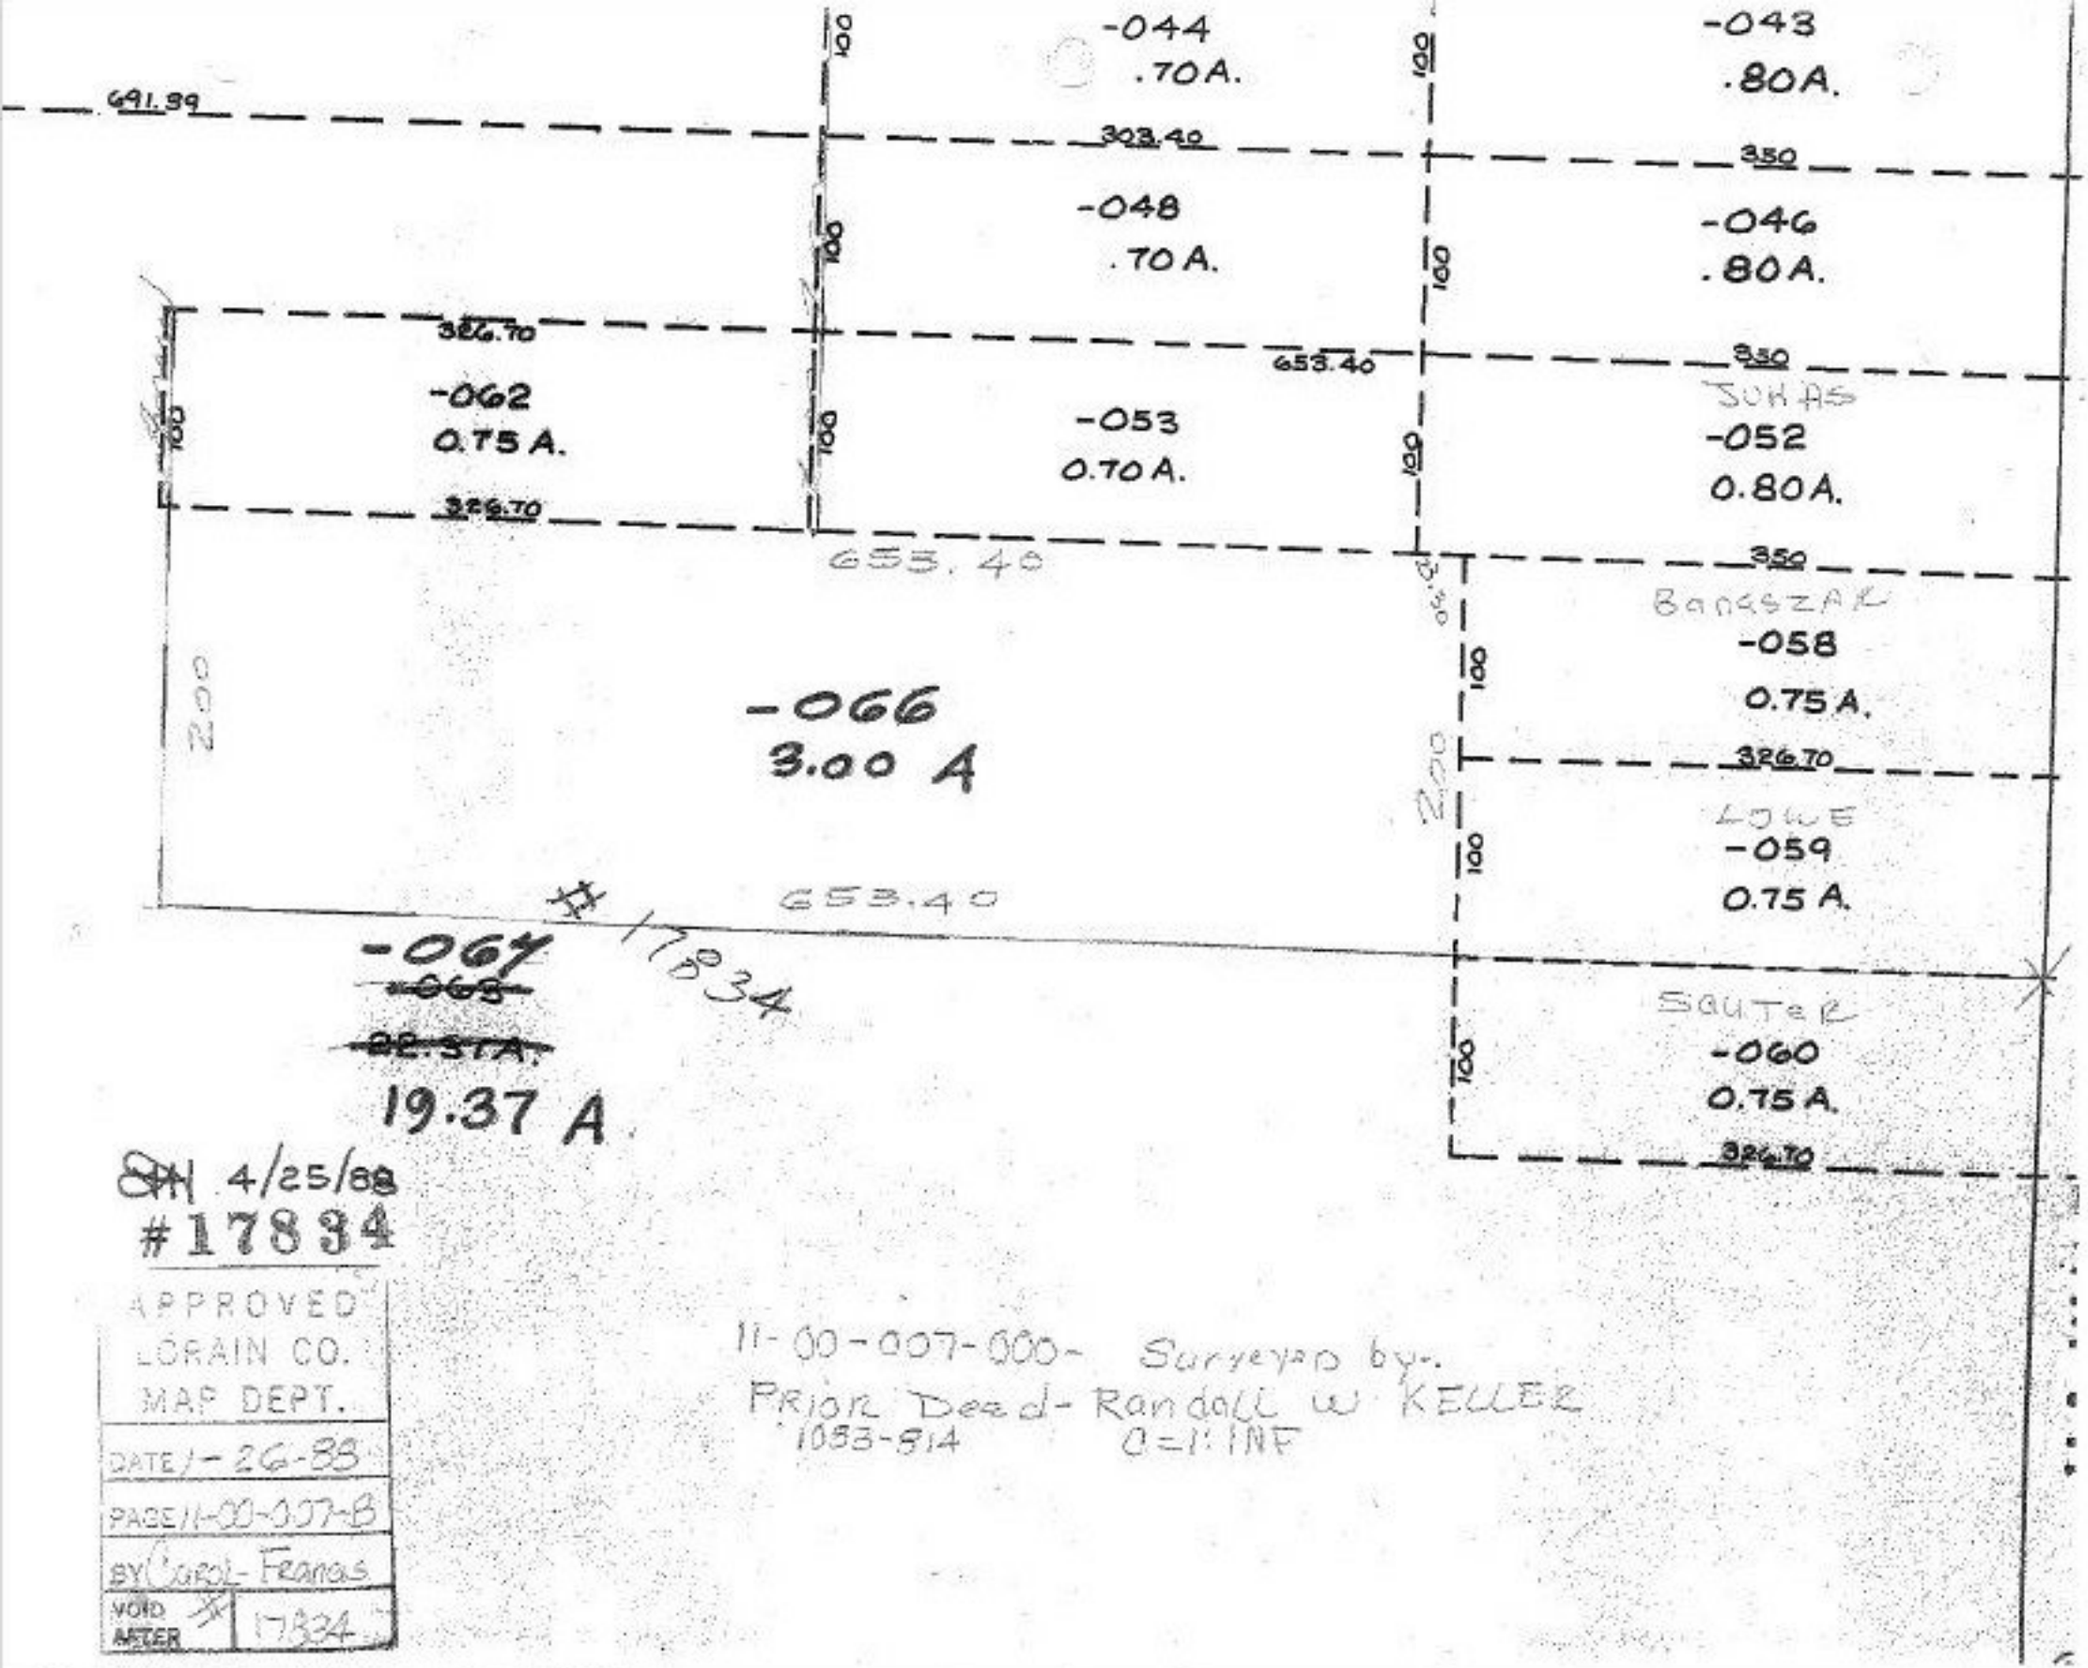
691.99
-044
.70A.
303.40
-043
.80A.
350
-048
.70A.
-046
.80A.
326.70
653.40
-062
0.75 A.
-053
0.70A.
JONAS
-052
0.80A.
326.70
653.40
BANASZAK
-058
0.75 A.
-066
3.00 A
LOWE
-059
0.75 A.
653.40
-067
-065
-02.37A.
19.37 A
17834
SAUTER
-060
0.75 A.
326.70
SPH 4/25/88
#17834
APPROVED
LORAIN CO.
MAP DEPT.
DATE 1-26-88
PAGE 11-00-007-B
BY CAROL-Franas
VOID AFTER 17834
11-00-007-000- Surveyed by-
PRIOR Deed- Randall W KELLER
1053-514 C=1: INF