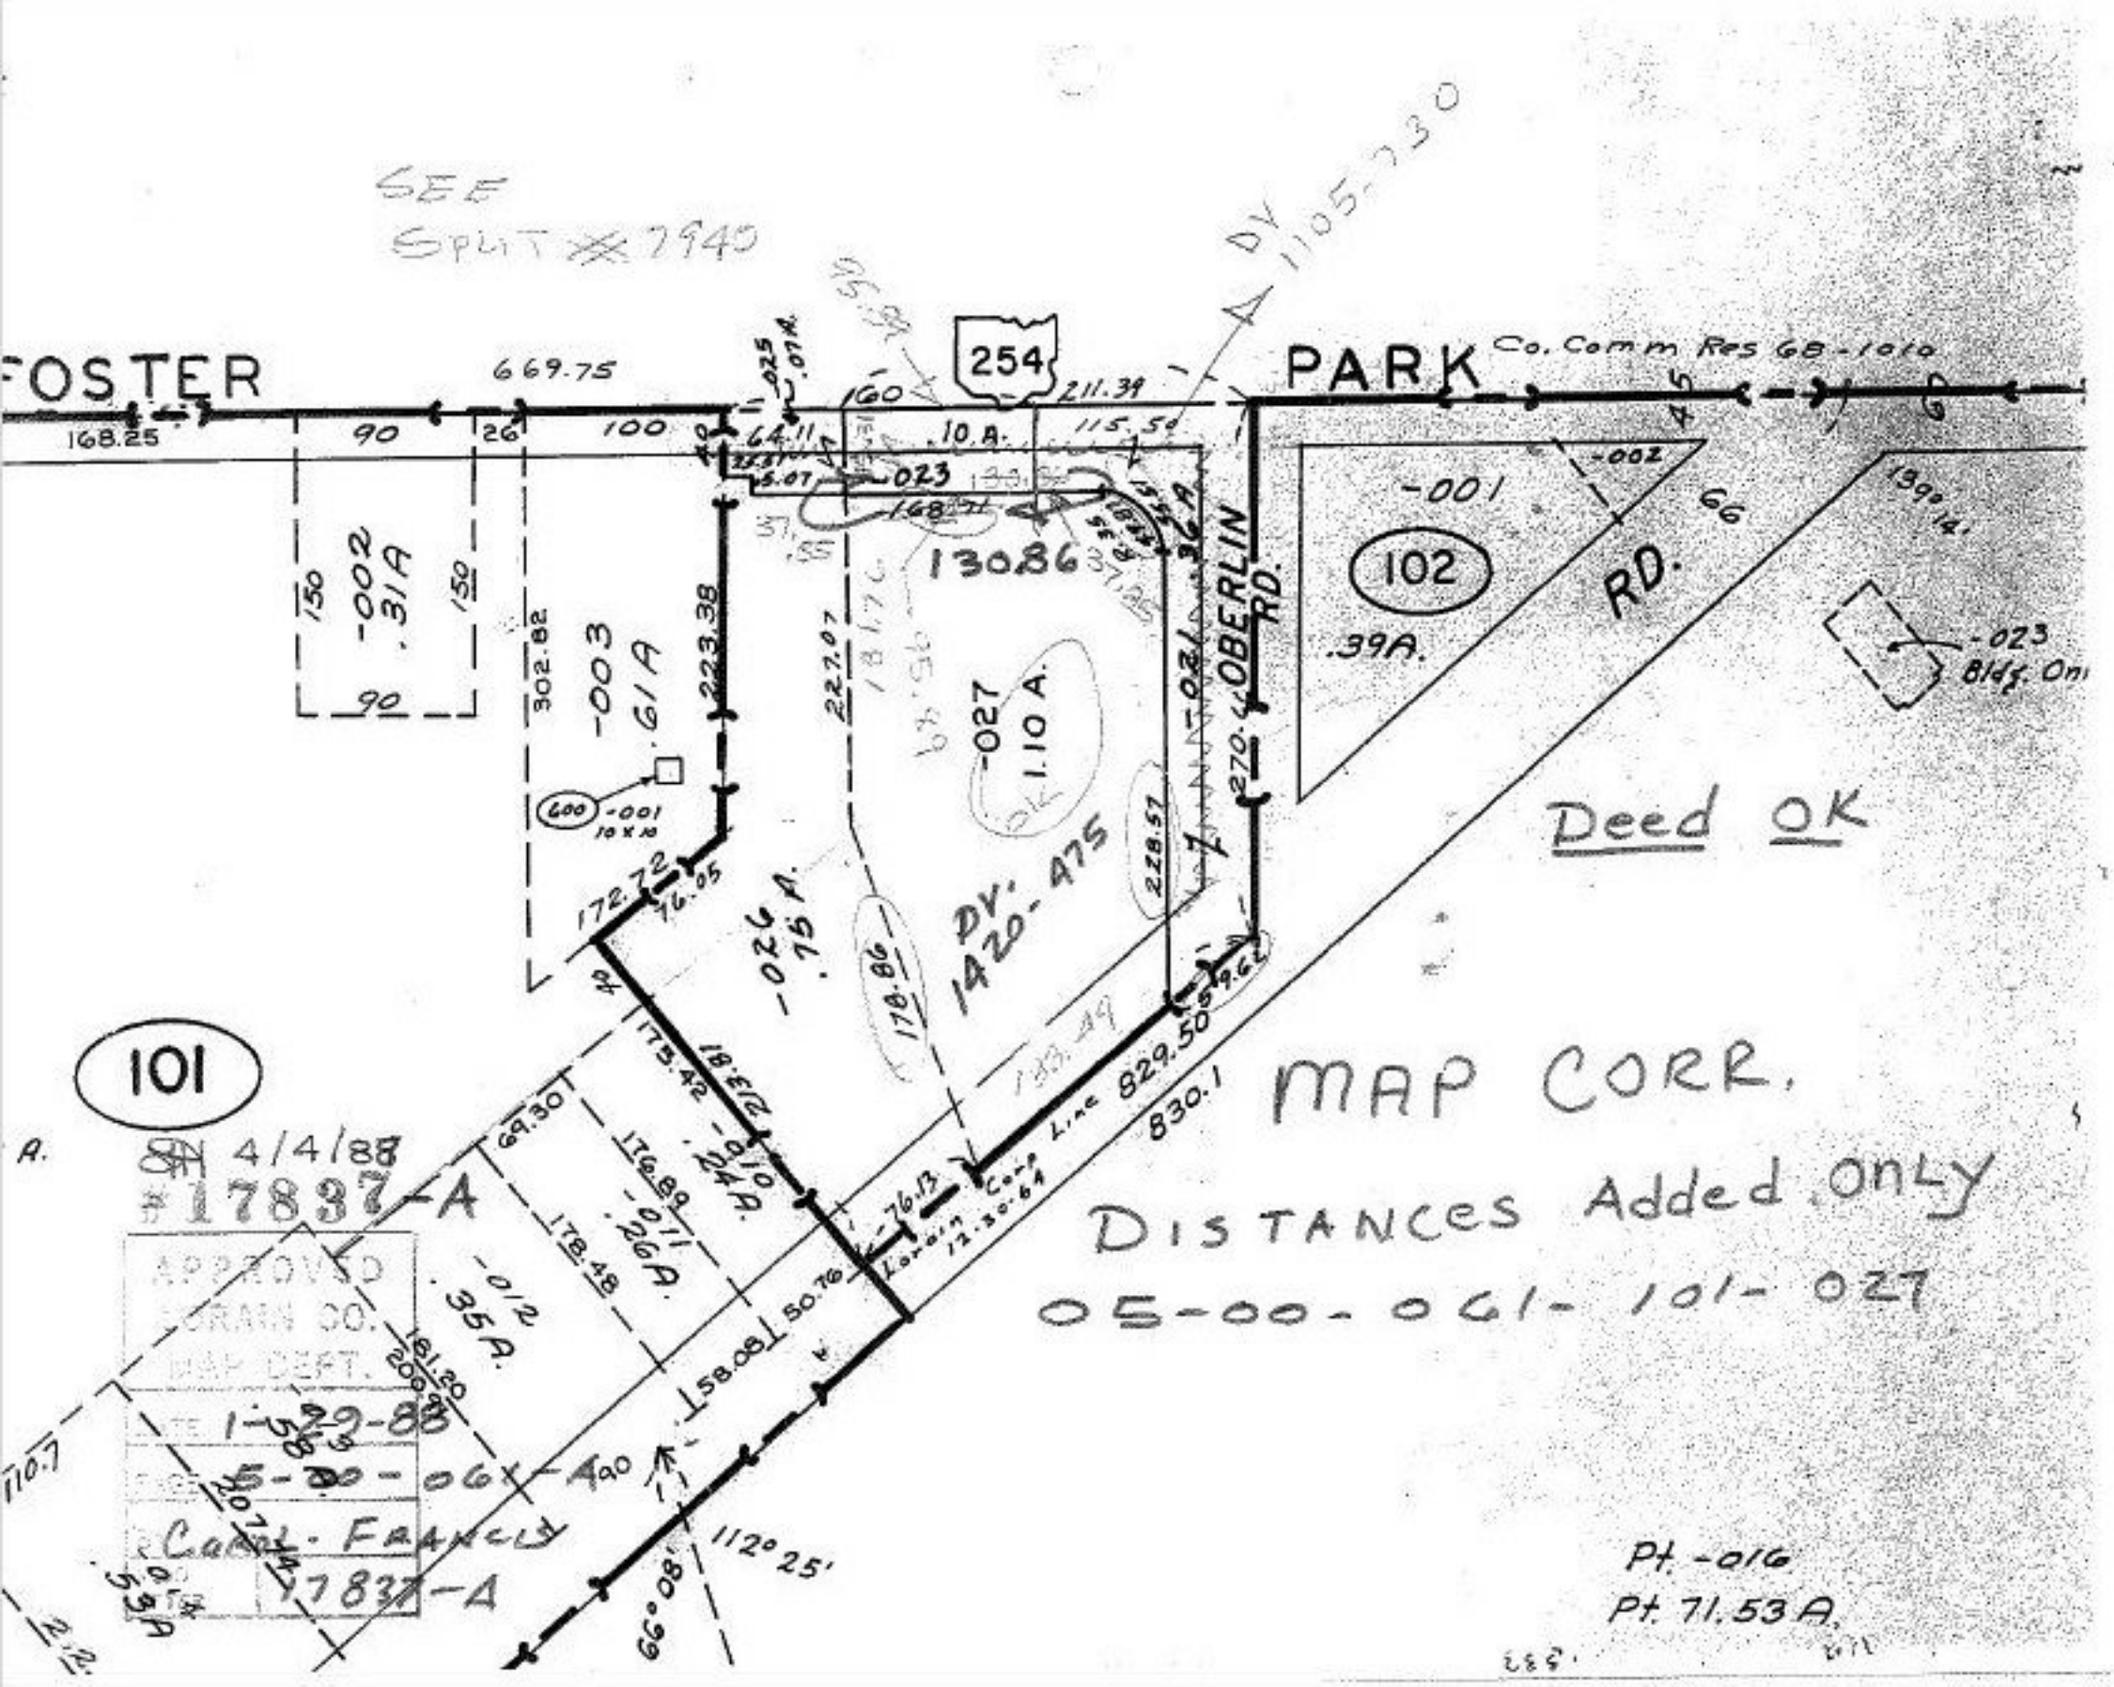
SEE
SPLIT #7940
FOSTER
669.75
168.25
90
26
100
64.11
.025
.01A.
254
211.39
PARK
Co. Comm Res 68-1010
DY 1105-730
160
10 A.
115.59
-023
168.71
-001
-002
66
390.14
13086
-003
.61A
150
-002
.31A
150
302.82
223.38
227.07
-027
1.10 A.
-028
270.44
OBERLIN RD.
102
.39A.
RD.
-023
Bldg. On
Deed OK
600
-001
10 X 10
172.72
76.05
-026
.75 A.
DV. 1420-475
228.57
178.86
178.49
MAP CORR.
DISTANCES Added only
05-00-061-101-027
101
A.
4/4/88
#17837-A
APPROVED
MAP DEPT.
DATE 1-22-88
PAGE 5-00-061-A90
17837-A
-012
.35A.
69.30
175.42
-010
.24A.
178.89
-011
.26A.
178.48
76.13
Corr. Line 829.50
Location 12-30-64
50.76
158.08
112° 25'
69° 08'
830.1
110.7
Pt. -016
Pt. 71.53 A.