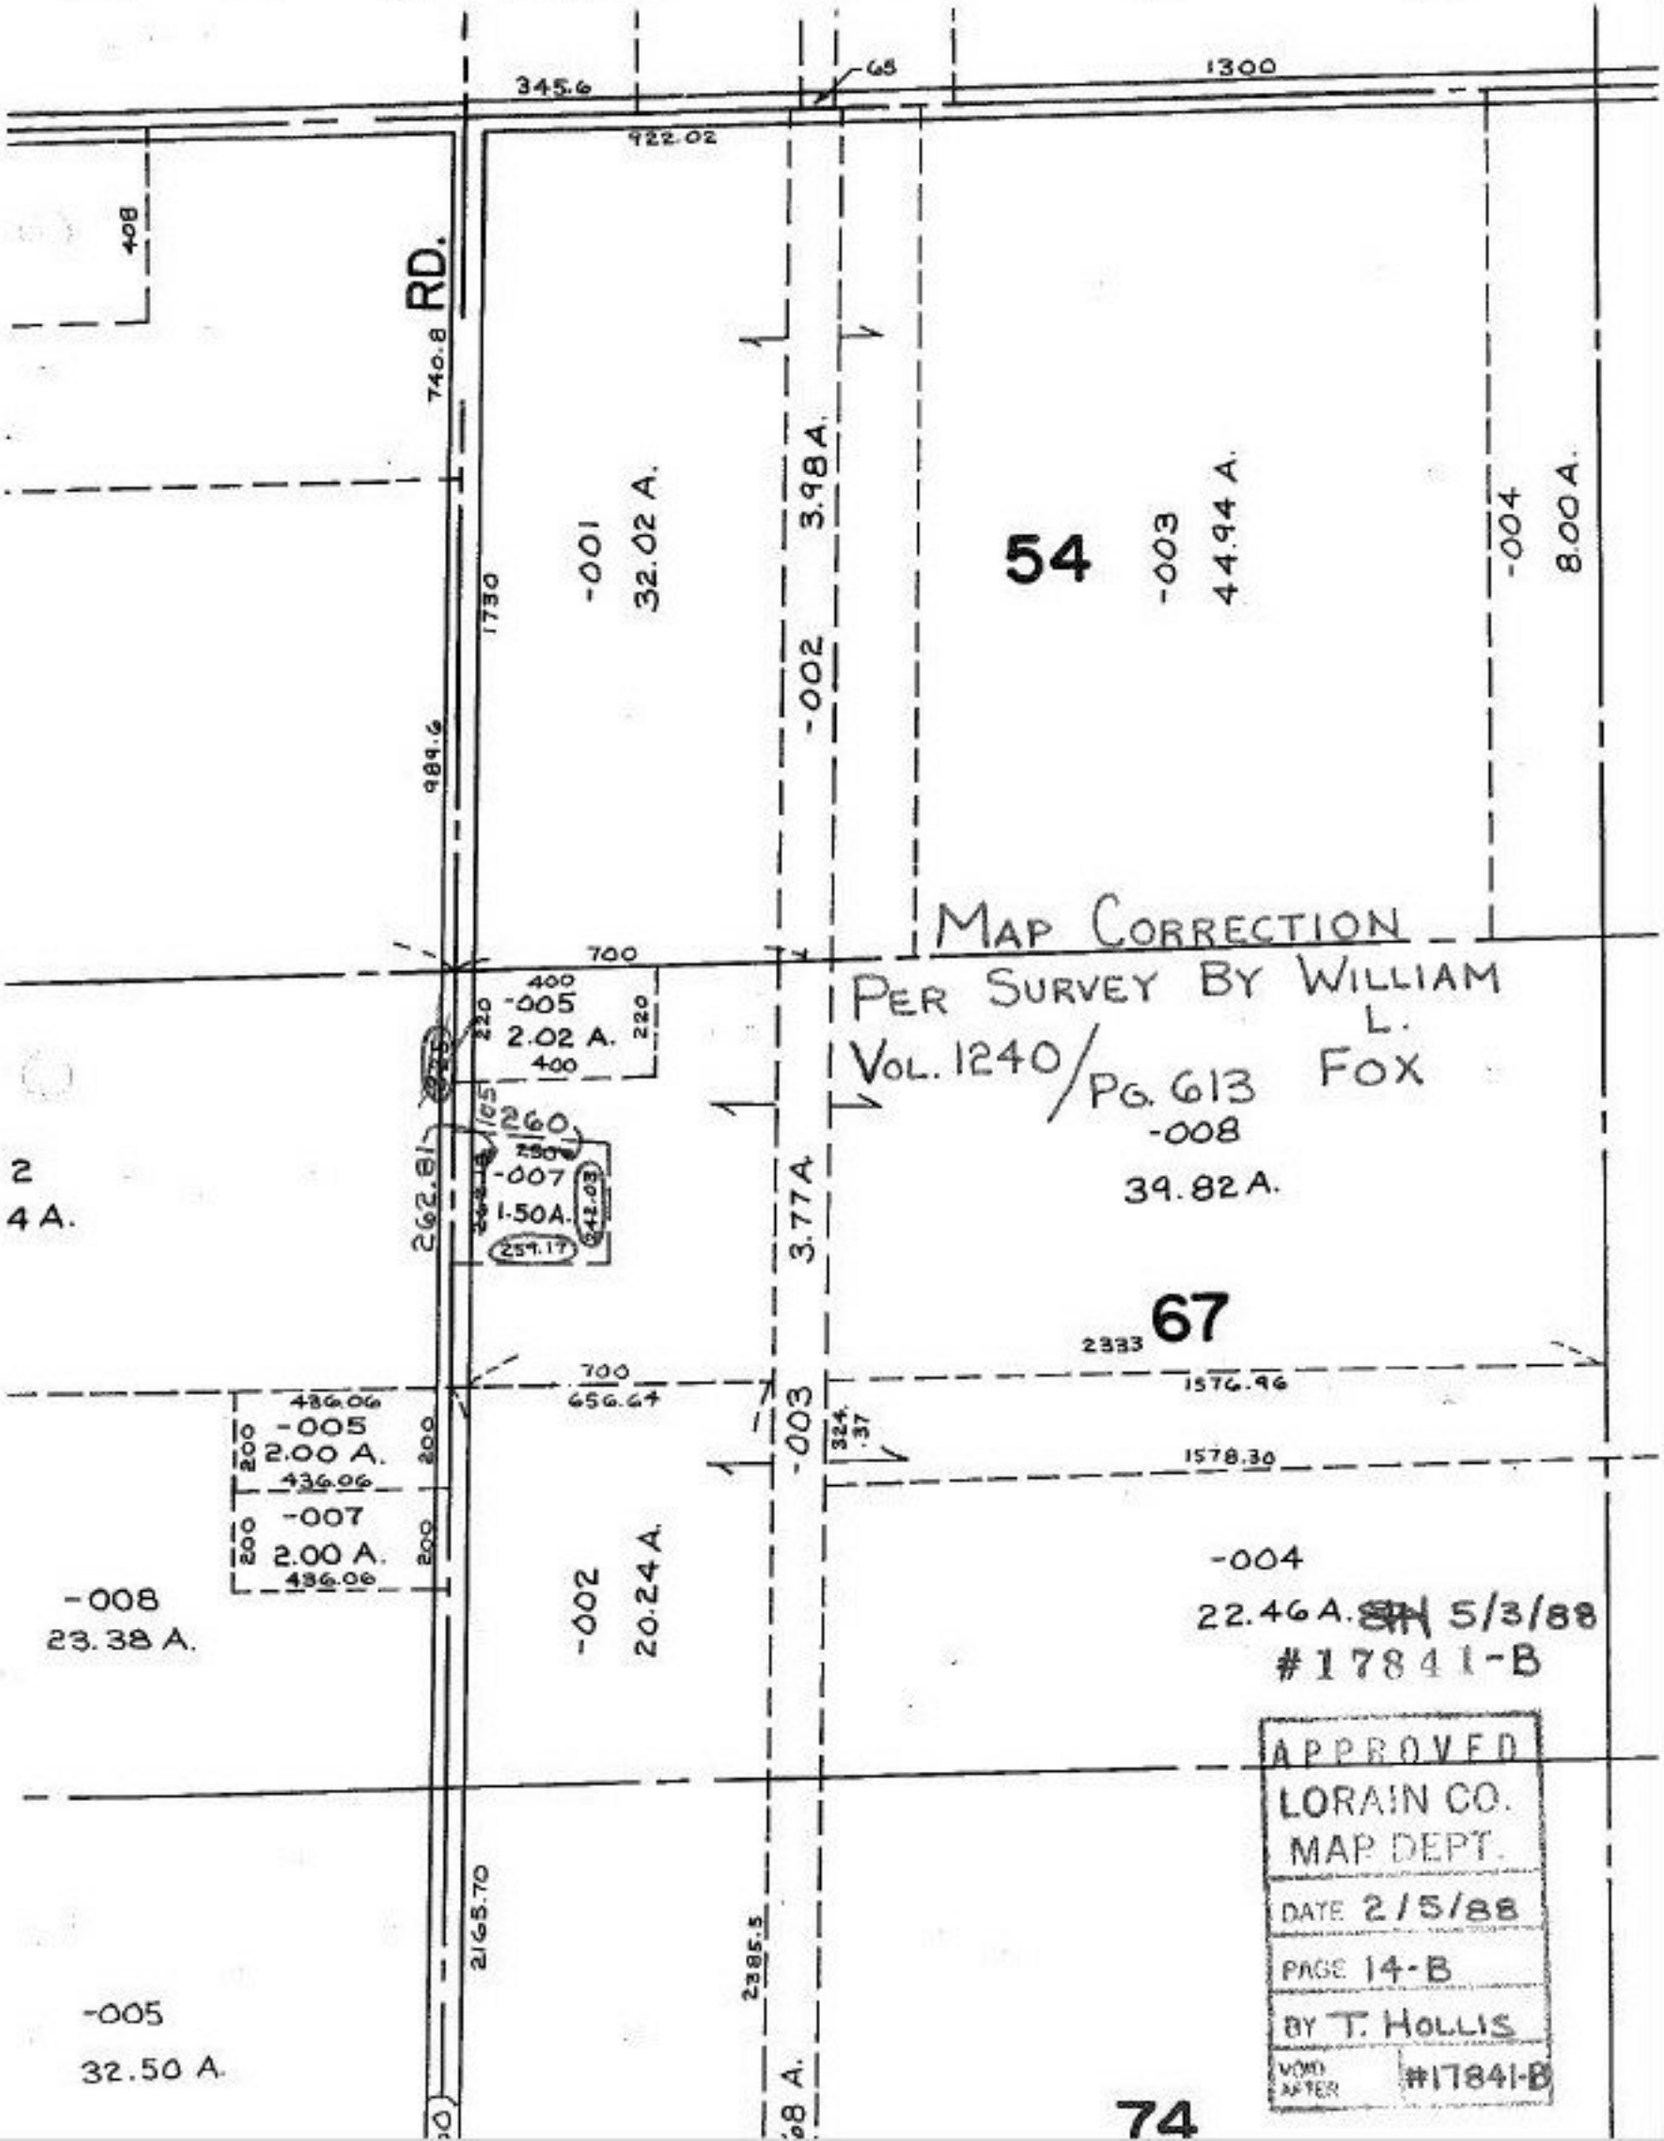
345.6
65
1300
922.02
408
RD.
740.8
1730
989.6
-001
32.02 A.
3.98A.
-002
54
-003
44.94 A.
-004
8.00A.
MAP CORRECTION
PER SURVEY BY WILLIAM L. FOX
VOL. 1240/PG. 613
700
400
-005
2.02 A.
220
400
160
-007
1.50A.
262.81
259.17
642.03
-008
39.82A.
3.77A
2
4 A.
67
2333
1576.96
700
656.64
436.06
-005
2.00 A.
200
436.06
-007
2.00 A.
436.06
-003
324.37
1578.30
-008
23.38 A.
-002
20.24 A.
-004
22.46A.
5/3/88
#17841-B
APPROVED
LORAIN CO.
MAP DEPT.
DATE 2/5/88
PAGE 14-B
BY T. HOLLIS
VOID AFTER #17841-B
2165.70
2385.5
-005
32.50 A.
74