T.M Pg 5-00-057-A

Add To Dup.

Parcel Not shown on New Tax Map - is being Added per Deed Vol 481-256 & 748-407 & Survey Map by Jackson Hura & Assoc.
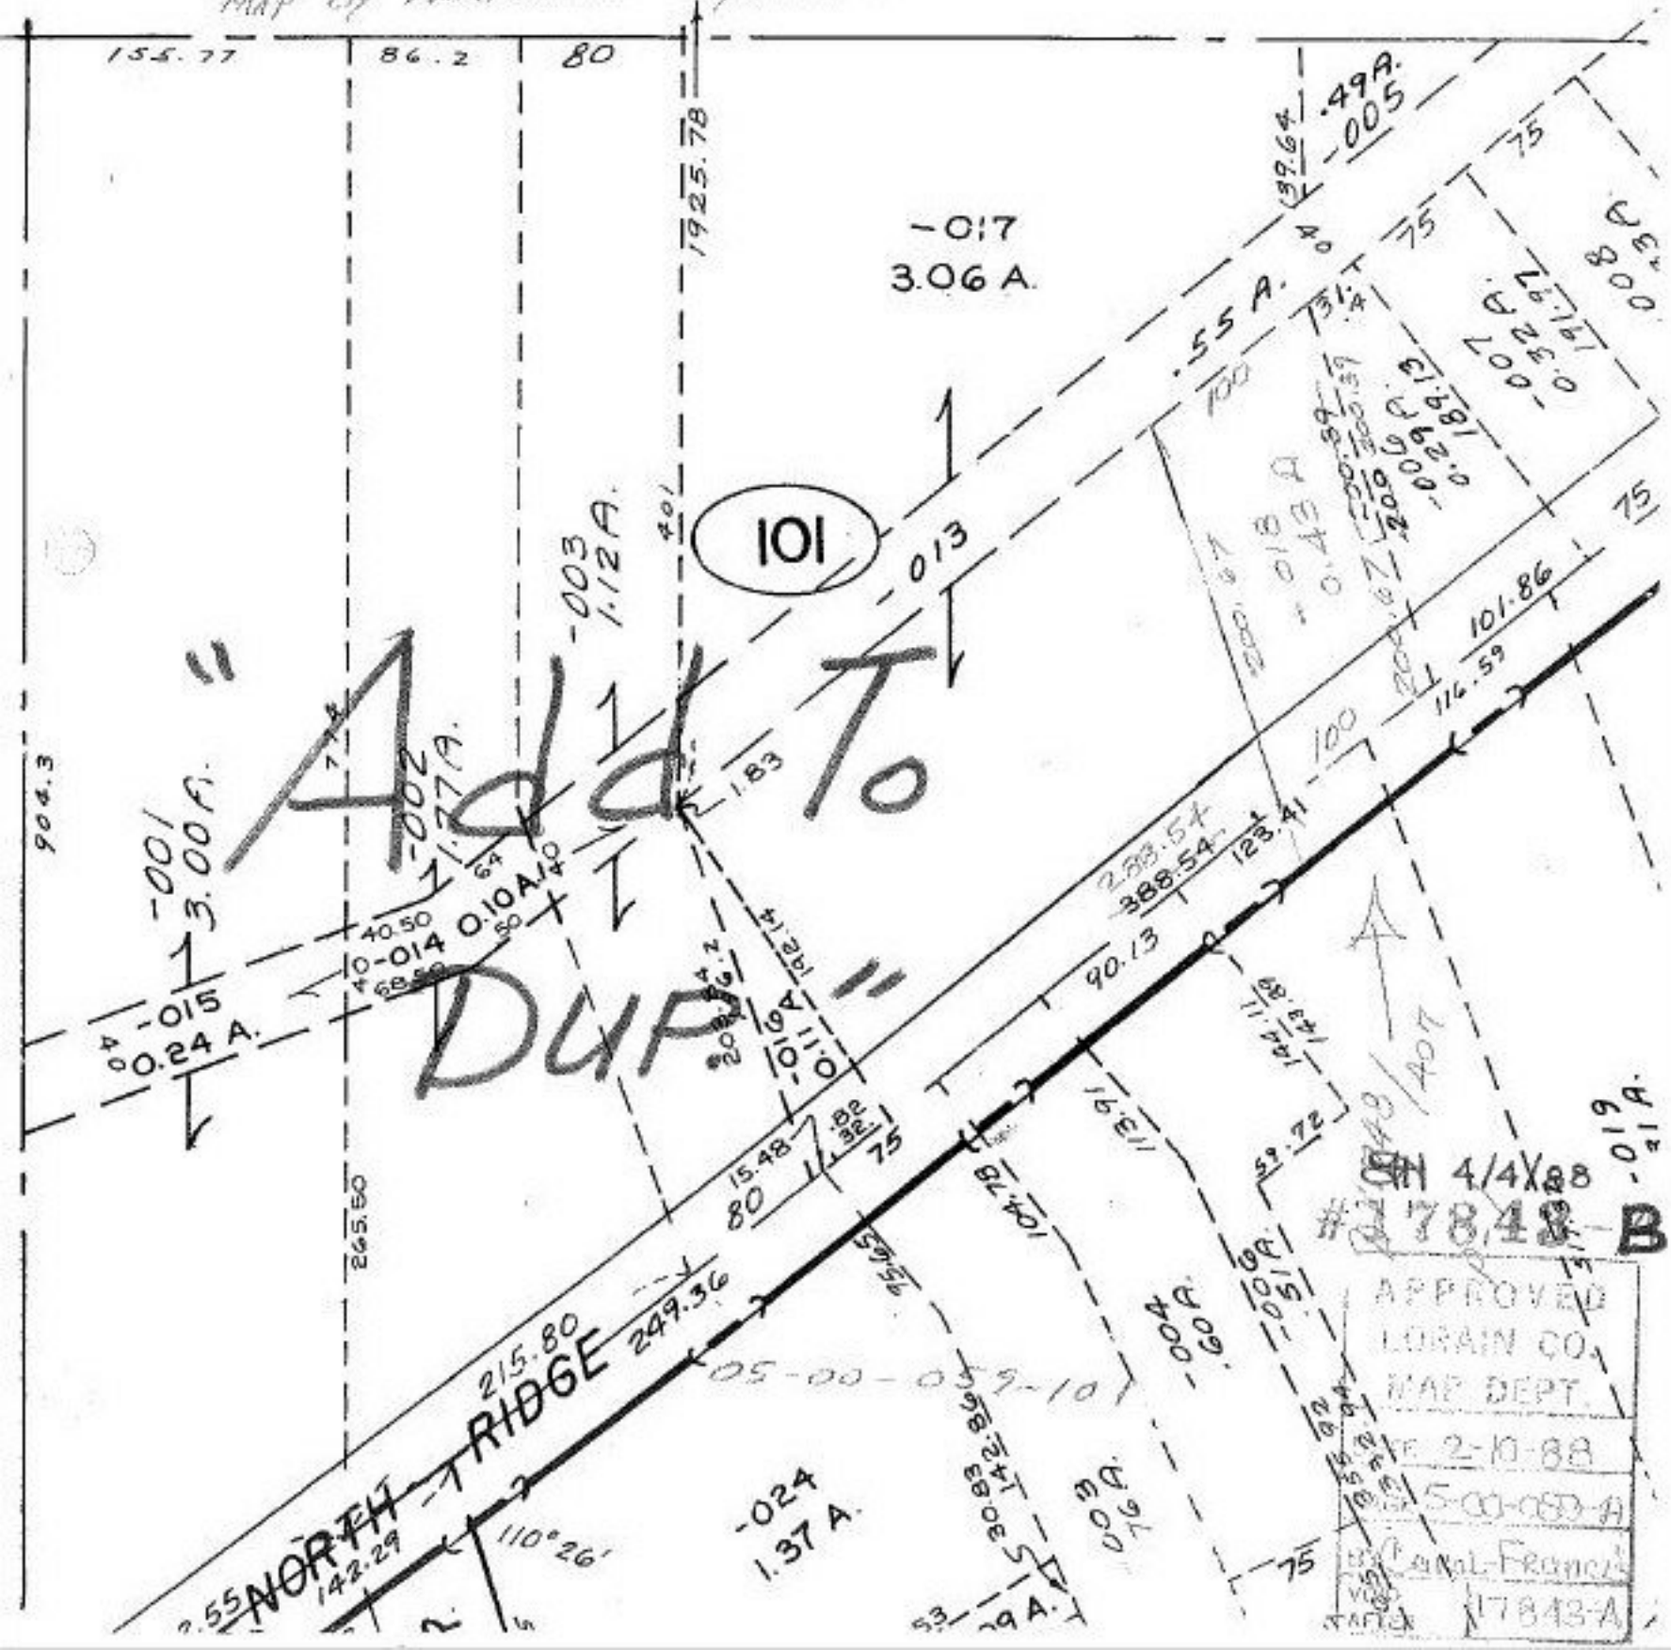
SEE 5-00-060-A