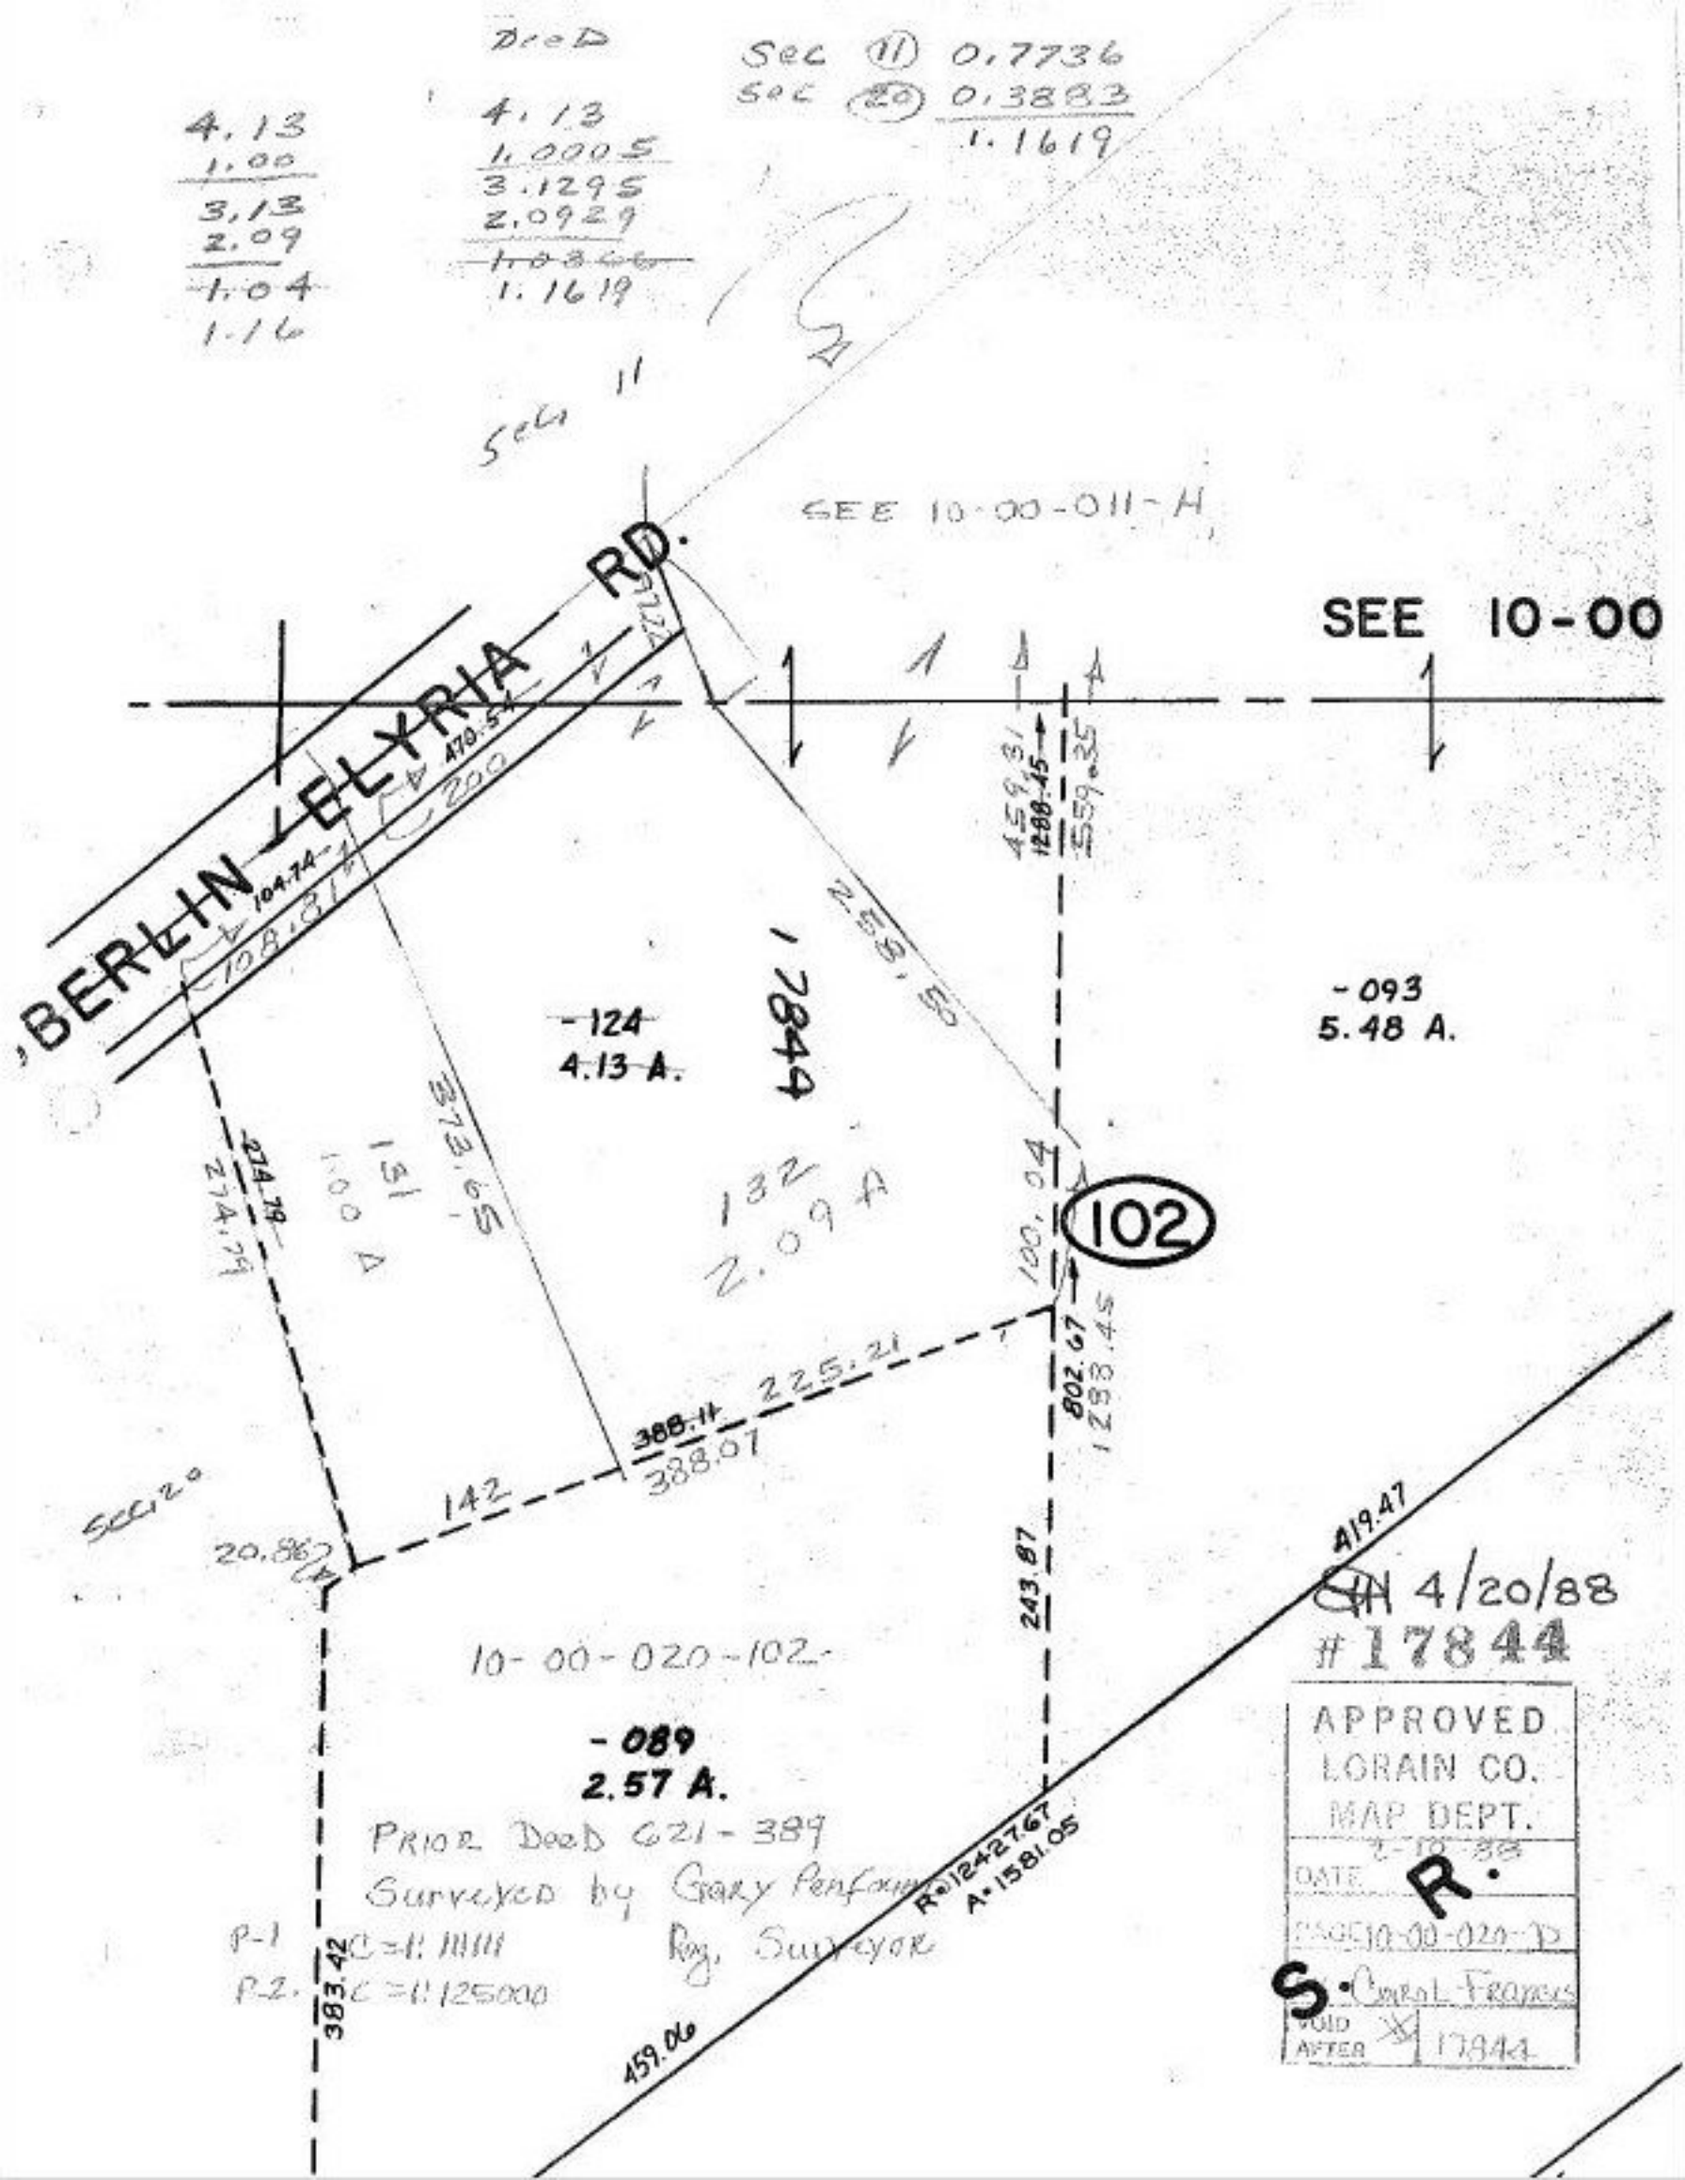

Deed
Sec (11) 0.7736
Sec (20) 0.3883
1.1619
4.13
1.00
3.13
2.09
1.04
1.16
4.13
1.0005
3.1295
2.0929
1.0866
1.1619
Sec 11
SEE 10-00-011-H
SEE 10-00
BERLIN - ELYRIA RD.
470.54
200
104.74
108.81
459.31
1288.45
559.35
258.50
17844
-124
4.13 A.
-093
5.48 A.
373.65
131
1.00 A
274.79
274.79
132
2.09 A
100.04
102
802.67
1288.45
225.21
388.11
388.07
142
Sec 20
20.86
243.87
419.47
10-00-020-102
-089
2.57 A.
PRIOR DEED 621-389
Surveyed by Gary Penfoun
Reg. Surveyor
P-1 C=1:111111
P-2 C=1:125000
383.42
459.06
R=12427.67
A=1581.05
4/20/88
#17844
APPROVED
LORAIN CO.
MAP DEPT.
DATE 2-10-88
R.
PAGE 10-00-020-D
S. Carol Francis
VOID AFTER 17844