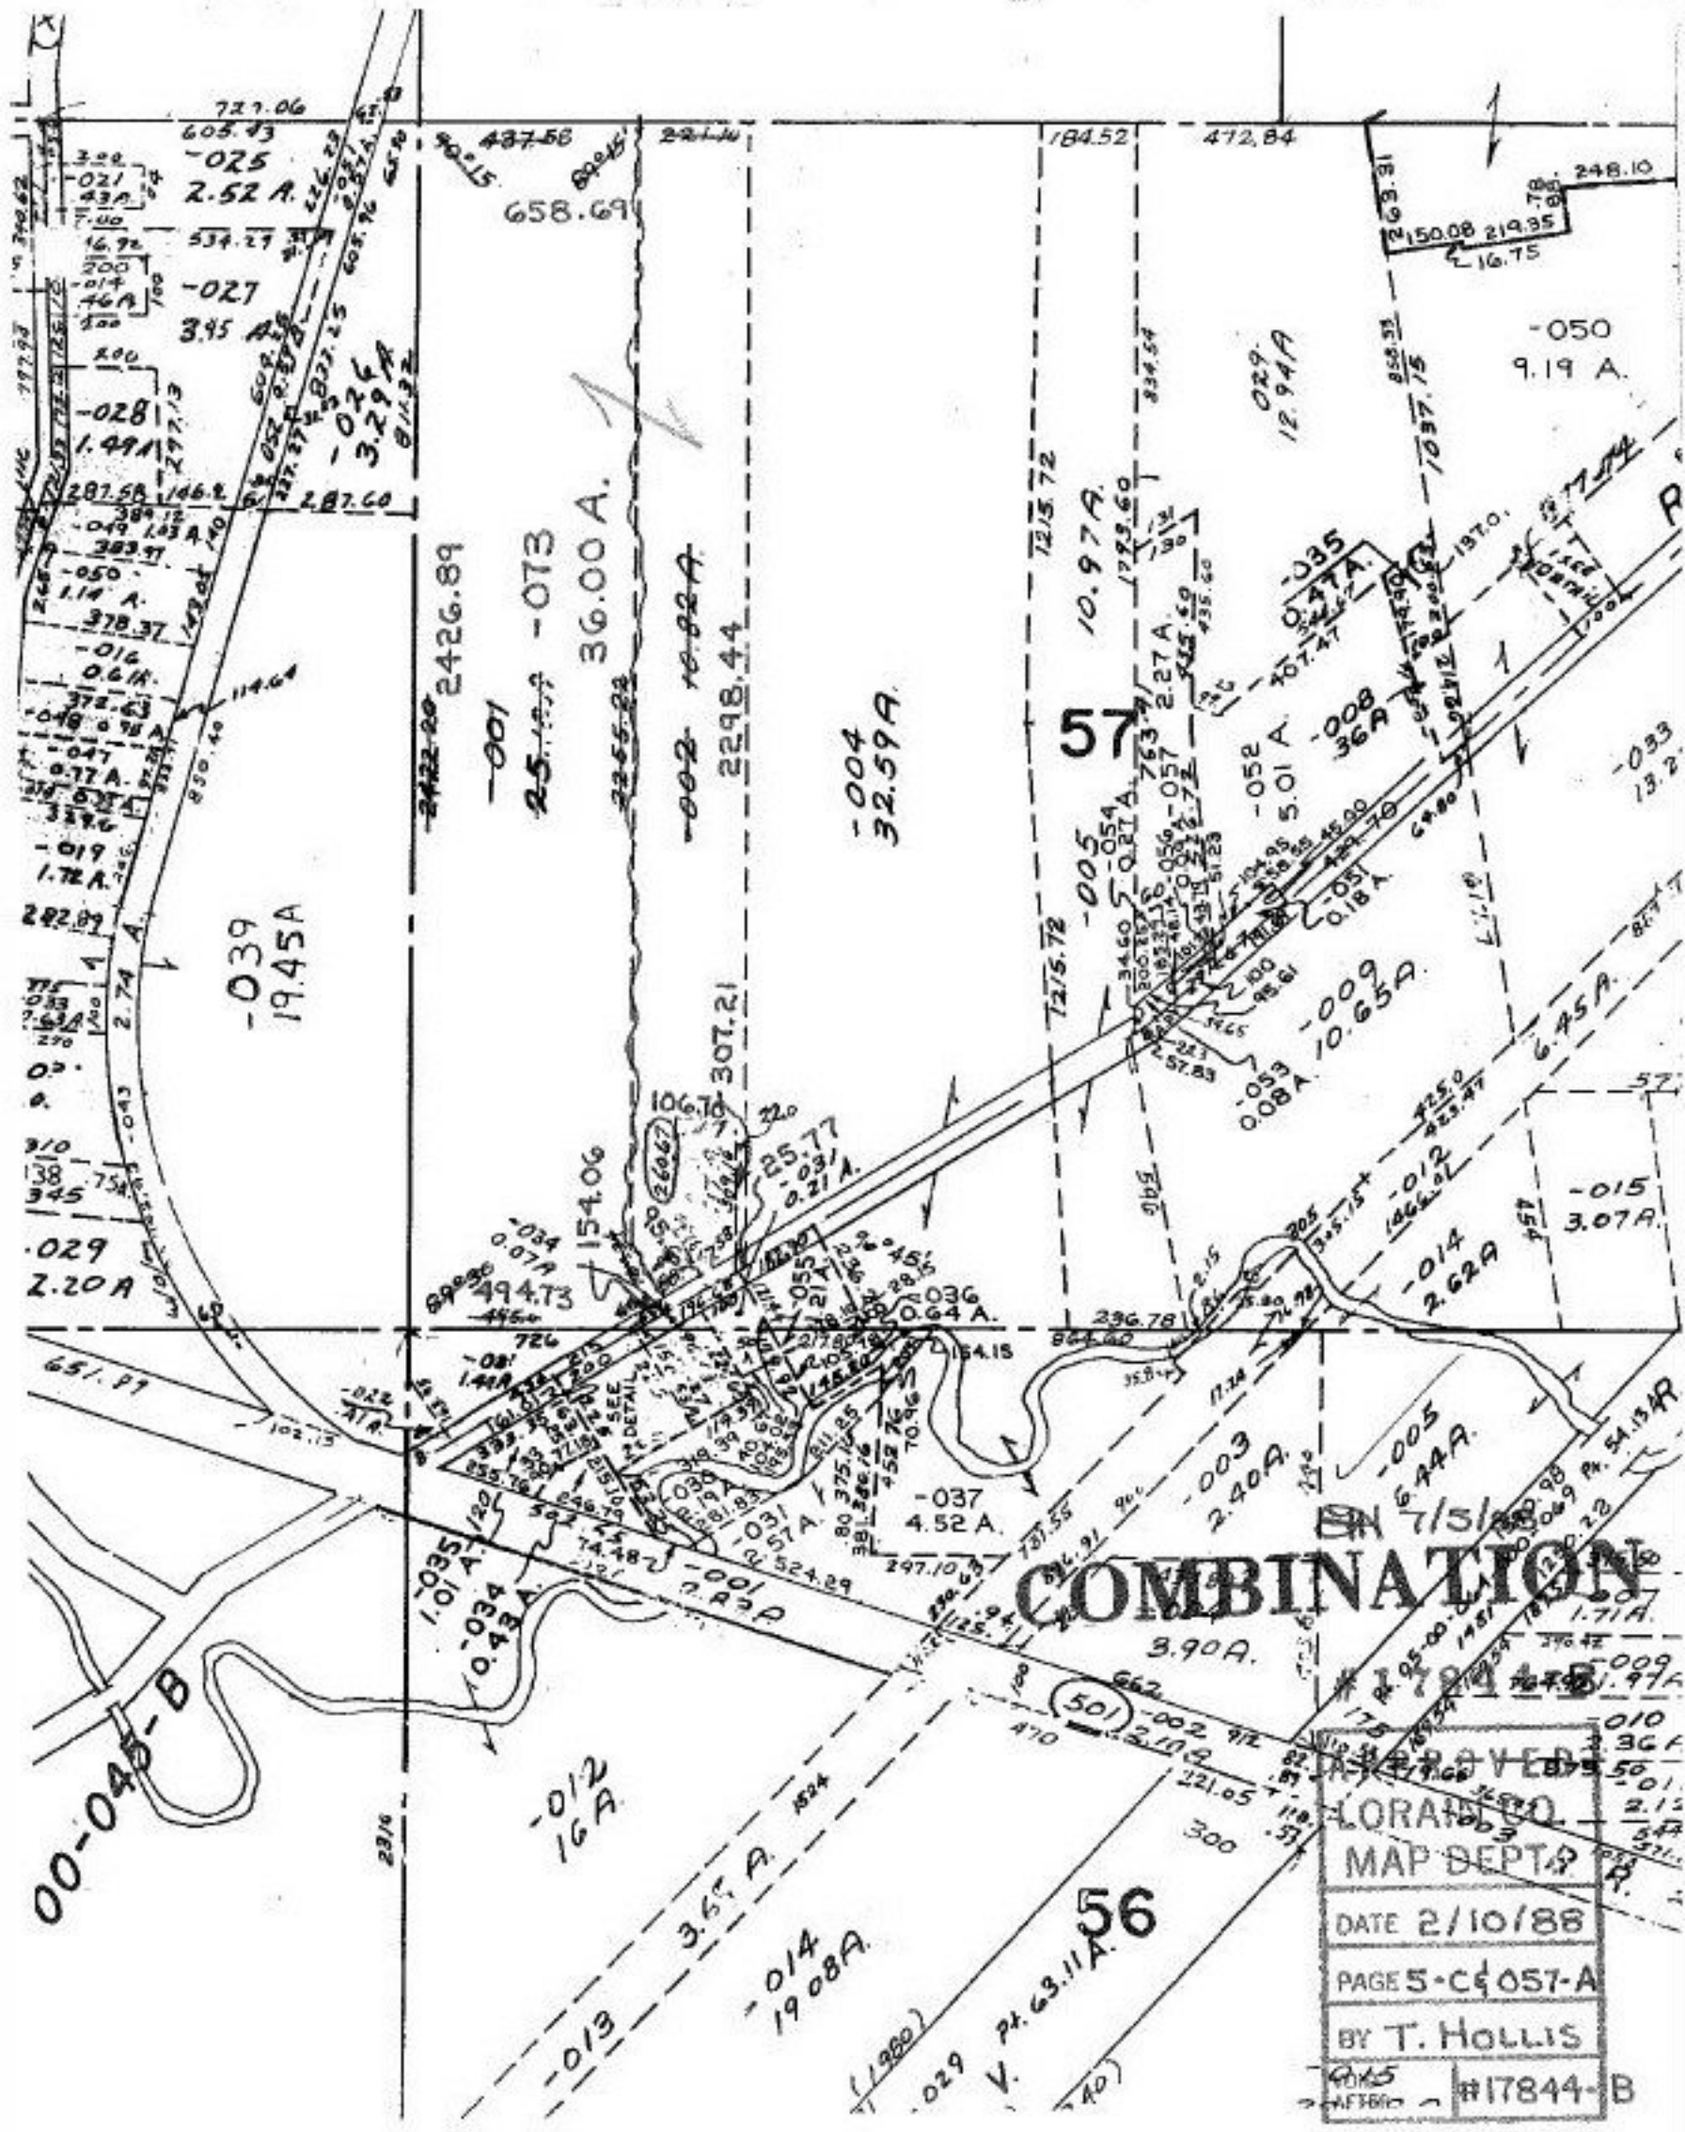
COMBINATION
#17844-B
APPROVED
LORAIN CO.
MAP DEPT.
DATE 2/10/88
PAGE 5-C & 057-A
BY T. HOLLIS
#17844-B
57
56
00-045-B
-025
2.52 A.
-027
3.45 A.
-026
3.29 A.
-028
1.49 A.
-050
9.19 A.
-073
36.00 A.
-004
32.59 A.
-039
19.45 A.
-029
2.20 A.
-005
10.97 A.
-008
36 A.
-009
10.65 A.
-014
2.62 A.
-015
3.07 A.
-037
4.52 A.
-012
16 A.
-014
19.08 A.
-013
3.65 A.