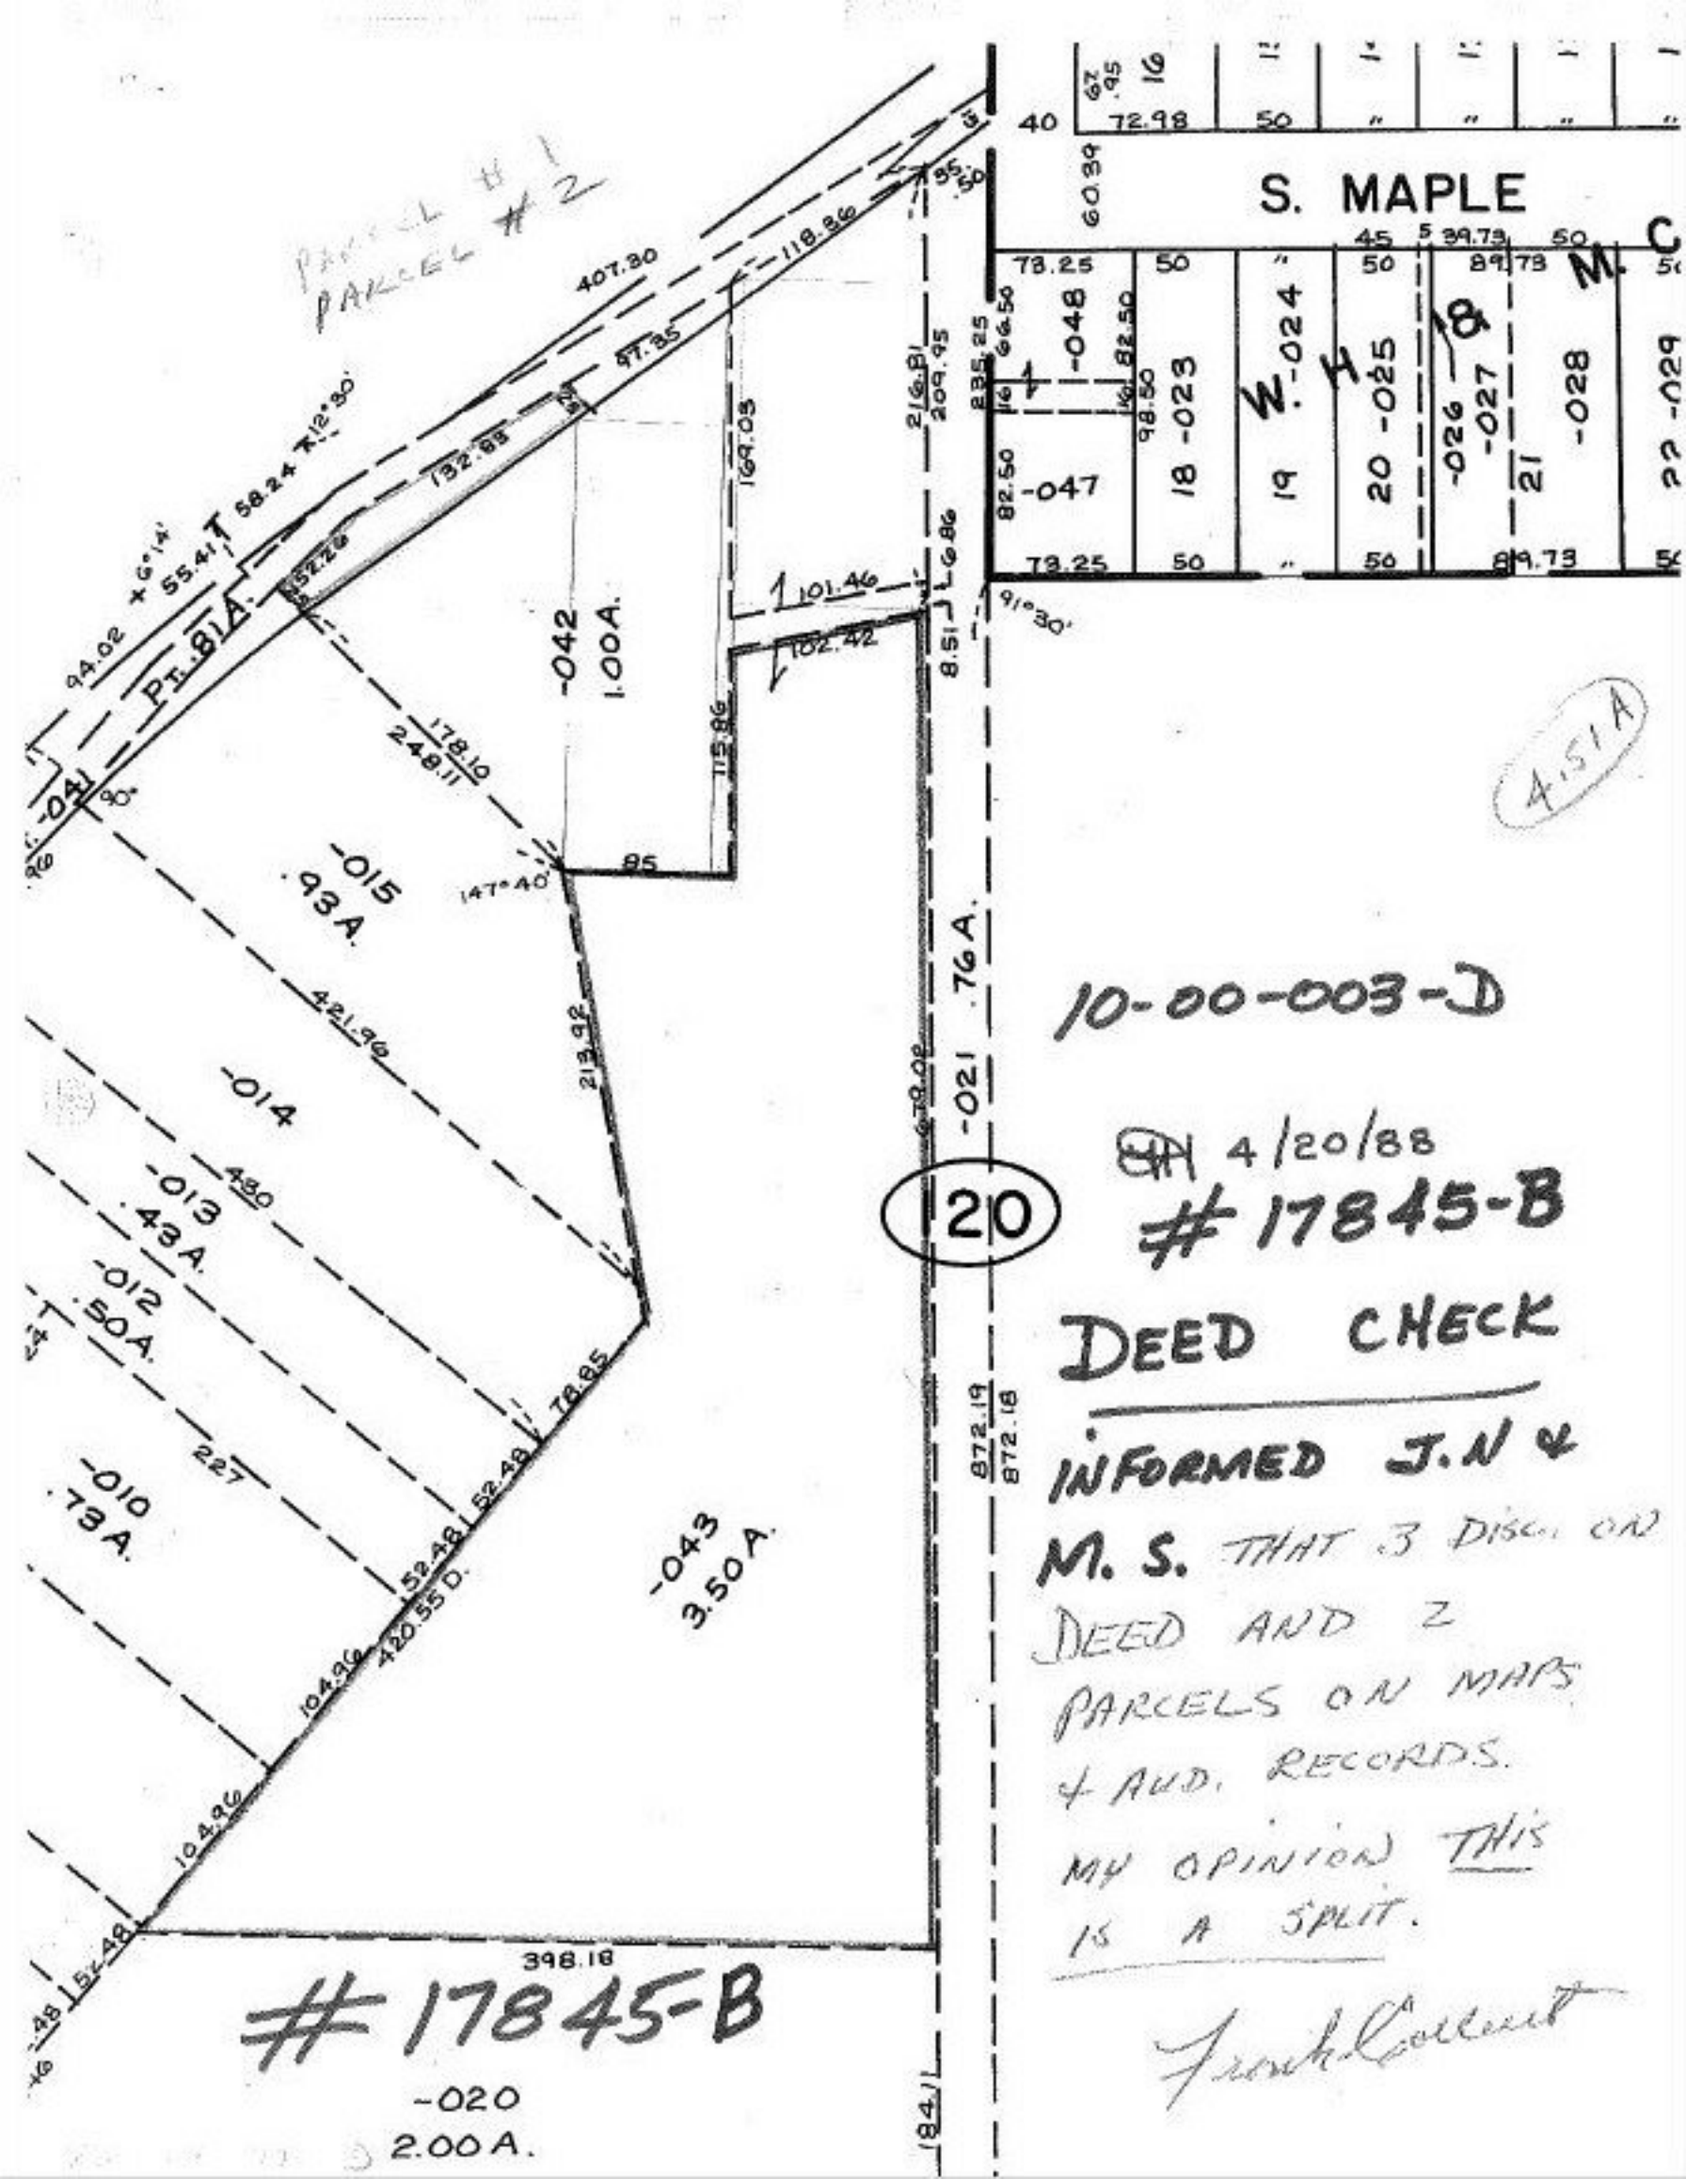
S. MAPLE
PARCEL #1
PARCEL #2
-042
1.00A.
-041
-015
.93A.
-014
-013
.43A.
-012
.50A.
-010
.73A.
-043
3.50A.
-021
.76A.
-020
2.00A.
20
#17845-B
#17845-B
10-00-003-D
4/20/88
DEED CHECK
INFORMED J.N & M.S. THAT 3 DISC. ON DEED AND 2 PARCELS ON MAPS & AUD. RECORDS. MY OPINION THIS IS A SPLIT.
Frank Collett
4.51A