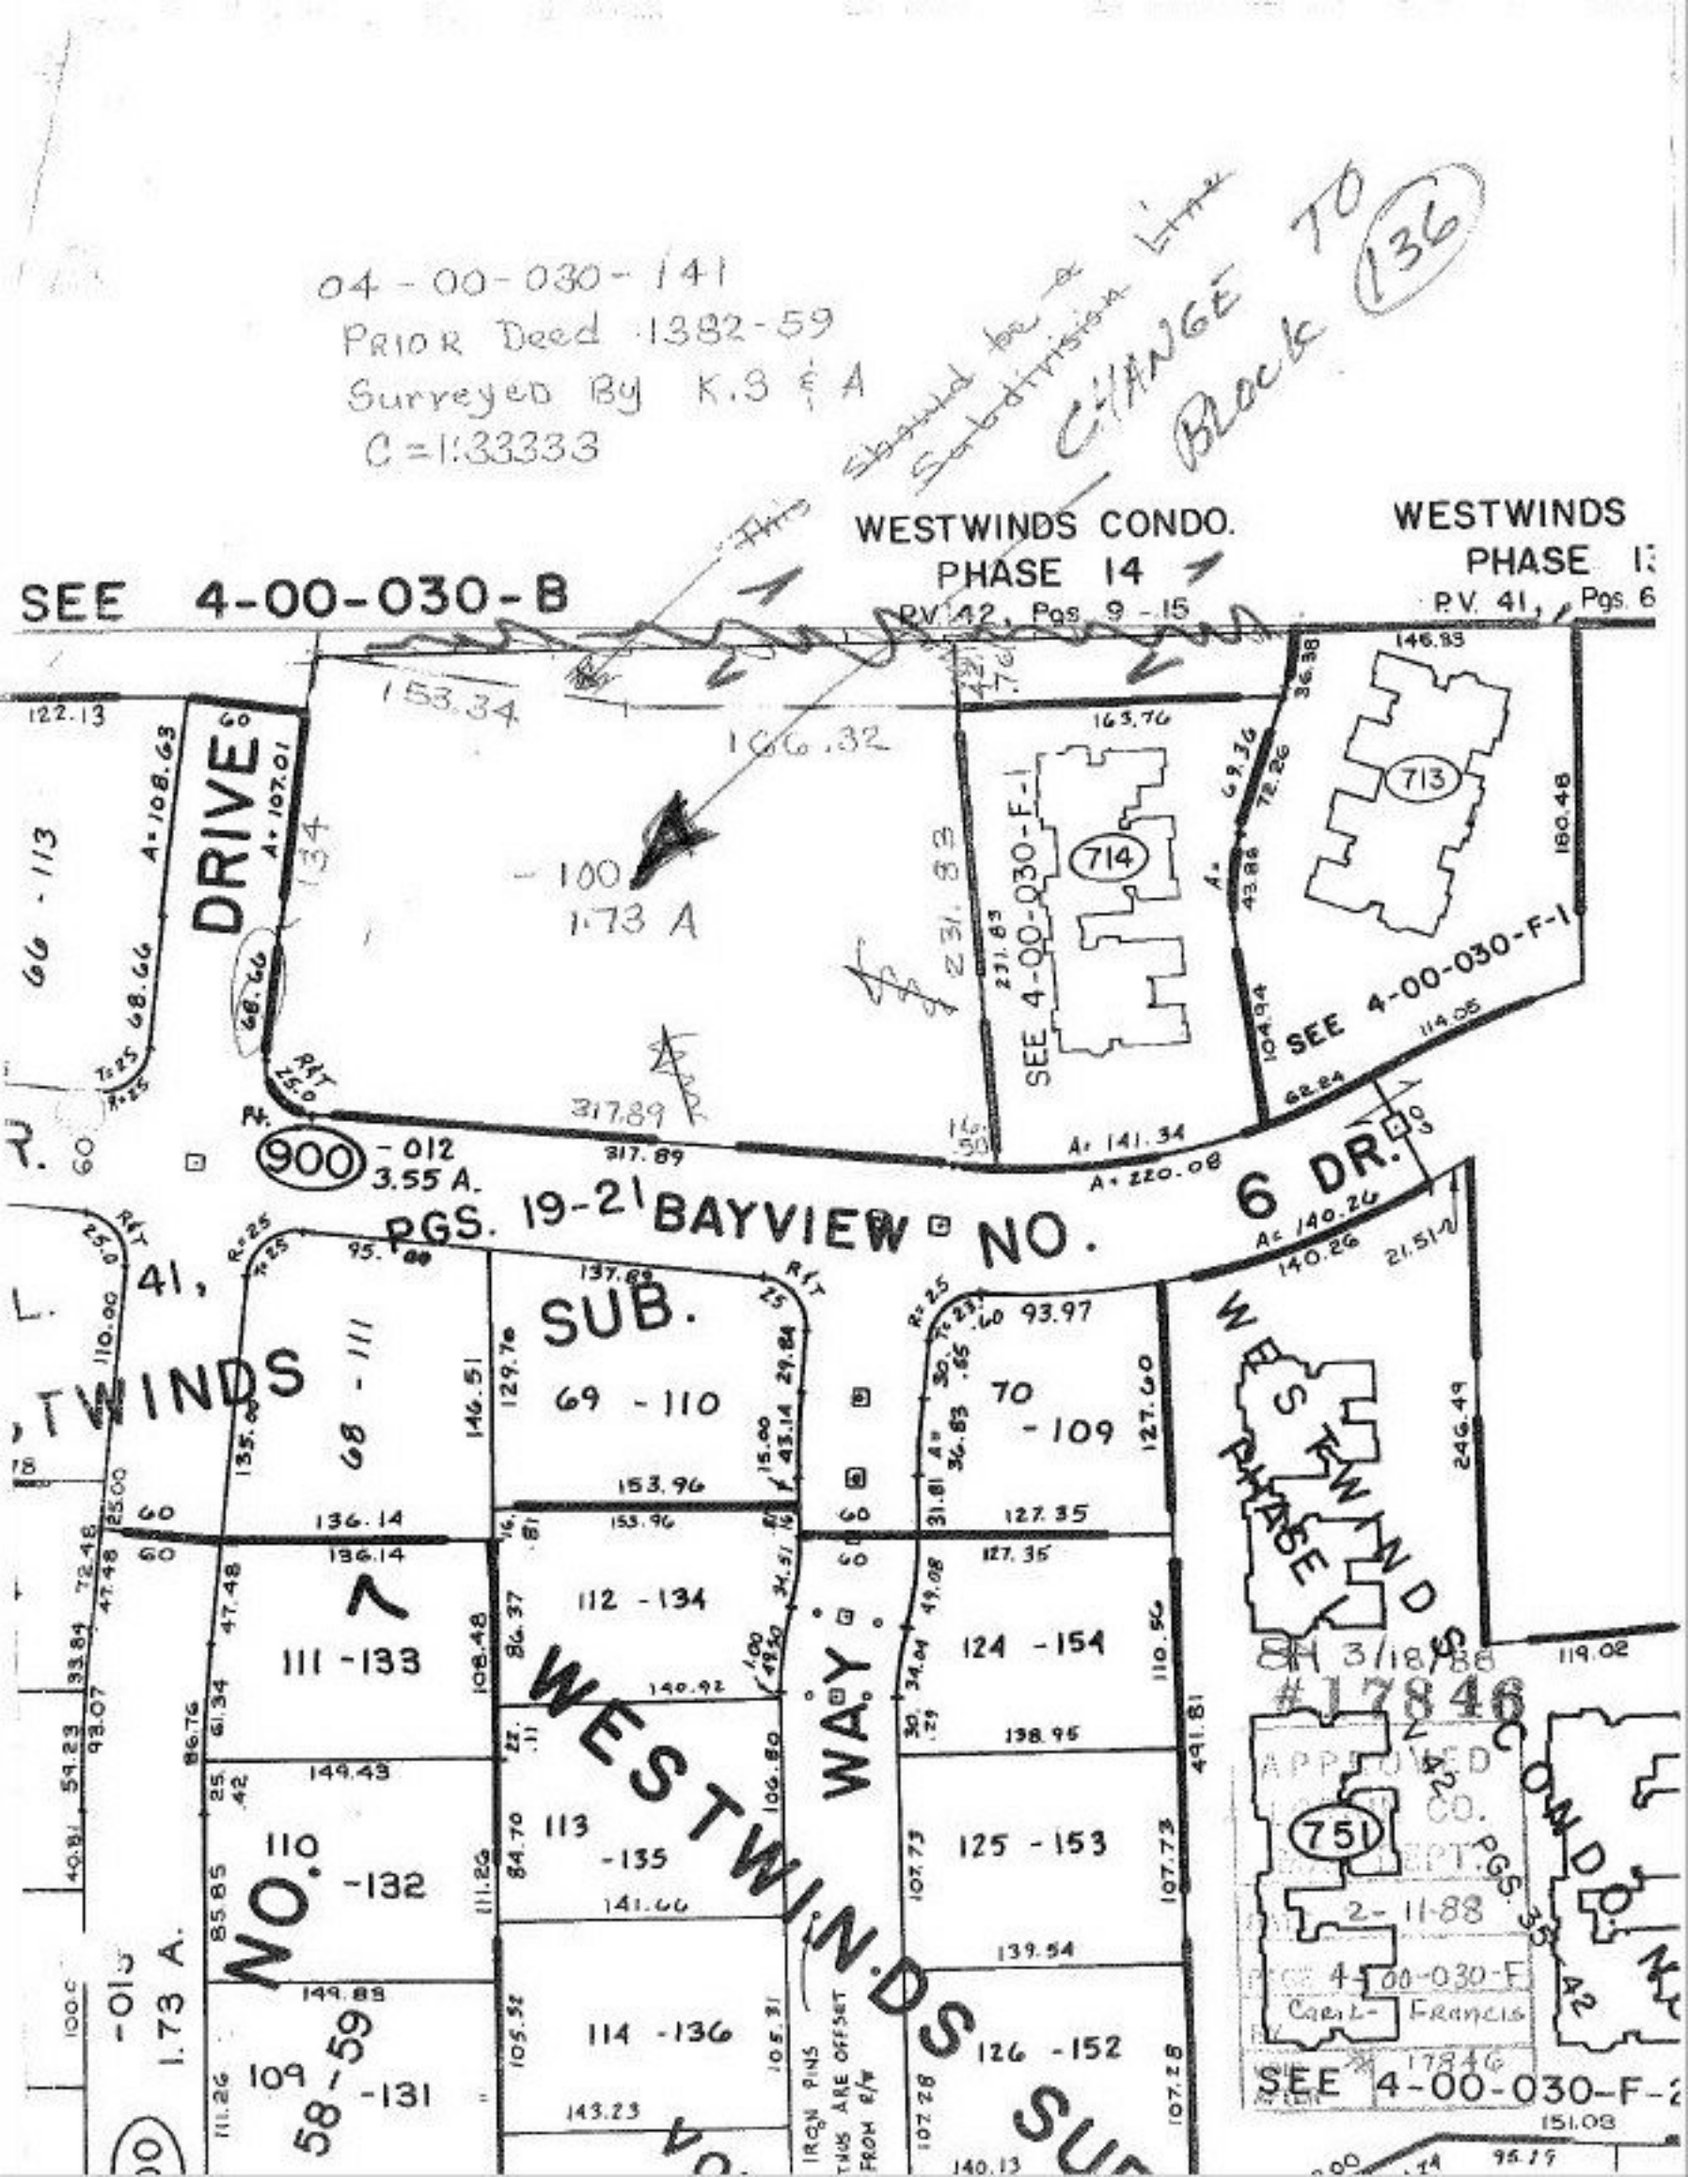
04-00-030-141
PRIOR Deed 1382-59
Surveyed By K.S & A
C=1:33333
CHANGE TO Block 136
WESTWINDS CONDO. PHASE 14
P.V. 42, Pgs. 9-15
WESTWINDS PHASE 13
P.V. 41, Pgs. 6
SEE 4-00-030-B
DRIVE
153.34
166.32
-100
1.73 A
SEE 4-00-030-F-1
SEE 4-00-030-F-1
900 -012 3.55 A.
317.89
A= 141.34
A= 220.08
RGS. 19-21 BAYVIEW NO. 6 DR.
A= 140.26
140.26
SUB.
68 - 111
69 - 110
70 - 109
111 - 133
112 - 134
124 - 154
110 - 132
113 - 135
125 - 153
109 - 131
114 - 136
126 - 152
WESTWINDS WAY
WESTWINDS PHASE I
#17846
751
SEE 4-00-030-F-2
-013 1.73 A.
NO.