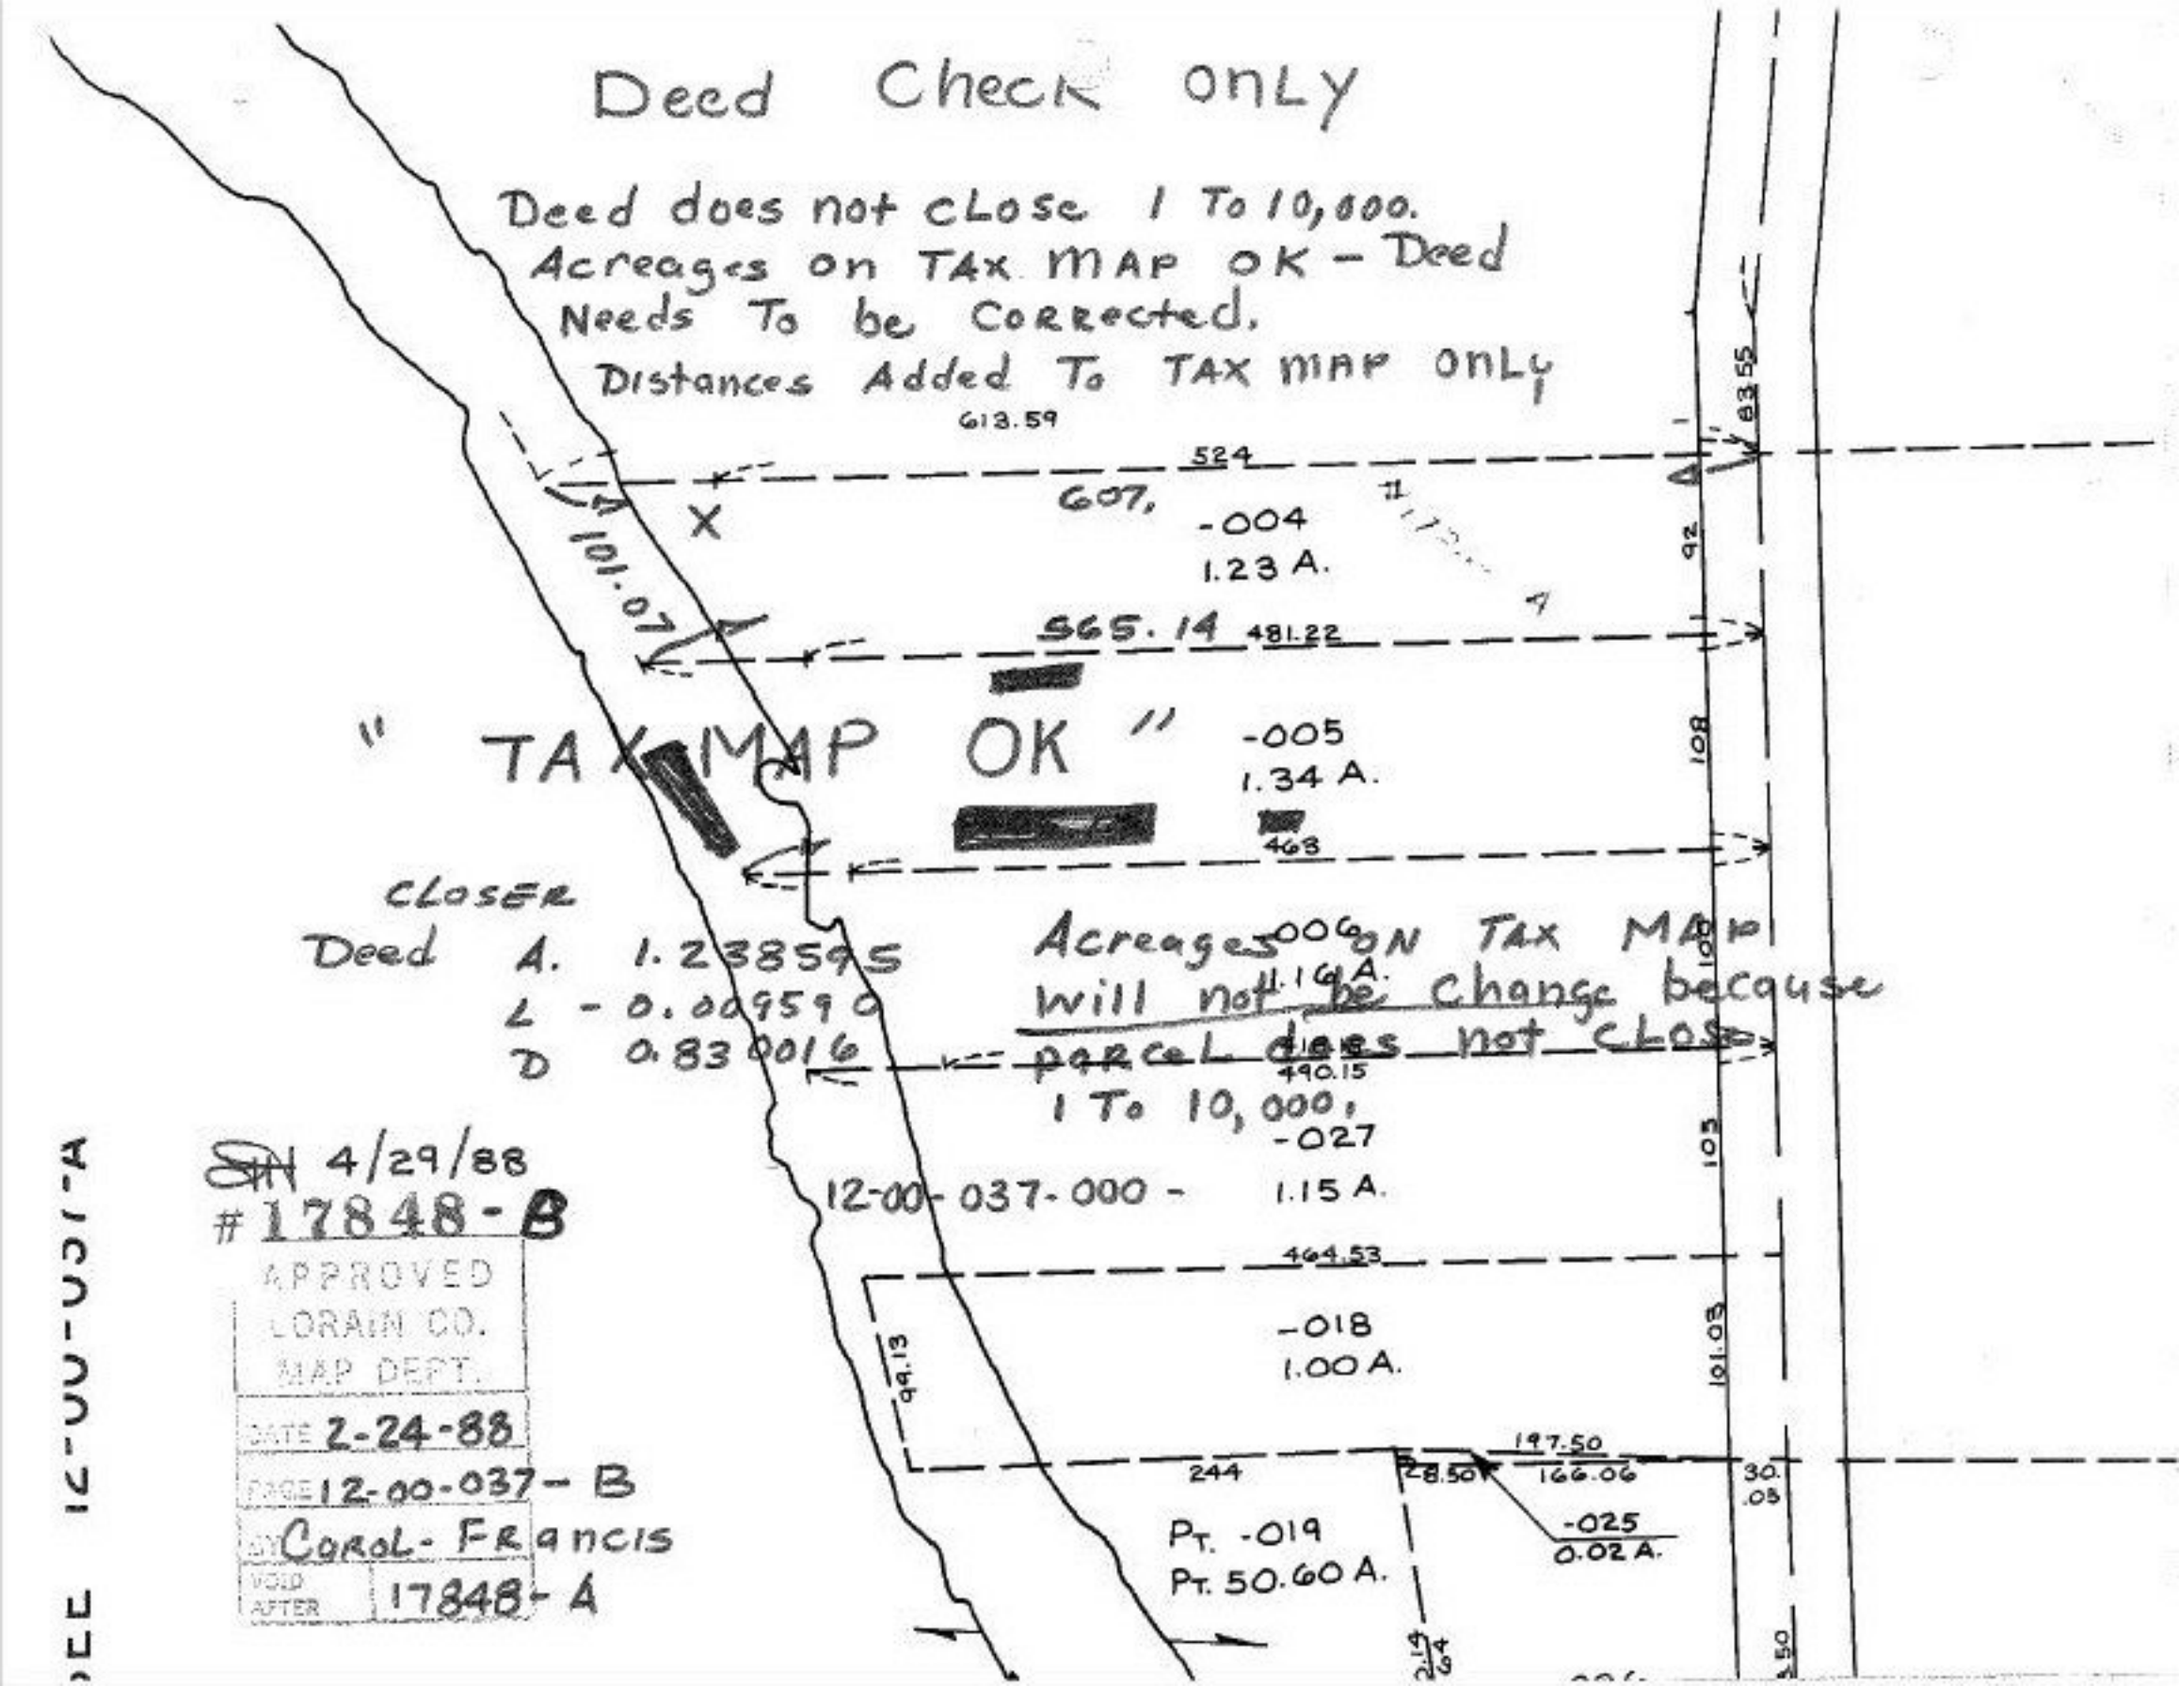
Deed Check ONLY
Deed does not close 1 To 10,000.
Acreages on TAX MAP OK - Deed
Needs To be Corrected.
Distances Added To TAX MAP ONLY
613.59
524
607.
-004
1.23 A.
101.07
565.14
481.22
" TAX MAP OK "
-005
1.34 A.
468
CLOSER
Deed A. 1.238595
L - 0.004590
D 0.830016
Acreages on TAX MAP
will not be change because
parcel does not CLOSE
1 To 10,000.
-006
1.19 A.
490.15
-027
1.15 A.
12-00-037-000 -
464.53
-018
1.00 A.
99.13
244
28.50
197.50
166.06
-025
0.02 A.
Pt. -019
Pt. 50.60 A.
4/29/88
#17848-B
APPROVED
LORAIN CO.
MAP DEPT.
DATE 2-24-88
PAGE 12-00-037-B
BY CAROL-FRANCIS
VOID AFTER 17848-A
12-00-037-A