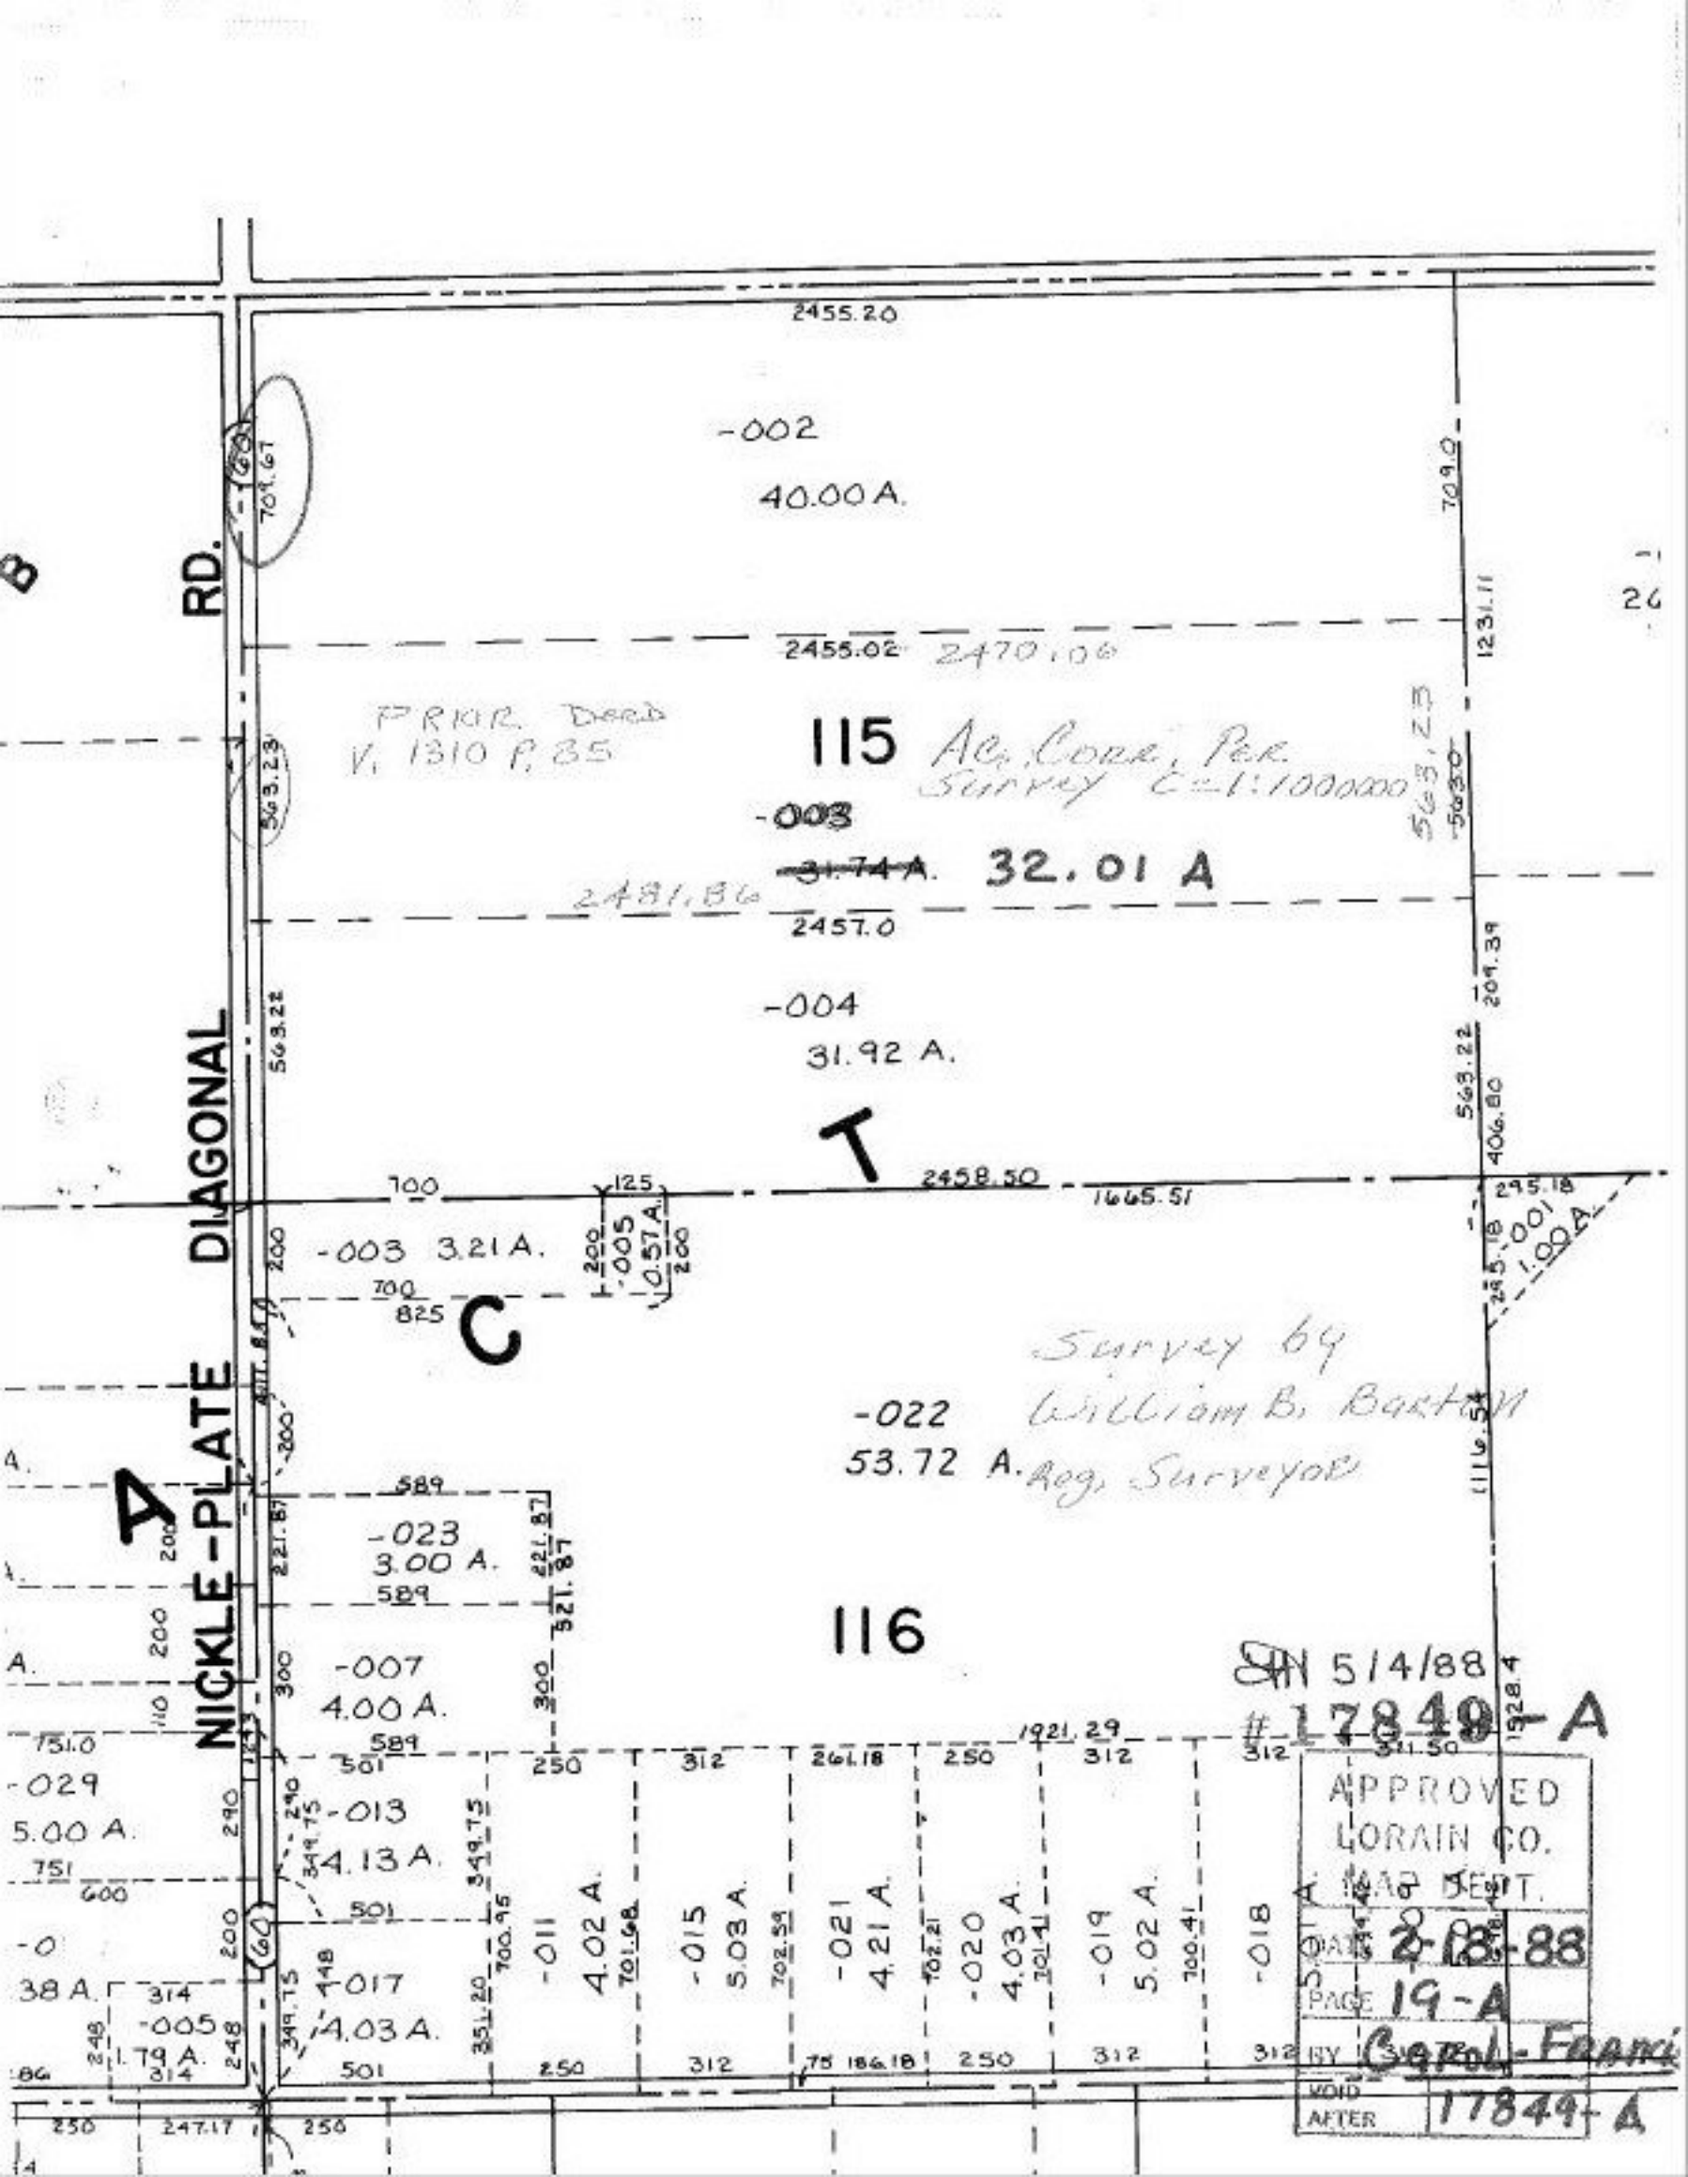
2455.20
-002
40.00 A.
709.0
1231.11
RD.
DIAGONAL
NICKLE-PLATE
2455.02
2470.06
PRIOR DEED
V. 1310 P. 85
115
AG. CORR. PER.
SURVEY C-1:1000200
563.23
-003
31.74 A.
32.01 A
2481.86
2457.0
-004
31.92 A.
563.22
209.39
406.80
T
700
125
2458.50
1665.51
295.18
-005
0.57 A.
-003 3.21 A.
825
C
Survey by
William B. Barton
Reg. Surveyor
-022
53.72 A.
589
-023
3.00 A.
221.87
116
-007
4.00 A.
751.0
-029
5.00 A.
-013
4.13 A.
-017
4.03 A.
-005
1.79 A.
-011
4.02 A.
-015
5.03 A.
-021
4.21 A.
-020
4.03 A.
-019
5.02 A.
-018
5.01 A.
1928.4
1921.29
261.18
349.75
700.95
701.68
702.59
702.21
701.41
700.41
351.20
247.17
5/4/88
#17849-A
APPROVED
LORAIN CO.
MAP DEPT.
DATE 2-28-88
PAGE 19-A
BY Carol-Franci
VOID
AFTER 17849-A