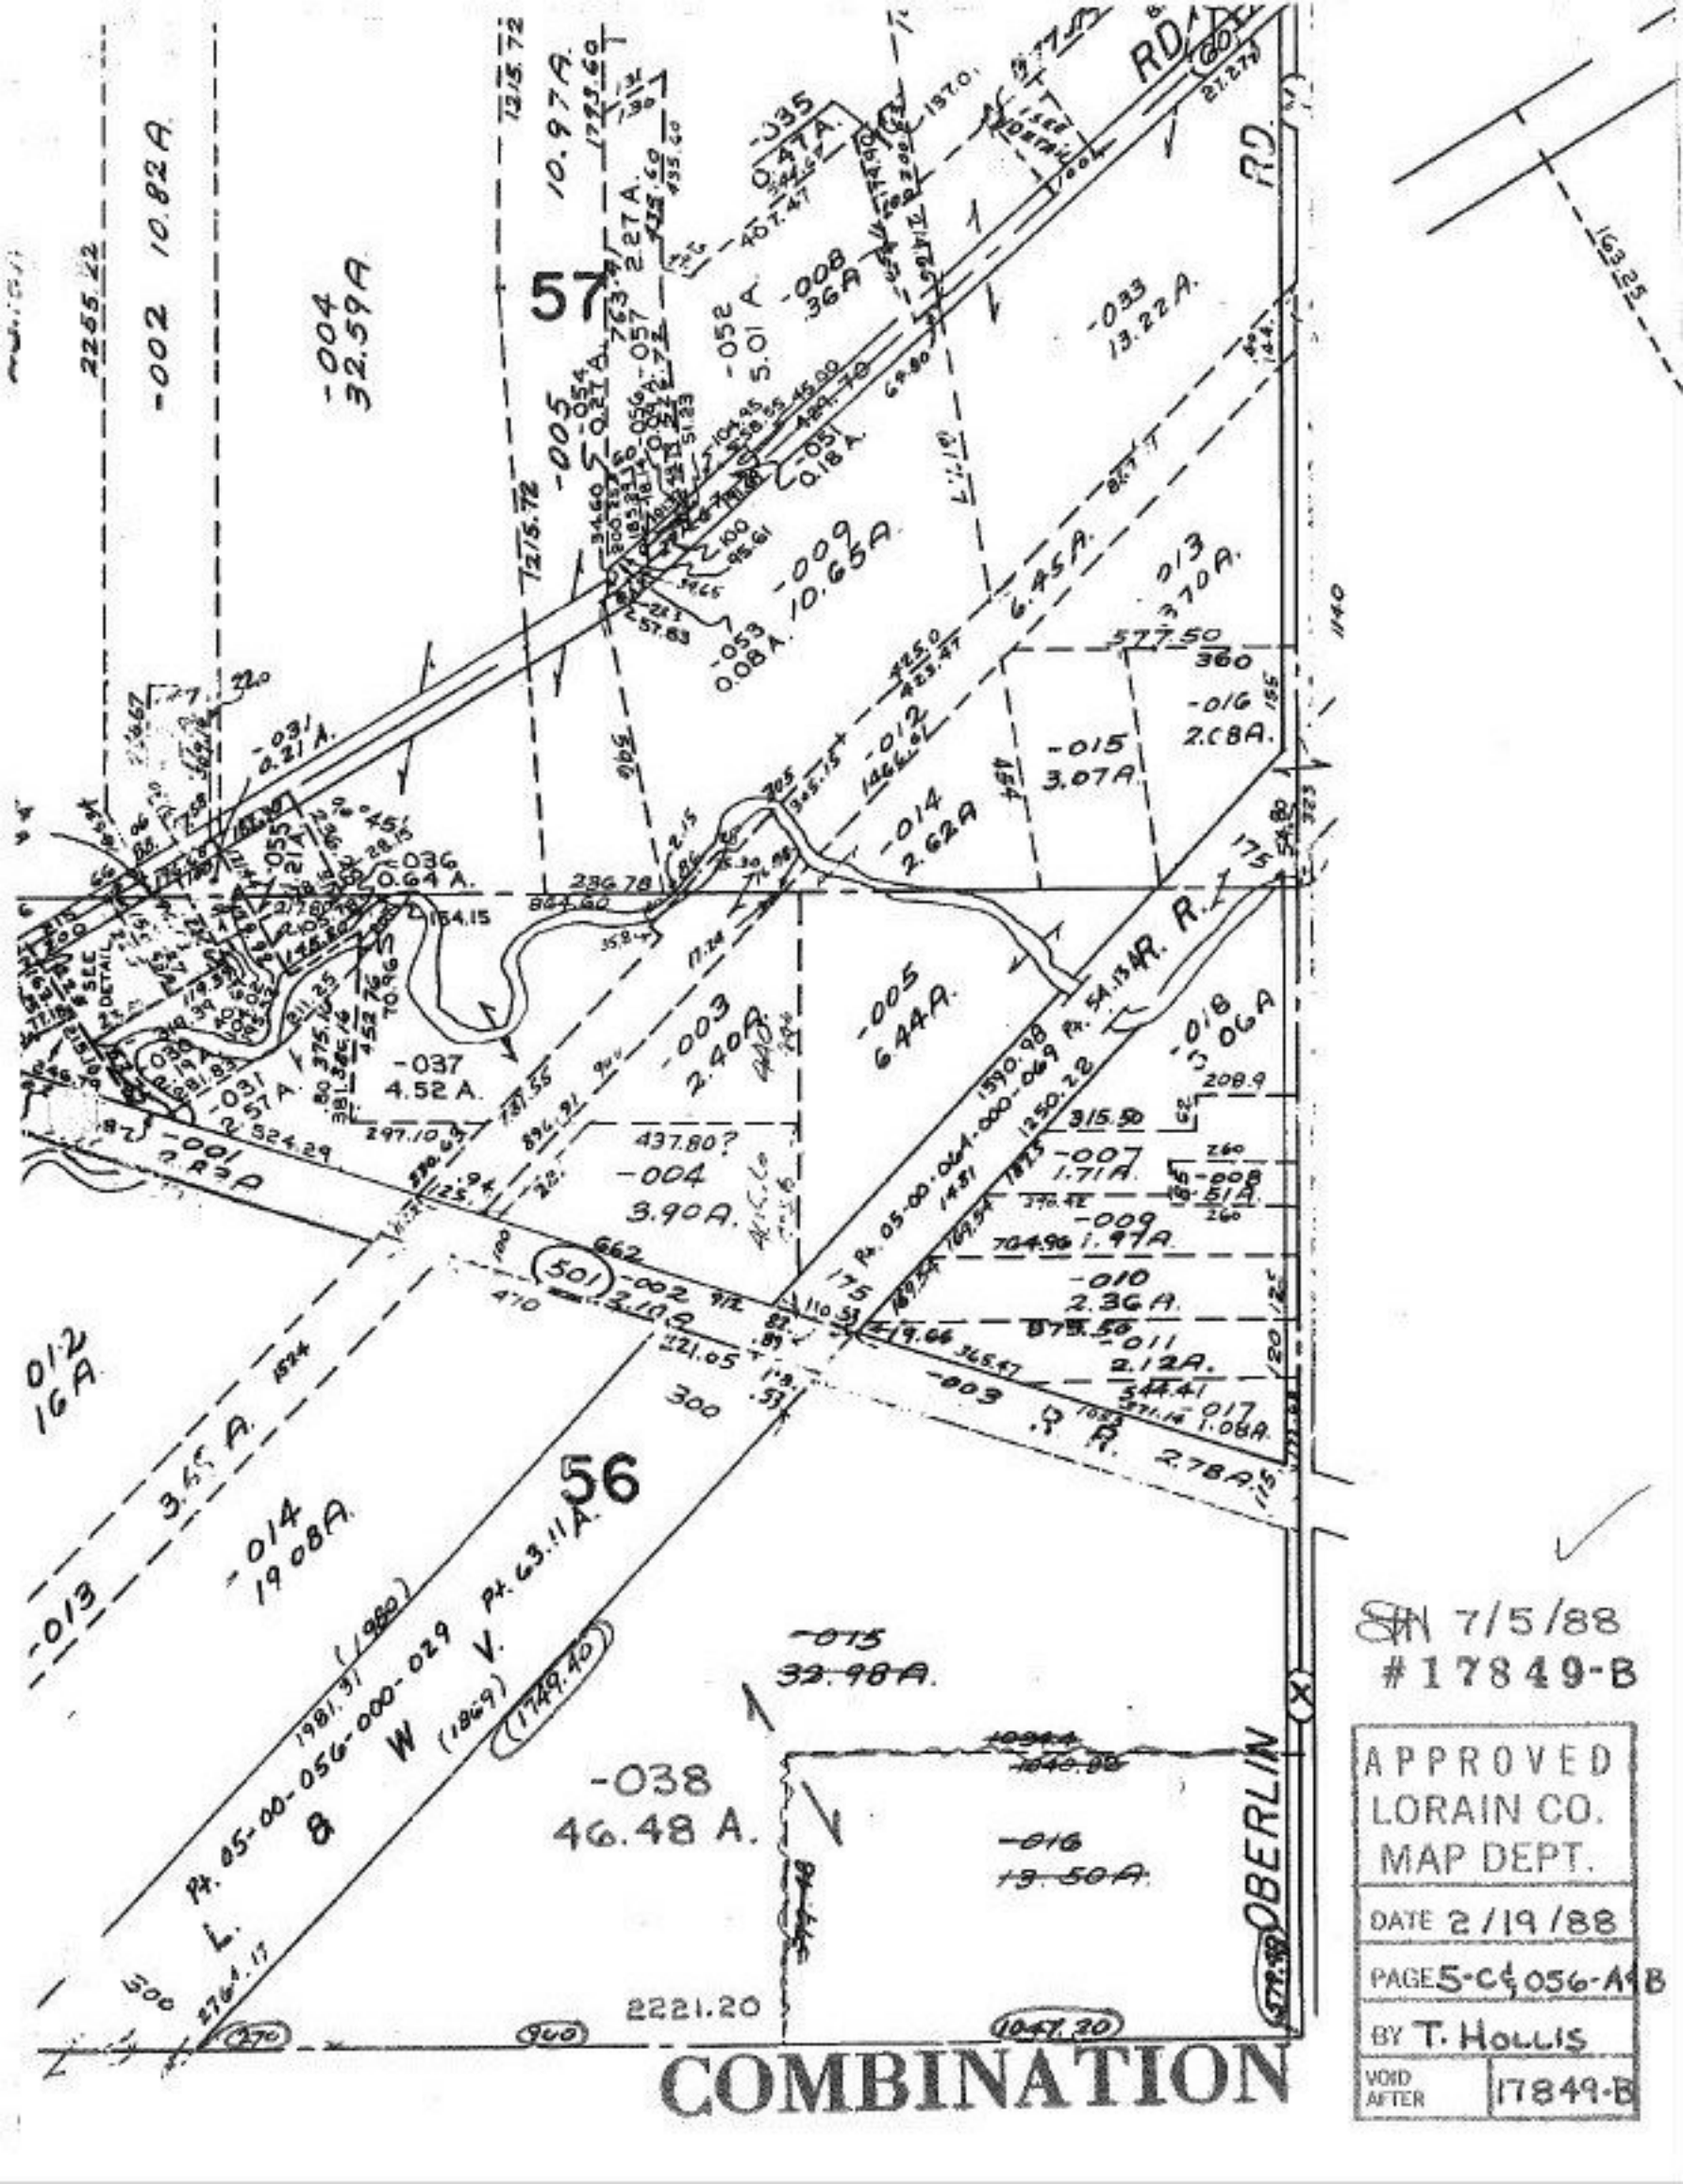

SJN 7/5/88
#17849-B

APPROVED
LORAIN CO.
MAP DEPT.

DATE 2/19/88

PAGE 5-C & 056-A & B

BY T. HOLLIS

VOID AFTER 17849-B