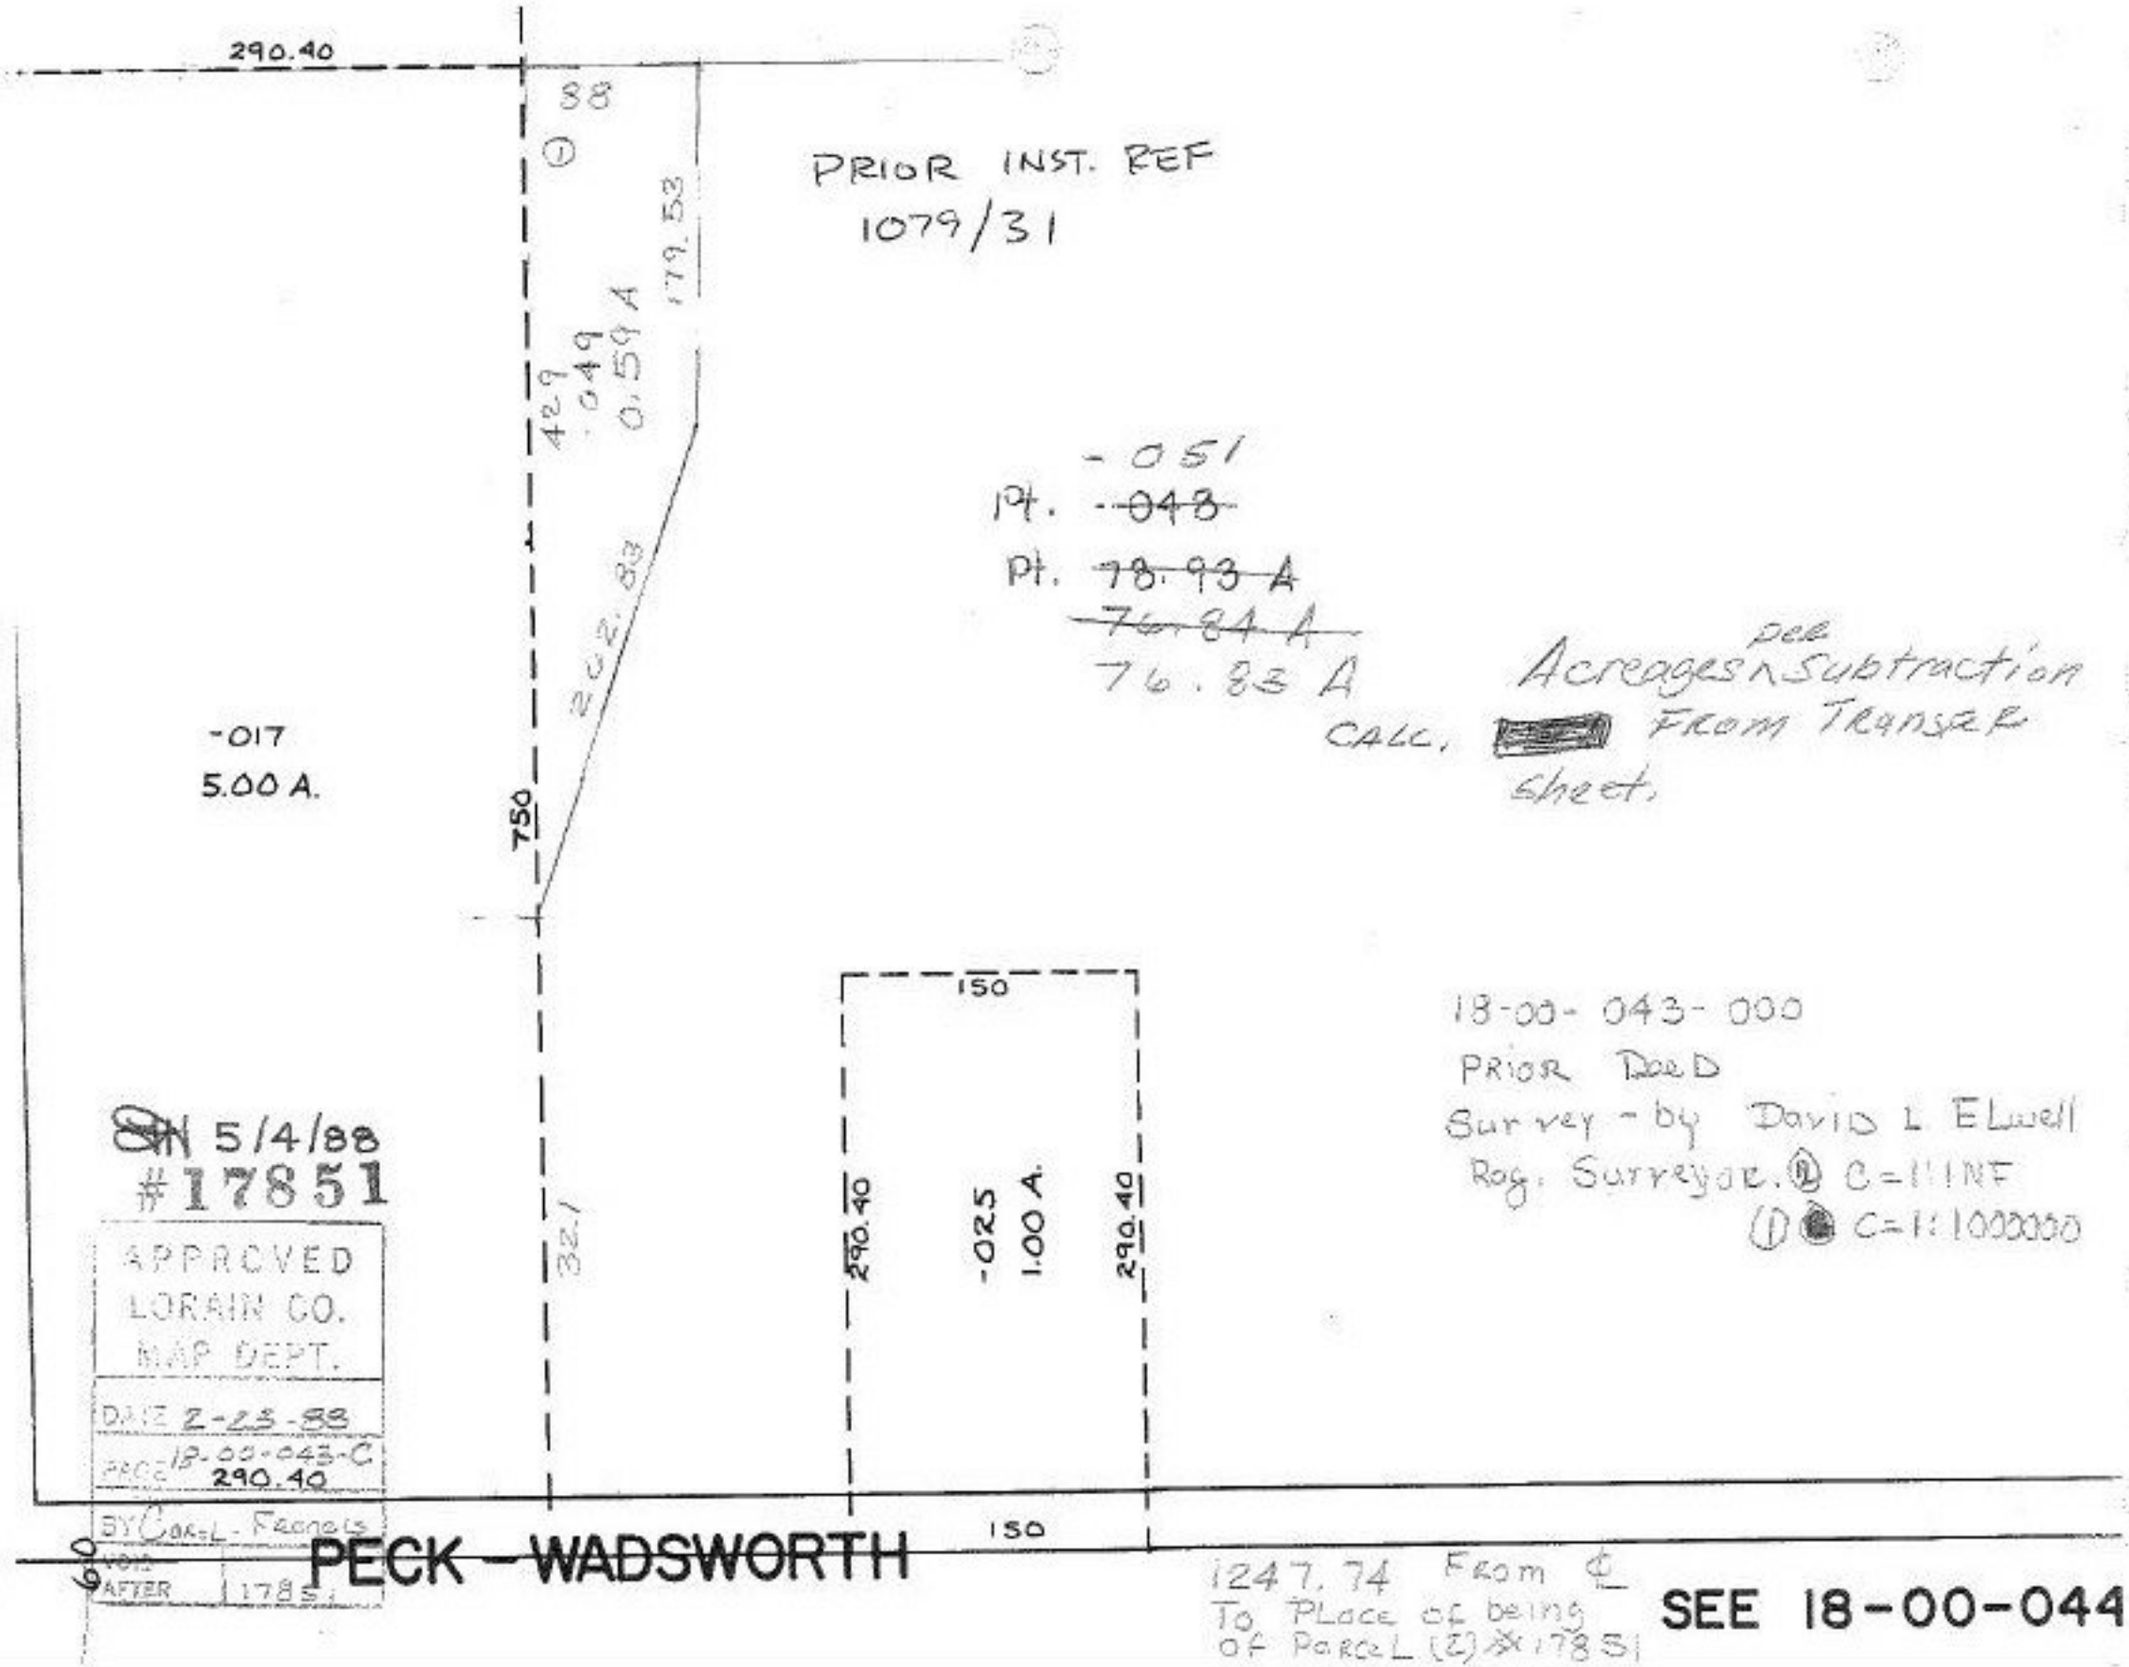
290.40
88
①
PRIOR INST. REF
1079/31
179.53
429
.049
0.59 A
-051
Pt. ~~-048~~
Pt. ~~78.93 A~~
~~76.84 A~~
76.83 A
Acreages per Subtraction
CALC. [redacted] FROM TRANSFER
sheet.
202.83
-017
5.00 A.
750
150
18-00-043-000
PRIOR DEED
Survey - by David L Elwell
Reg. Surveyor. ② C=1:1NF
① C=1:1000000
5/4/88
#17851
APPROVED
LORAIN CO.
MAP DEPT.
DATE 2-23-88
PAGE 18-00-043-C
290.40
BY Carol Francis
VOID
AFTER 17851
321
290.40
-025
1.00 A.
290.40
150
PECK - WADSWORTH
1247.74 From ℄
To Place of being
of Parcel (2) #17851
SEE 18-00-044