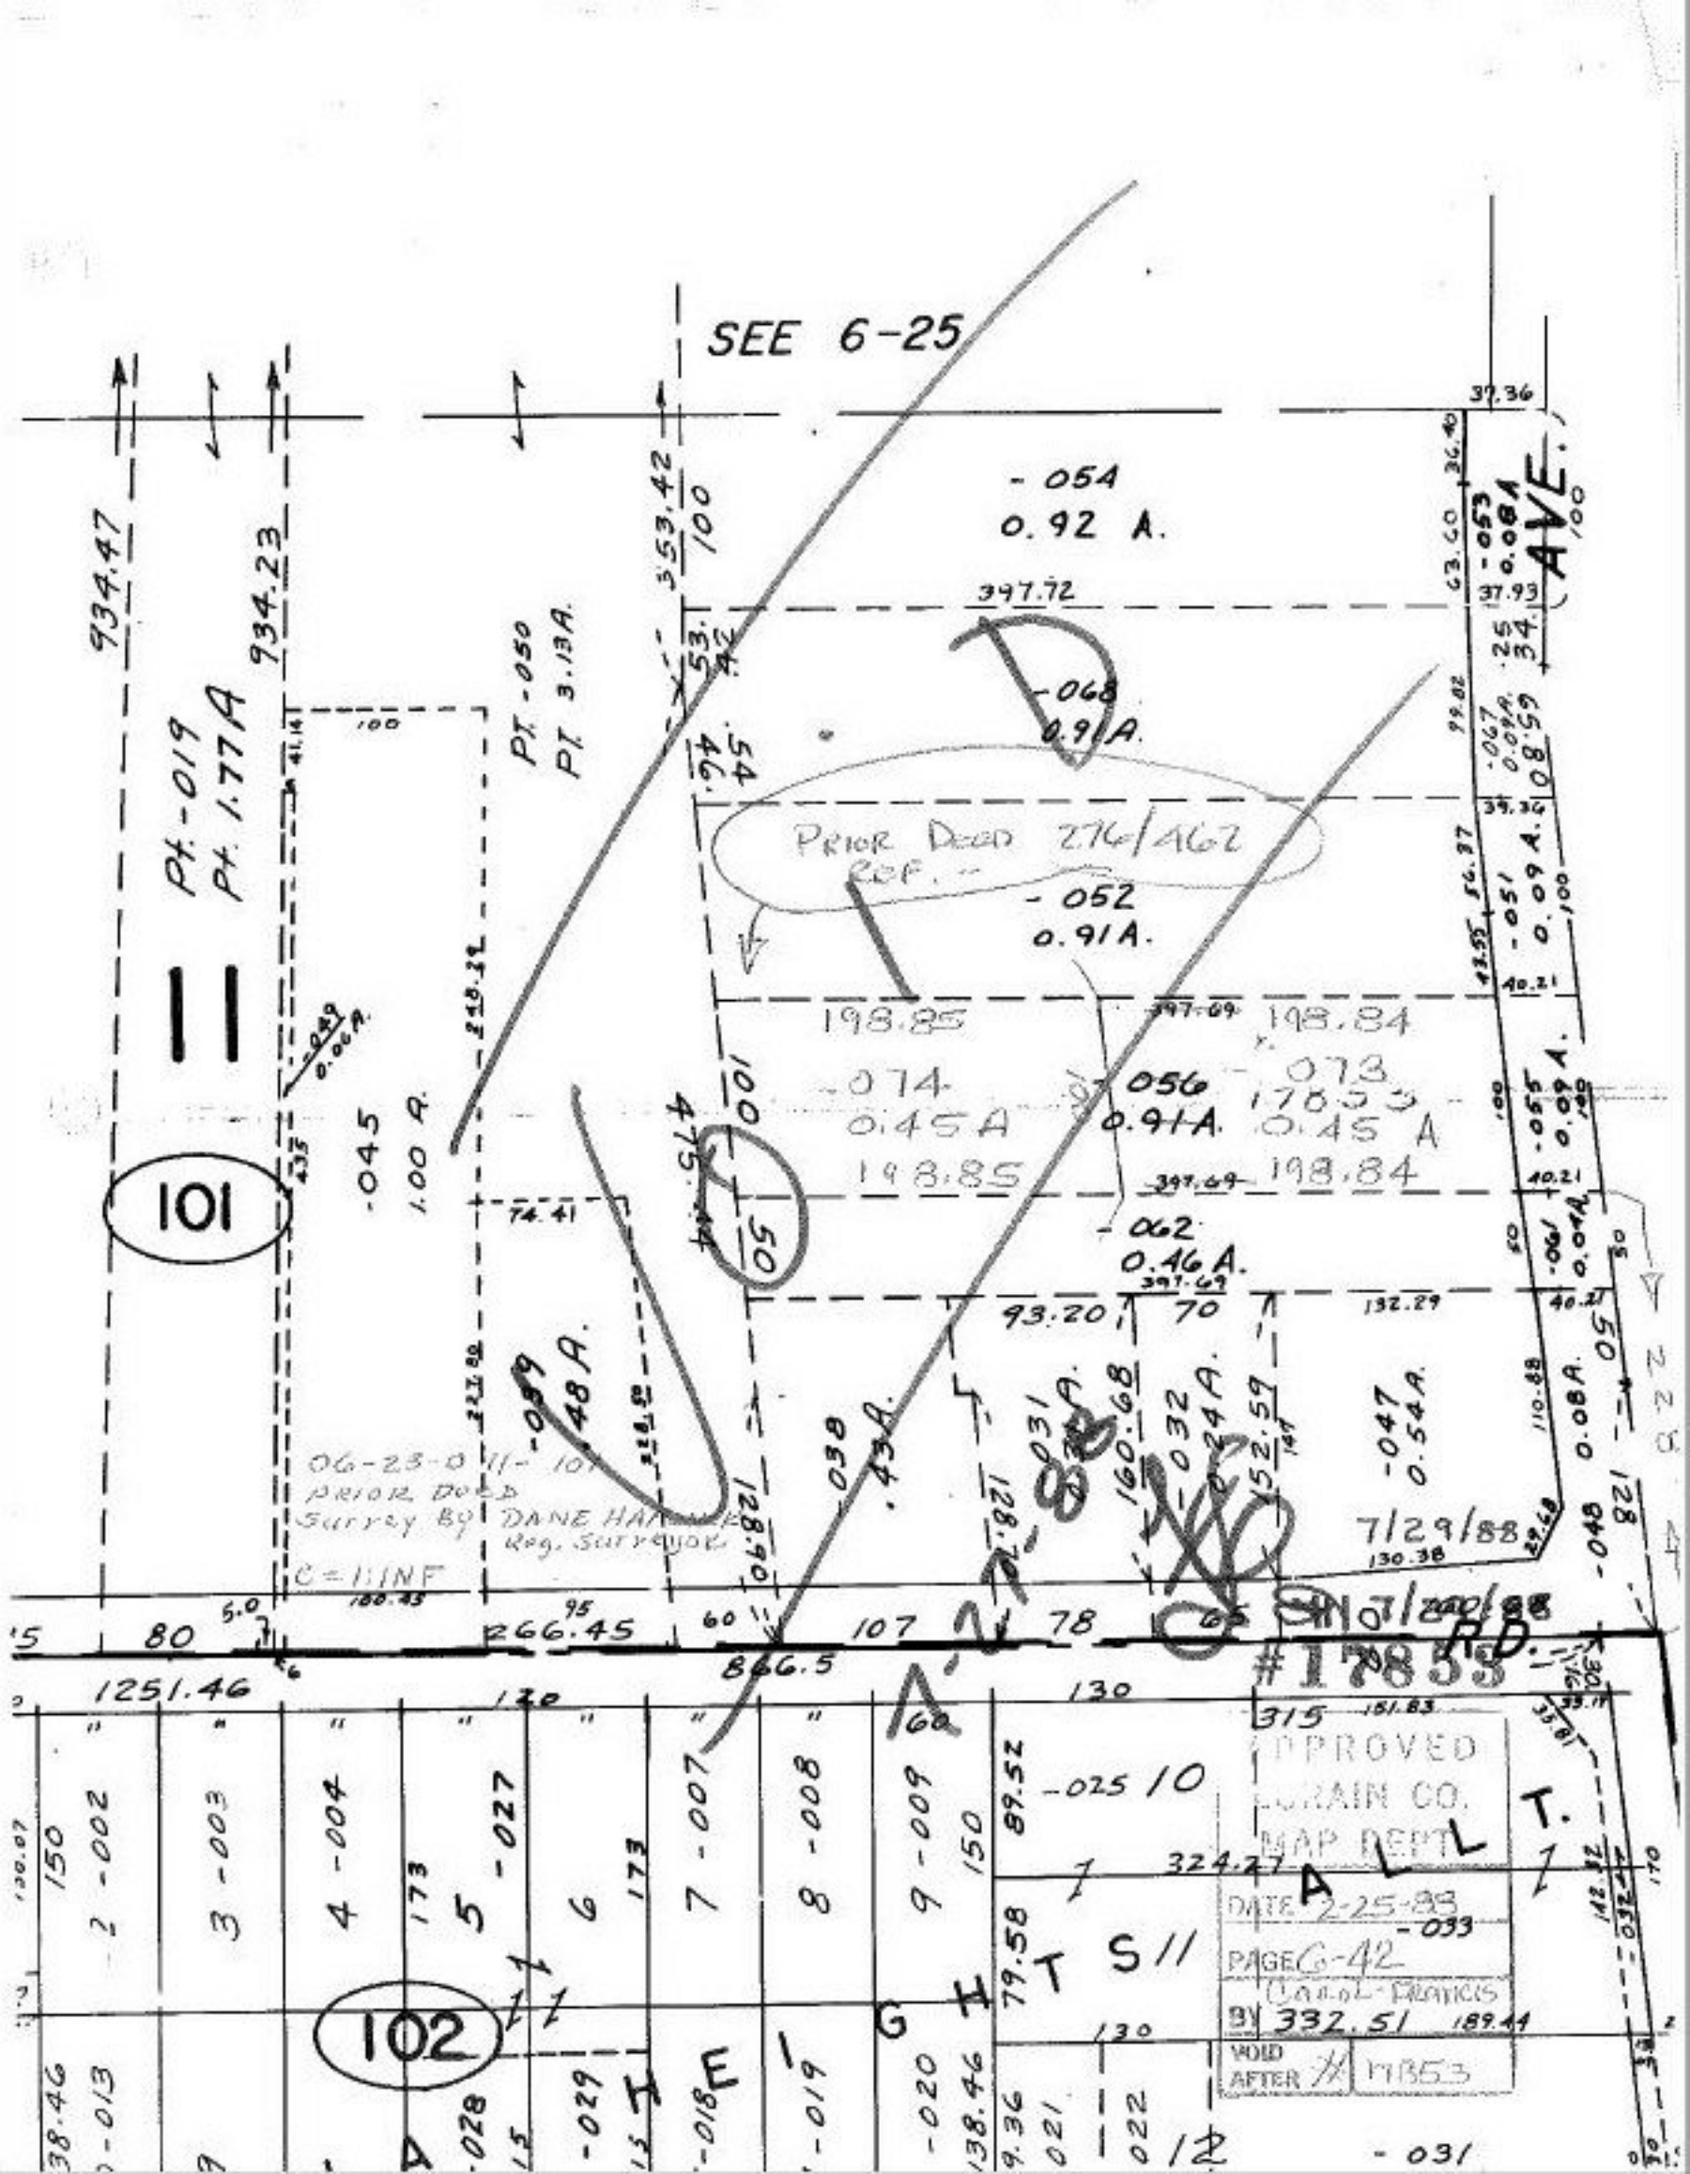
SEE 6-25
101
102
Pt.-019
Pt. 1.77A
PT.-050
PT. 3.13A.
-054
0.92 A.
-068
0.91A.
PRIOR DEED 276/462
REF.
-052
0.91A.
198.85
-074
0.45A
198.85
-056
0.91A.
198.84
-073
0.45 A
198.84
-062
0.46 A.
-045
1.00 A.
-039
.48A.
-038
.43A.
-047
0.54A.
06-23-011-101
PRIOR DEED
Survey By DANE HA
Reg. Surveyor
C=1:1NF
7/29/88
#17853
APPROVED
LORAIN CO.
MAP DEPT.
DATE 2-25-88
PAGE 6-42
BY CAROL FRANCIS
VOID AFTER 17853
HEIGHTS ALLT.
AVE.
RD.
1251.46
866.5
266.45
324.27
332.51
189.44
-025
-033
-031