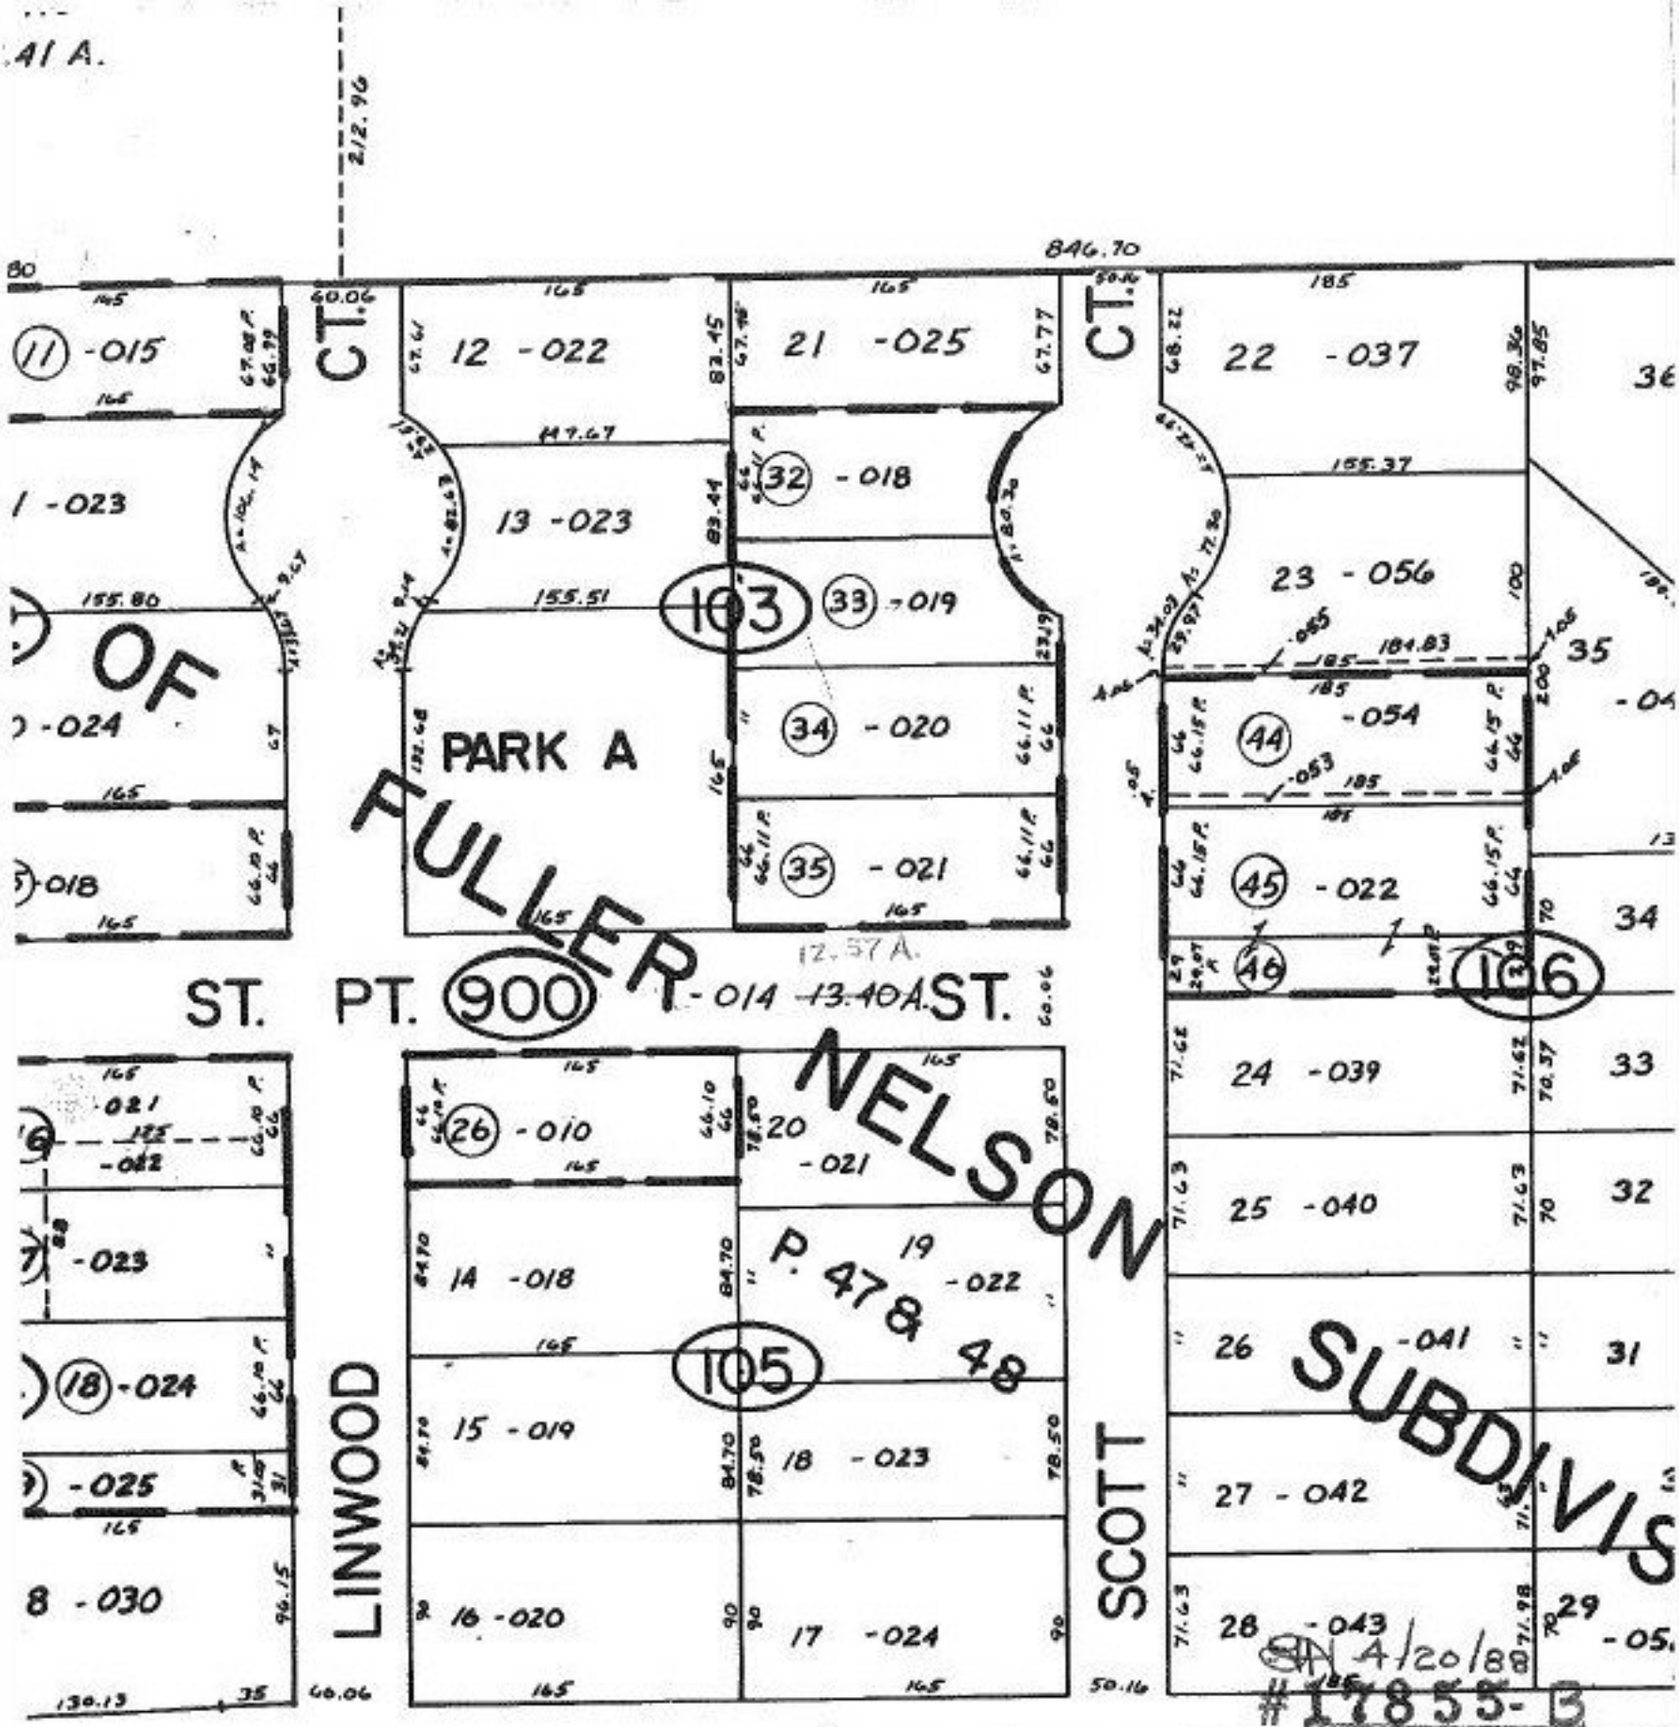

SEE 10-00-004-E

13.40
-0.83
12.57

ACRG. CORR.
DUE TO
ST. VAC.

4/20/88
#17855-B

APPROVED
LORAIN CO.
MAP DEPT.
DATE 3-1-88
PAGE 10-00-004-A
BY T. McNair
VOID AFTER 17855-B