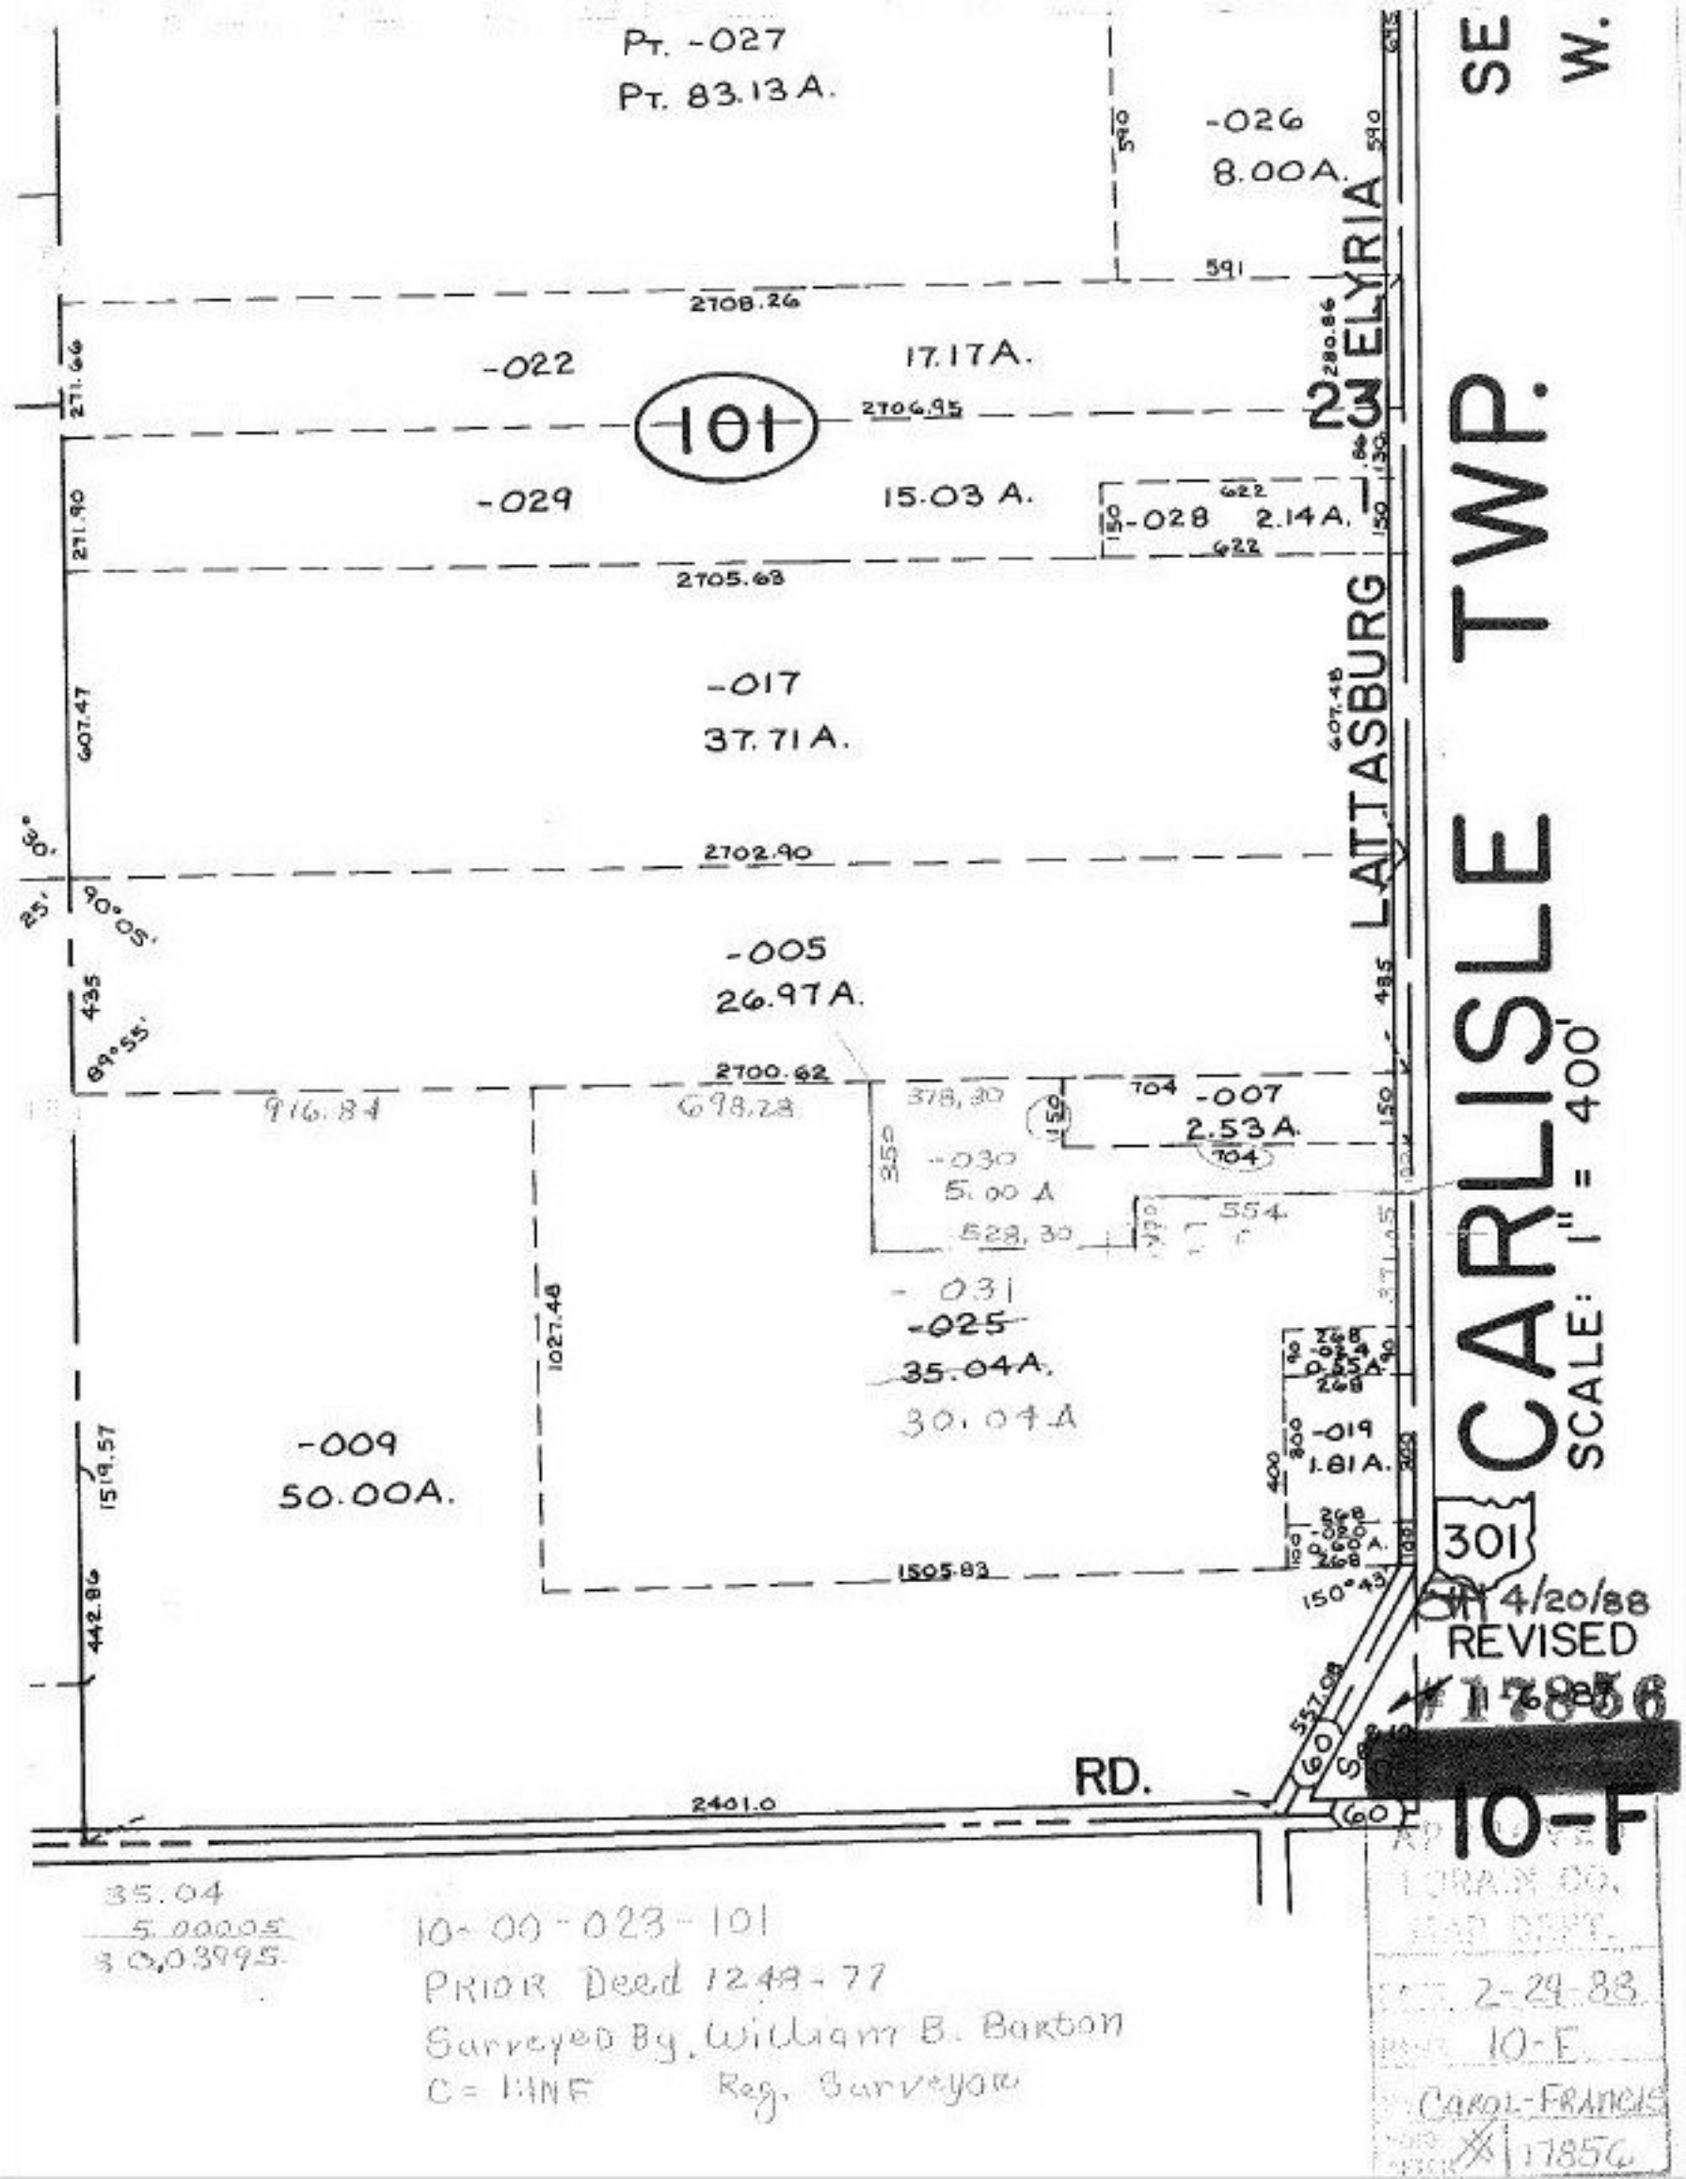

35.04
5.00005
30.03995

10-00-023-101
PRIOR Deed 1248-77
Surveyed By. William B. Barton
C = 1:NF Reg. Surveyor

LORAIN CO.
ROAD DEPT.
2-29-88
10-E
CAROL-FRANCIS
17856