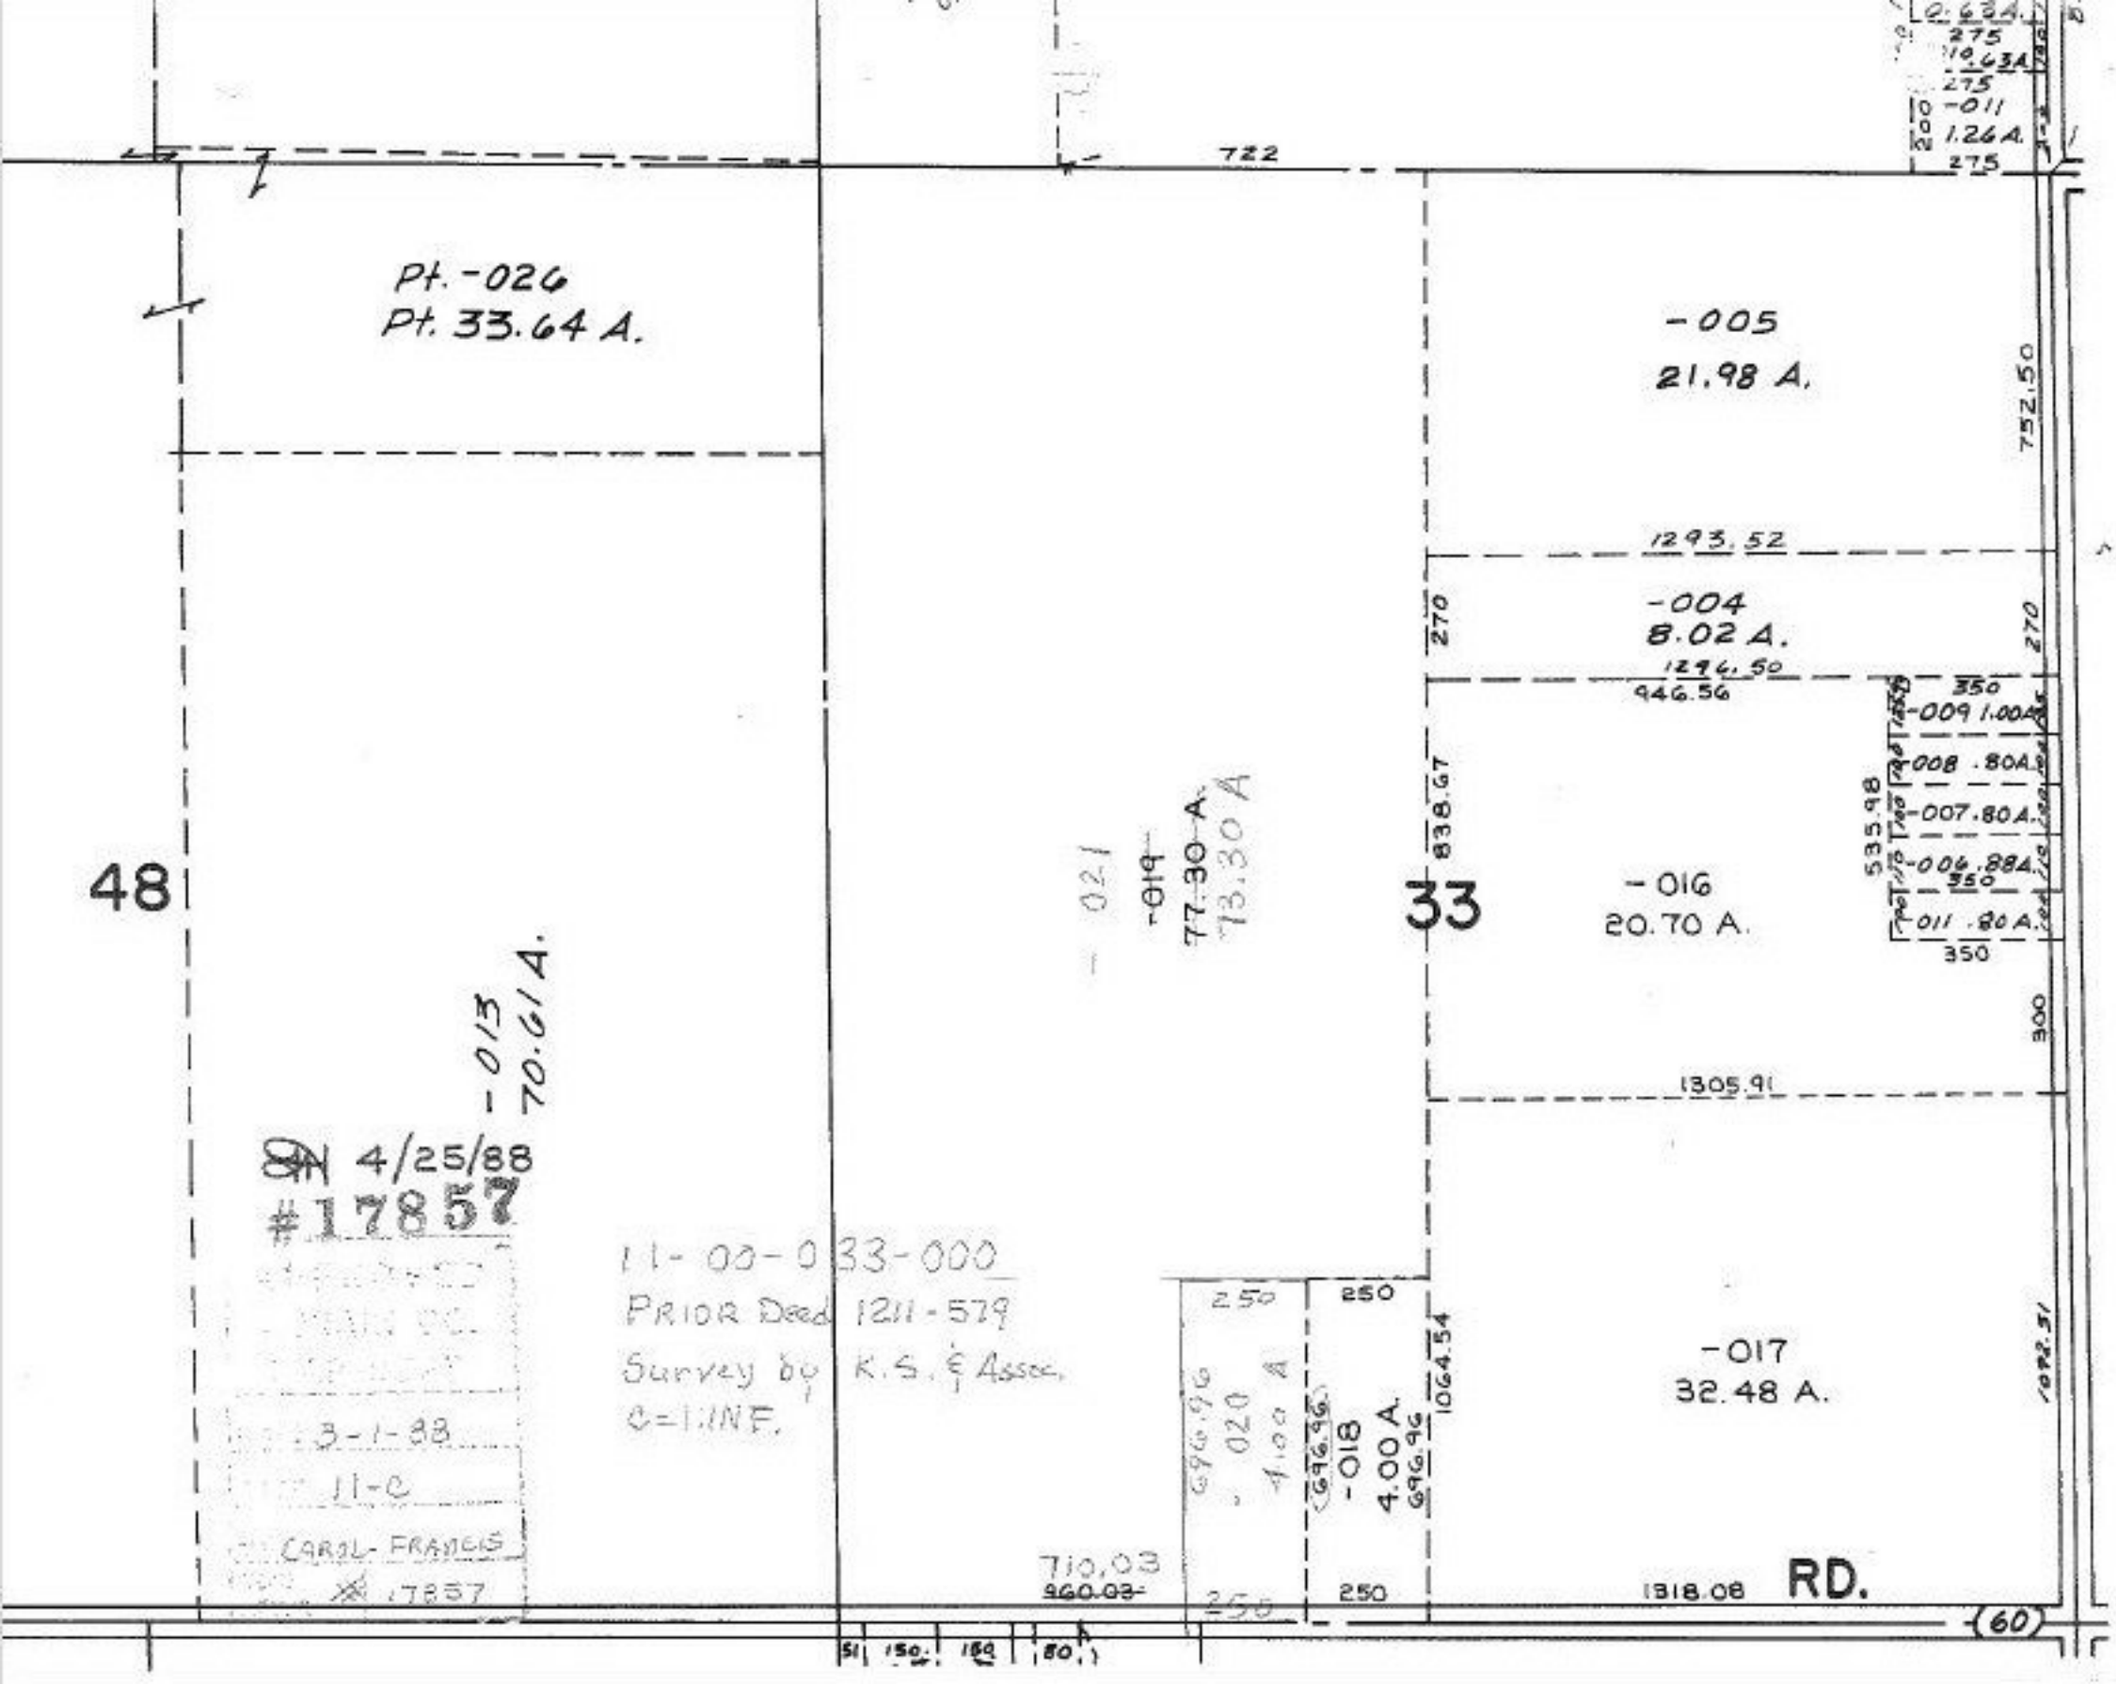
722
Pt. -026
Pt. 33.64 A.
-005
21.98 A.
752.50
1293.52
-004
8.02 A.
270
1296.50
946.56
350
-009 1.00A.
-008 .80A.
-007 .80A.
-006 .884
-011 .80A.
535.98
838.67
48
33
-016
20.70 A.
-021
-019
77.30 A.
73.30 A
-013
70.61 A.
300
1305.91
4/25/88
#17857
11-00-033-000
PRIOR Deed 1211-579
Survey by K.S. & Assoc.
C=1.INF.
3-1-88
11-C
CAROL-FRANCIS
#17857
710.03
960.03
250
696.96
-020
4.00 A.
-018
4.00 A.
1064.54
-017
32.48 A.
1072.31
1318.08
RD.
60
51
150
150
180