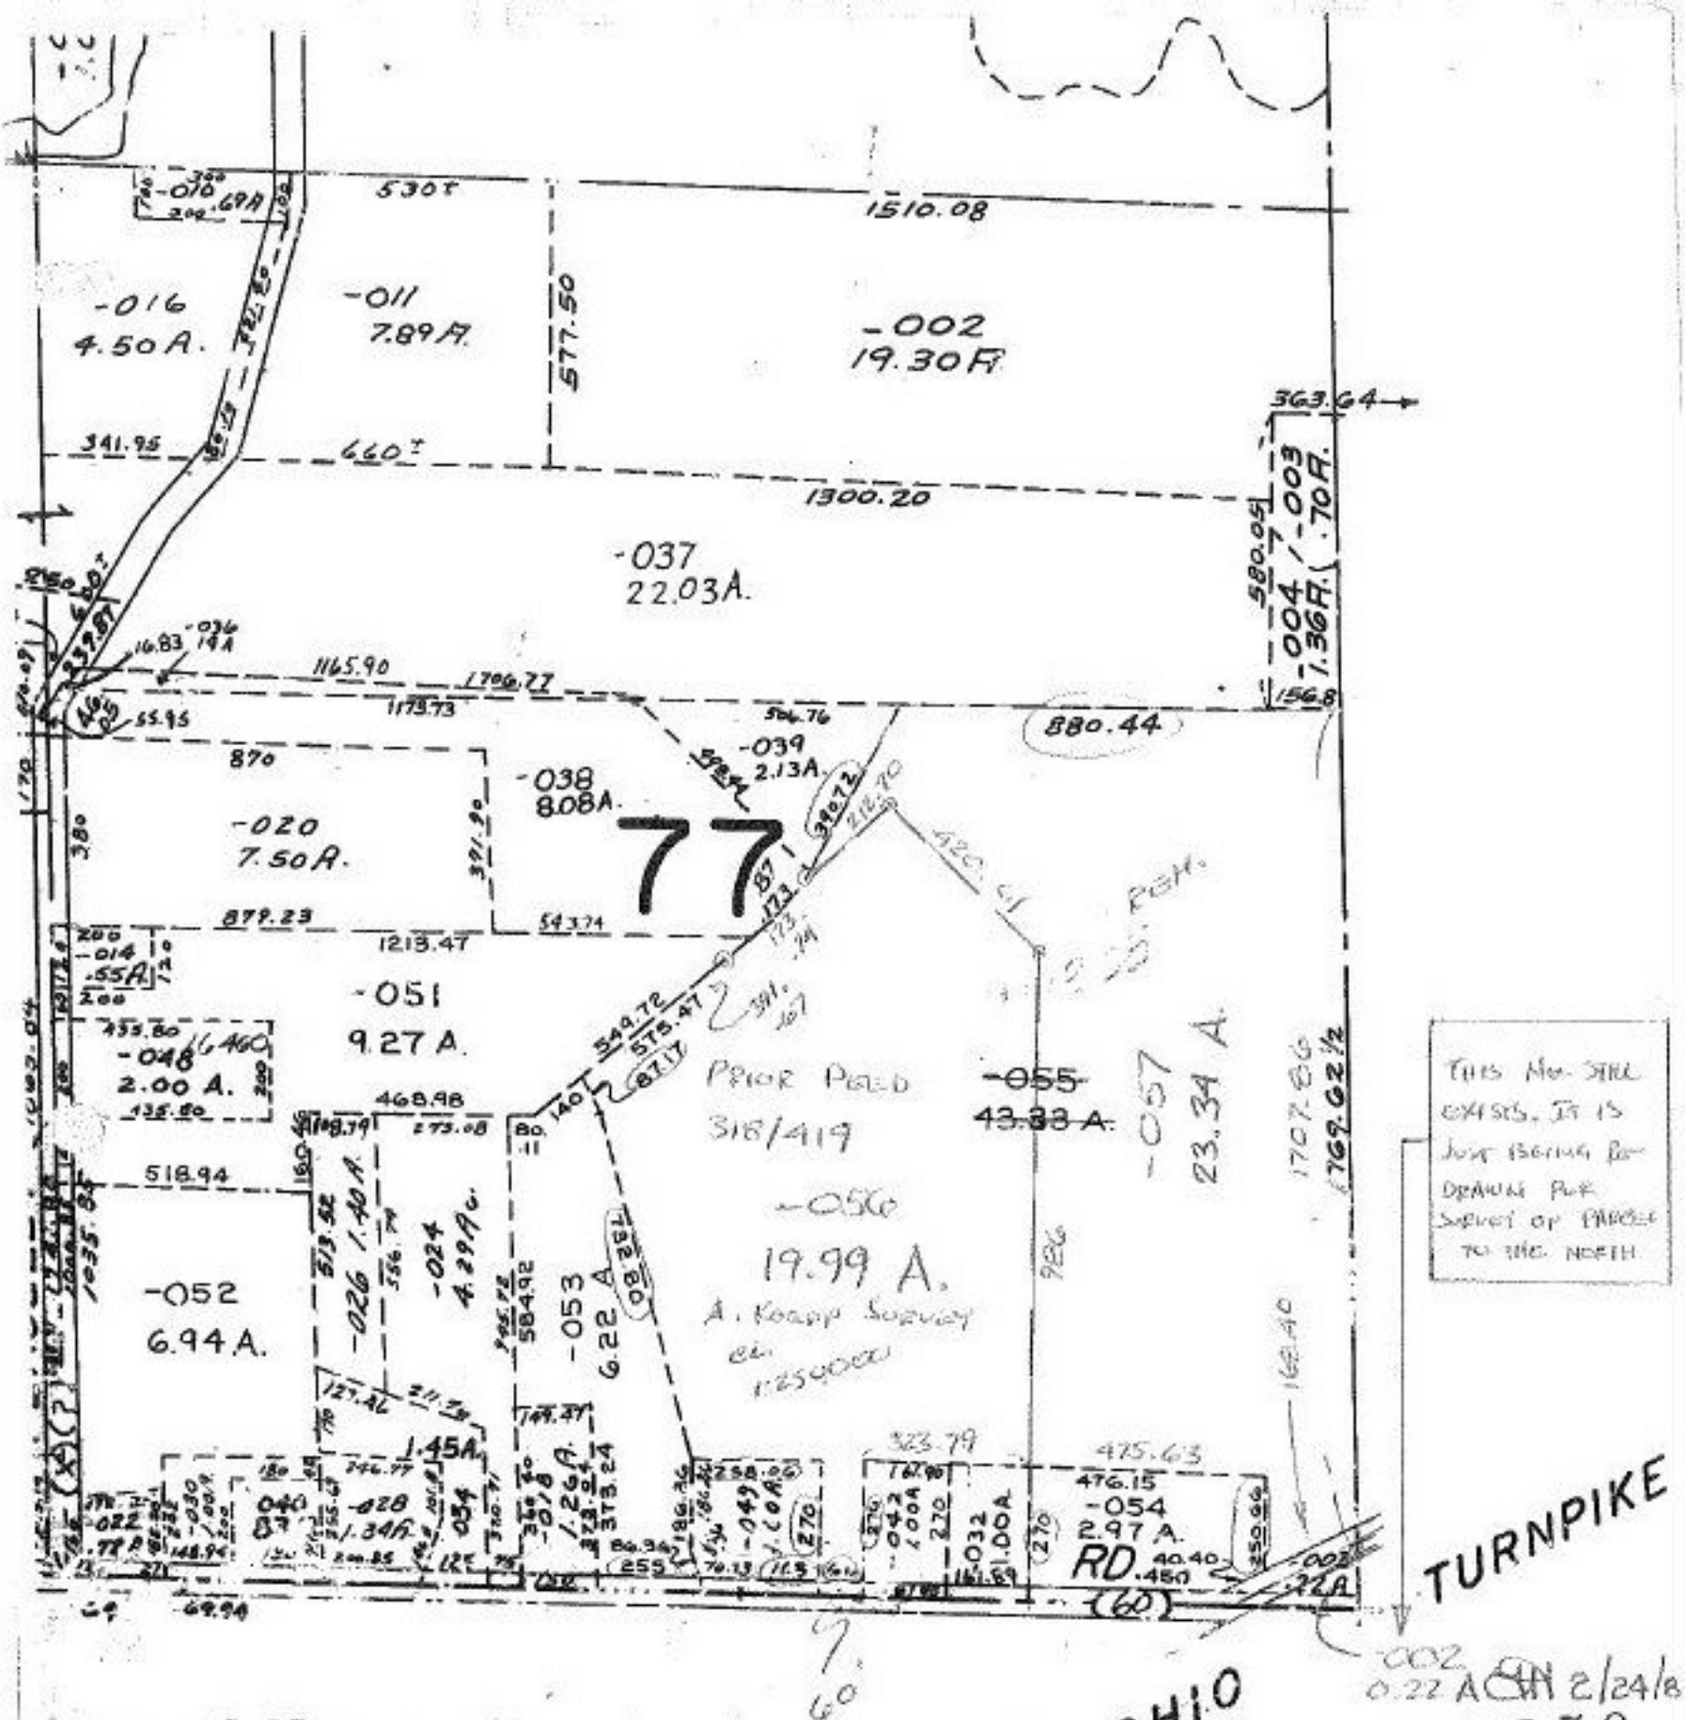

43.33
19.99
23.34

P.

LOTS 51, 52, 61, 62
67, 68, 77, 78

#17858

APPROVED
LORAIN CO.
MAP DEPT.

DATE 7-5-88

PAGE 1-J

BY T. McNair

VOID AFTER 17858