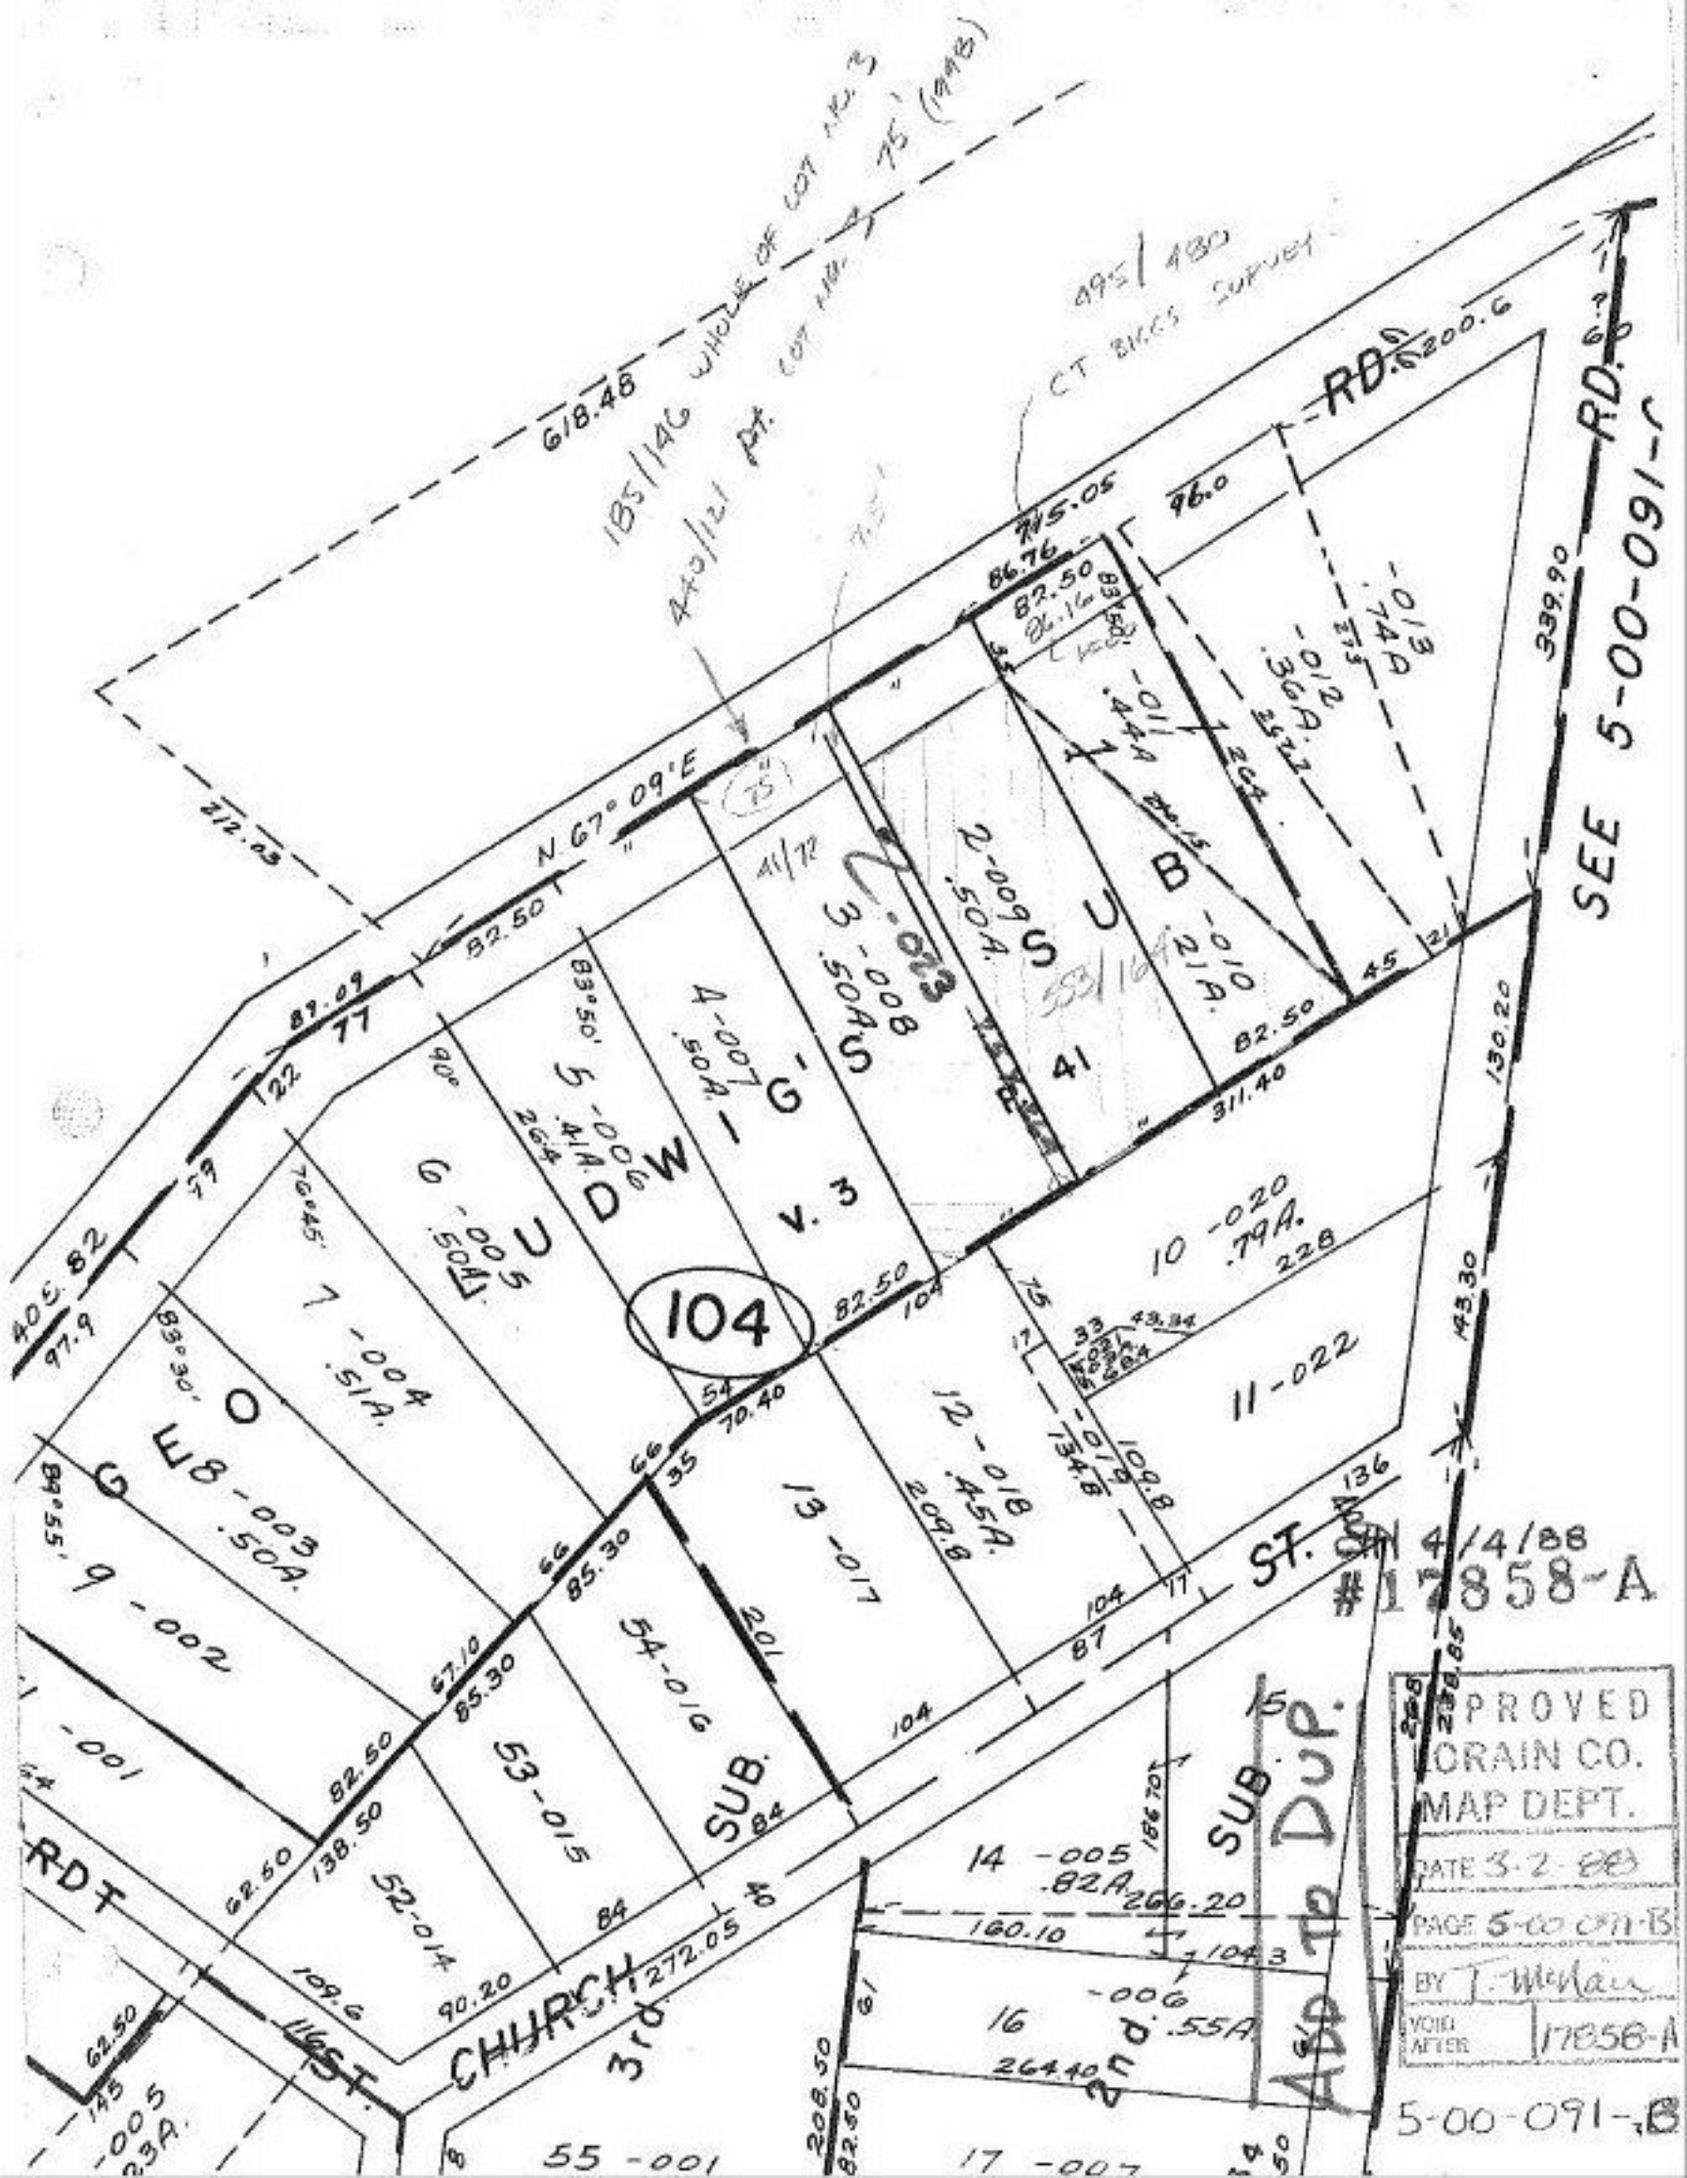

SEE 5-00-091-C
RD.
N. 67° 09' E
104
EUDWIG'S SUB
V. 3
GEO
ST.
CHURCH
3rd
2nd
SUB.
ADD TO DUP.
SUB.
RDT
ST.
4/4/88
#17858-A
PROVED
CRAIN CO.
MAP DEPT.
DATE 3-2-88
PAGE 5-00-091-B
BY T. McNair
VOID AFTER 17858-A
5-00-091-B