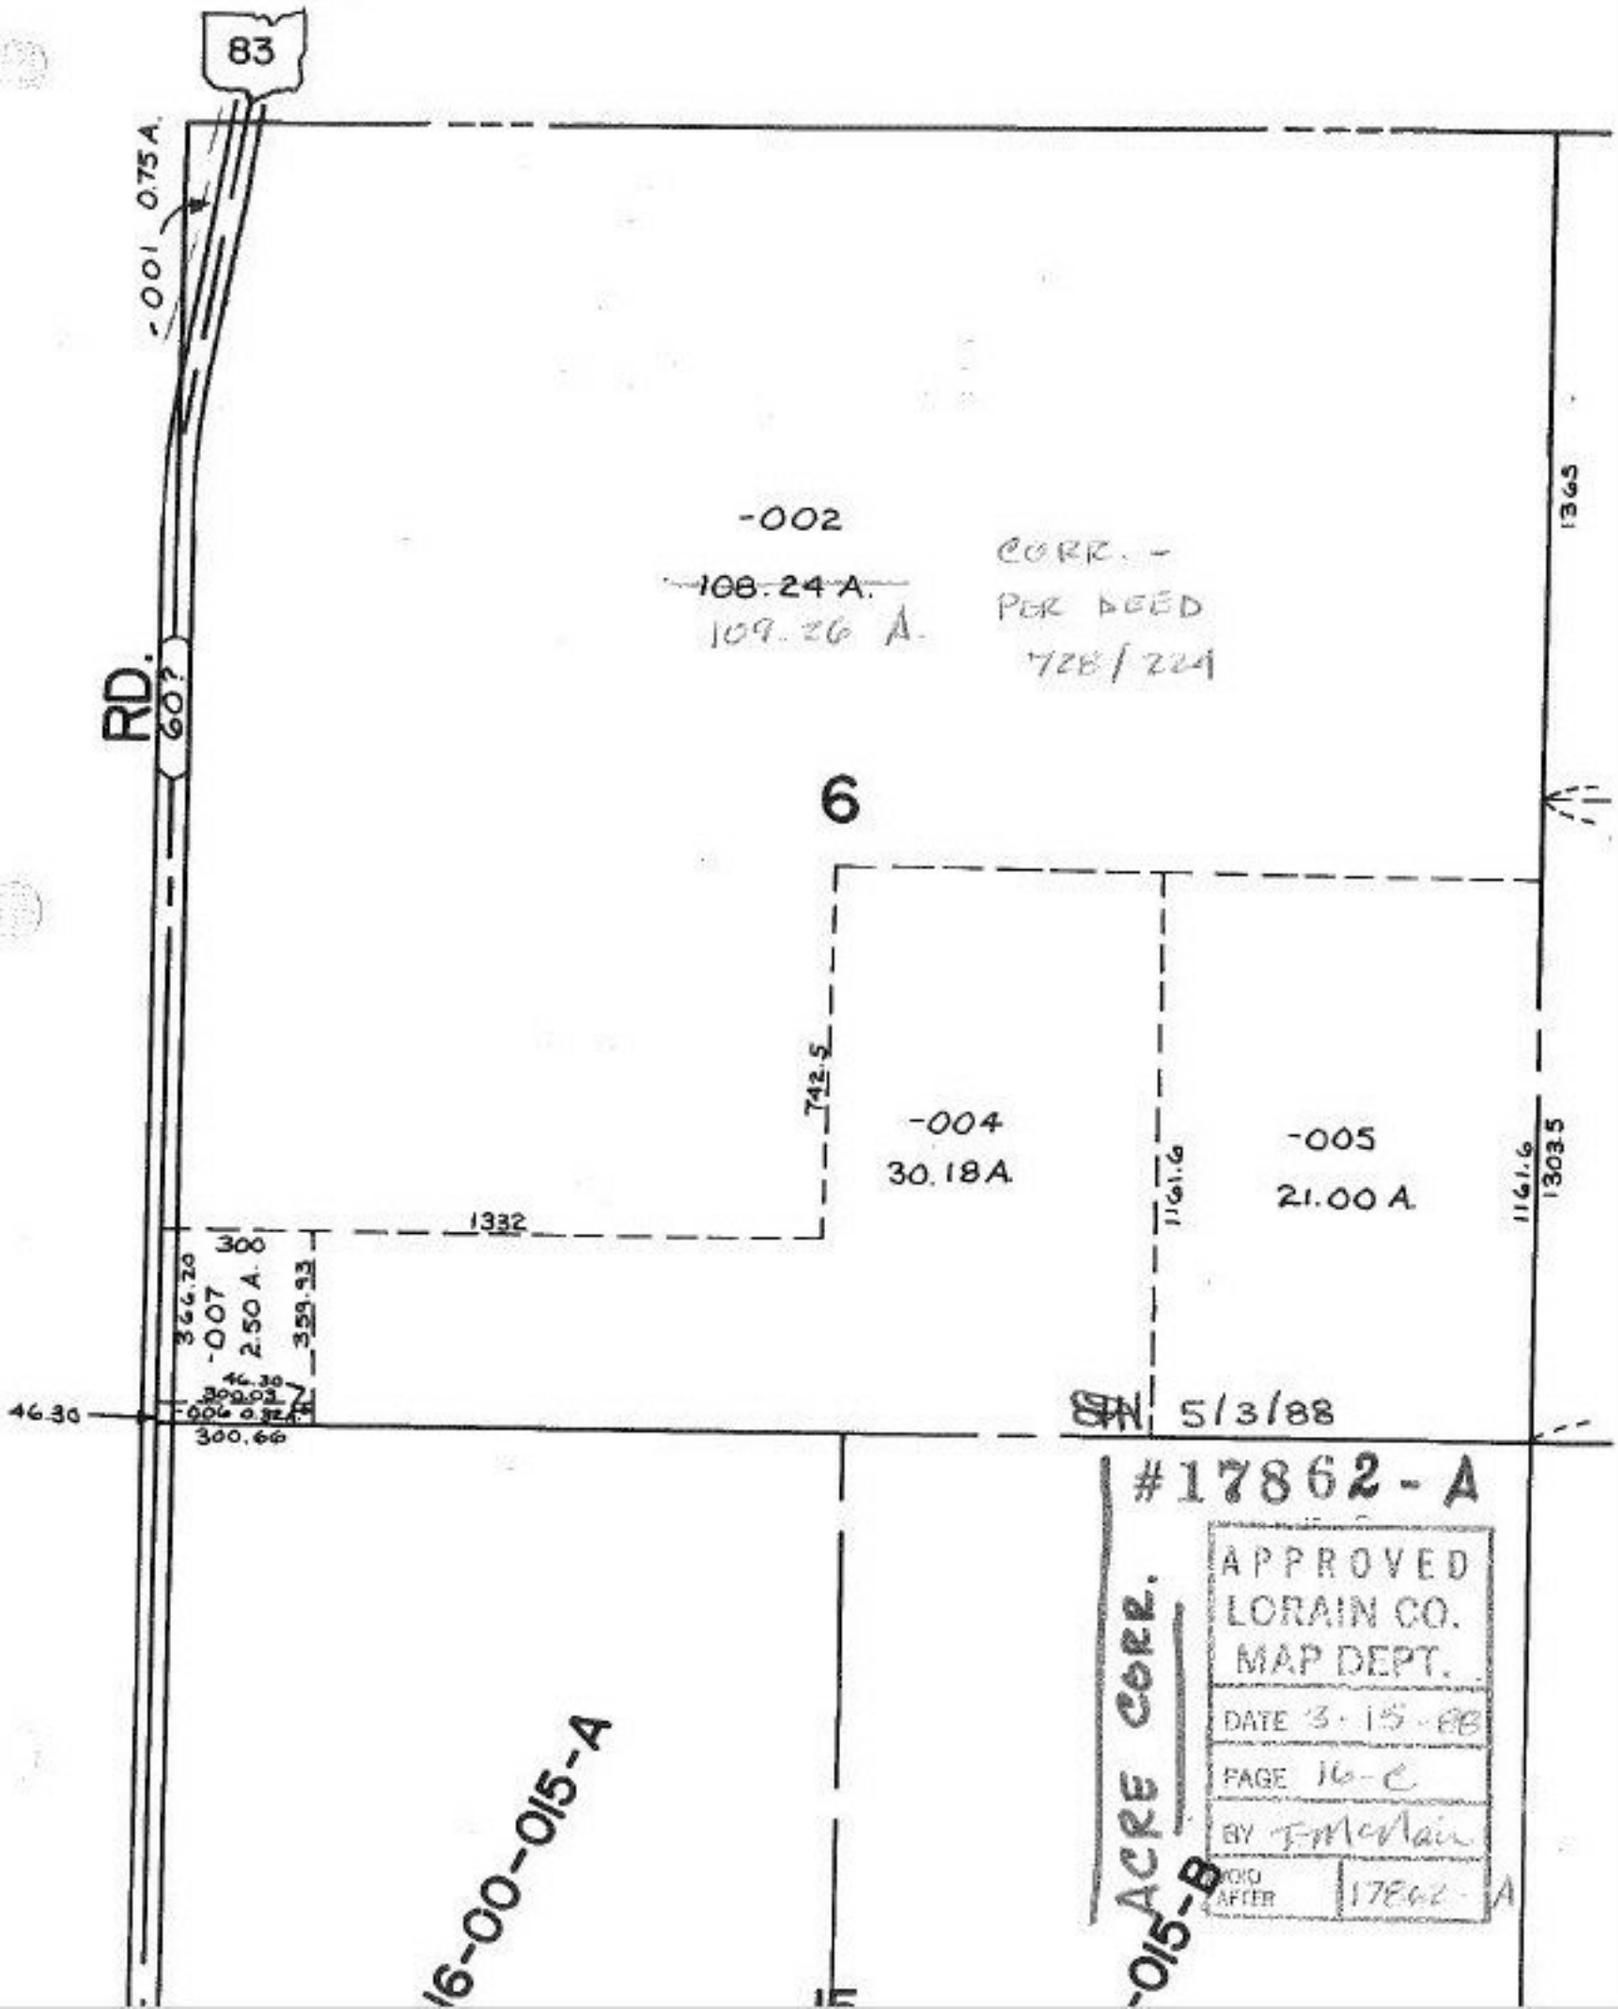
83
-001 0.75 A.
RD.
60'
-002
~~108.24 A.~~
109.26 A.
CORR. -
PER DEED
728/224
6
1365
742.5
-004
30.18 A.
1161.6
-005
21.00 A.
1161.6
1303.5
1332
300
366.20
-007
2.50 A.
359.93
46.30
300.03
-006 0.32 A.
300.66
46.30
5/3/88
#17862-A
APPROVED
LORAIN CO.
MAP DEPT.
DATE 3-15-88
PAGE 16-C
BY J McClain
ACRE CORR.
16-00-015-A
-015-B