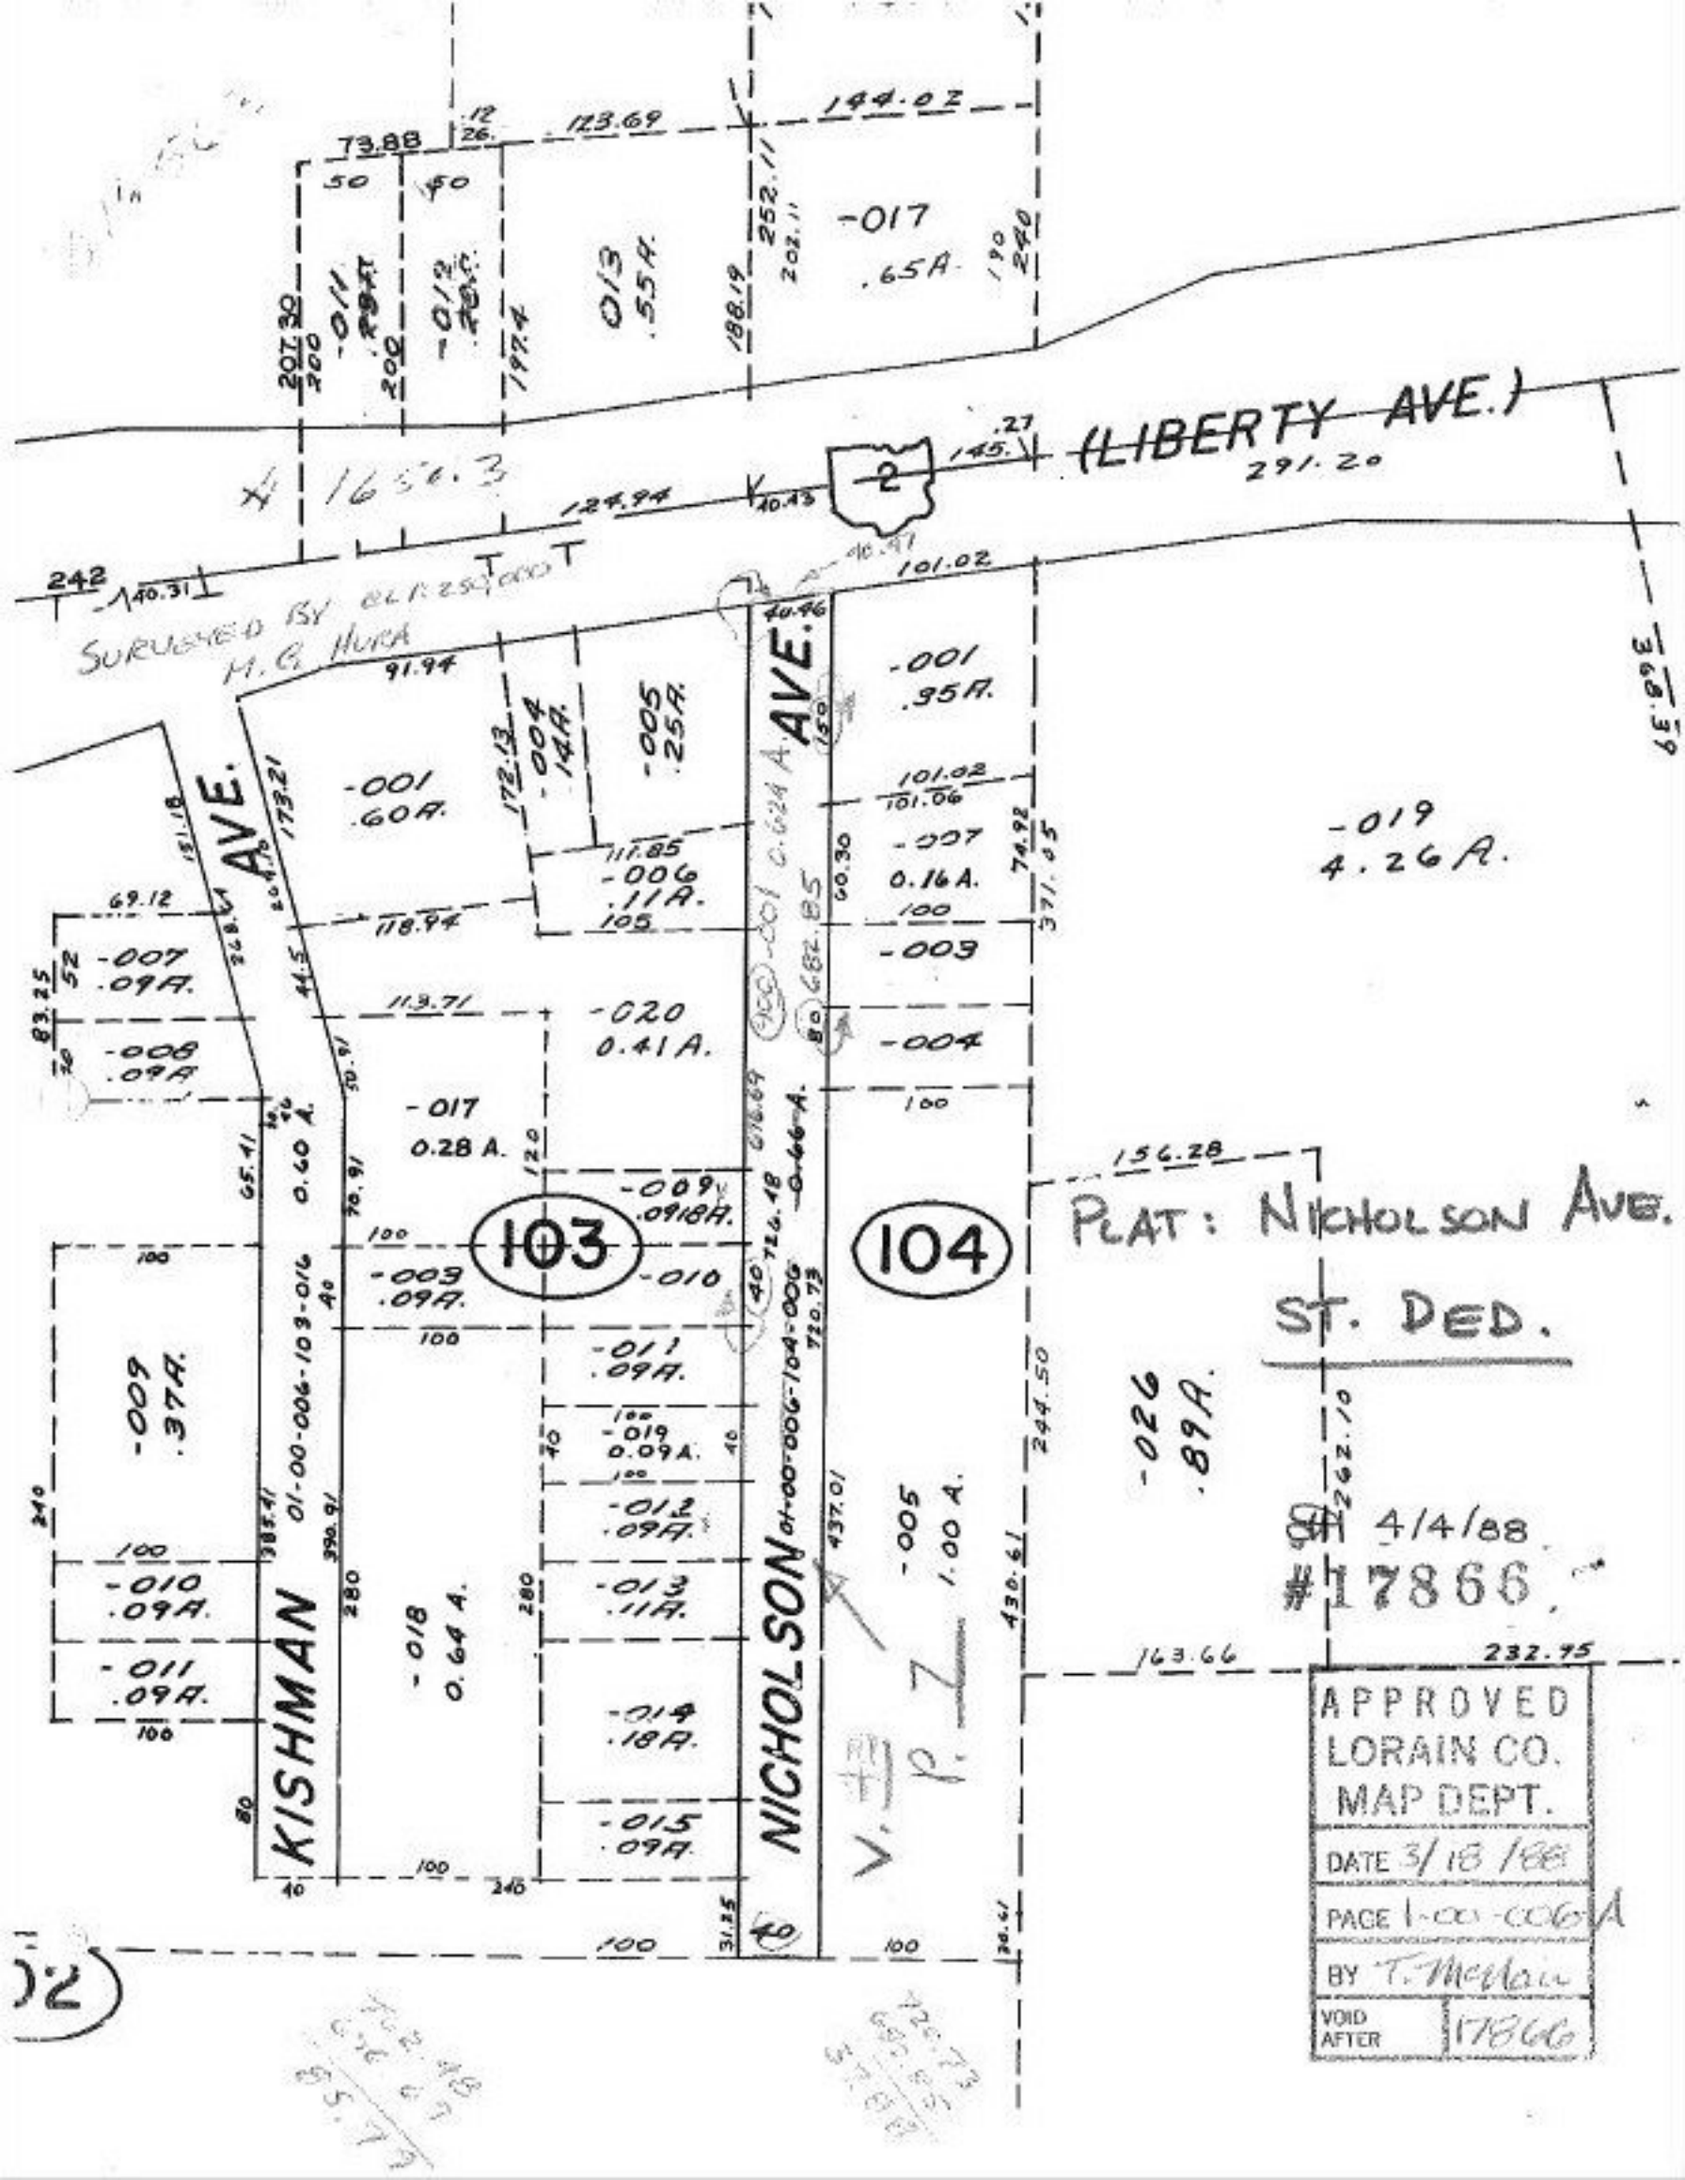
(LIBERTY AVE.)
291.20
KISHMAN AVE.
NICHOLSON AVE.
103
104
-001 .60A.
-004 .14A.
-005 .25A.
-001 .95A.
-007 0.16A.
-003
-004
-020 0.41A.
-017 0.28 A.
-009 .09 18A.
-010
-011 .09A.
-019 0.09A.
-012 .09A.
-013 .11A.
-014 .18A.
-015 .09A.
-018 0.64 A.
-009 .37A.
-010 .09A.
-011 .09A.
-007 .09A.
-006 .09A.
-006 .11A.
-017 .65A.
-013 .55A.
-019 4.26A.
-026 .89A.
-005 1.00 A.
PLAT: NICHOLSON AVE. ST. DED.
4/4/88
#17866
APPROVED
LORAIN CO.
MAP DEPT.
DATE 3/18/88
PAGE 1-00-006A
BY T. McClain
VOID AFTER 17866
SURVEYED BY ELK 25000
M. G. HUKA
01-00-006-103-016
01-00-006-104-006
V. P. 7