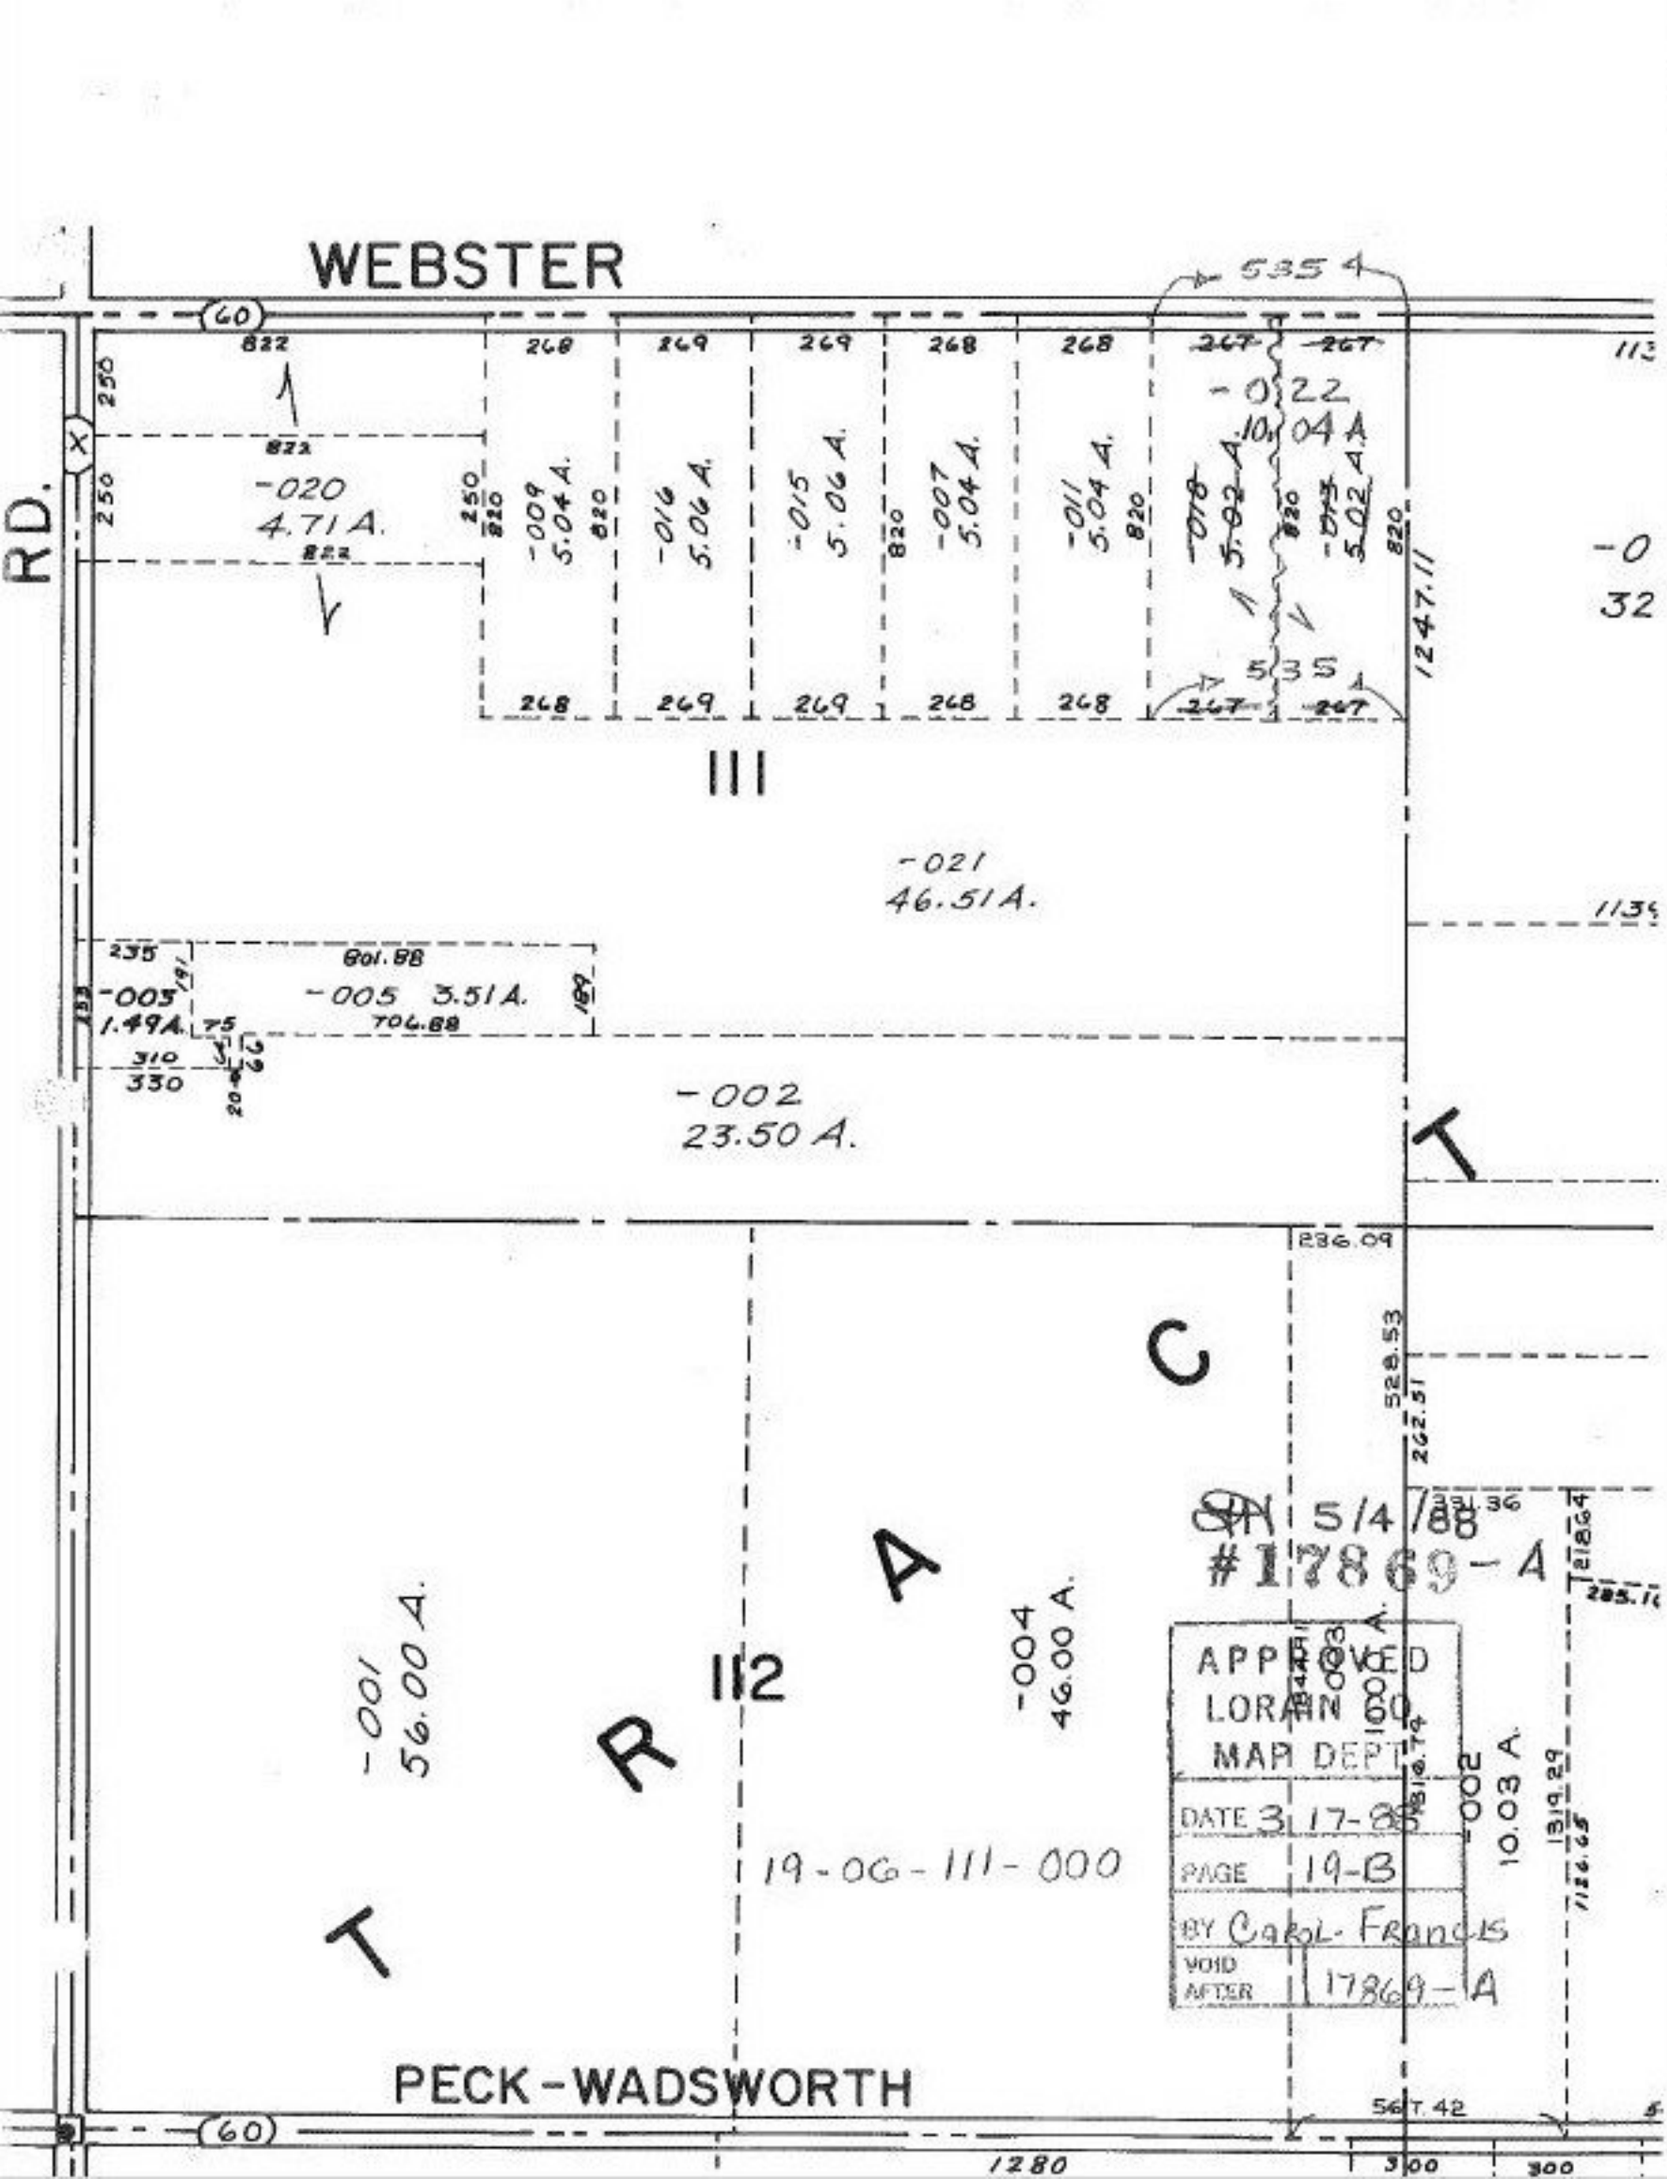
WEBSTER
RD.
PECK-WADSWORTH
(60)
822
268
269
269
268
268
267
267
250
250
822
-020
4.71 A.
822
250
820
-009
5.04 A.
820
-016
5.06 A.
-015
5.06 A.
820
-007
5.04 A.
-011
5.04 A.
820
-022
10.04 A.
-018
5.02 A.
820
-013
5.02 A.
820
1247.11
535
534
111
-021
46.51 A.
235
-003
1.49 A.
191
153
75
310
330
901.88
-005 3.51 A.
189
704.88
-002
23.50 A.
T
C
R
A
T
112
-001
56.00 A.
-004
46.00 A.
19-06-111-000
236.09
528.53
262.51
1319.29
1318.74
1003.
1003.
-002
10.03 A.
SPLIT 5/4/88
#17869-A
APPROVED
LORAIN CO
MAP DEPT
DATE 3-17-88
PAGE 19-B
BY Carol Francis
VOID AFTER 17869-A
56
T. 42
1280
300
300