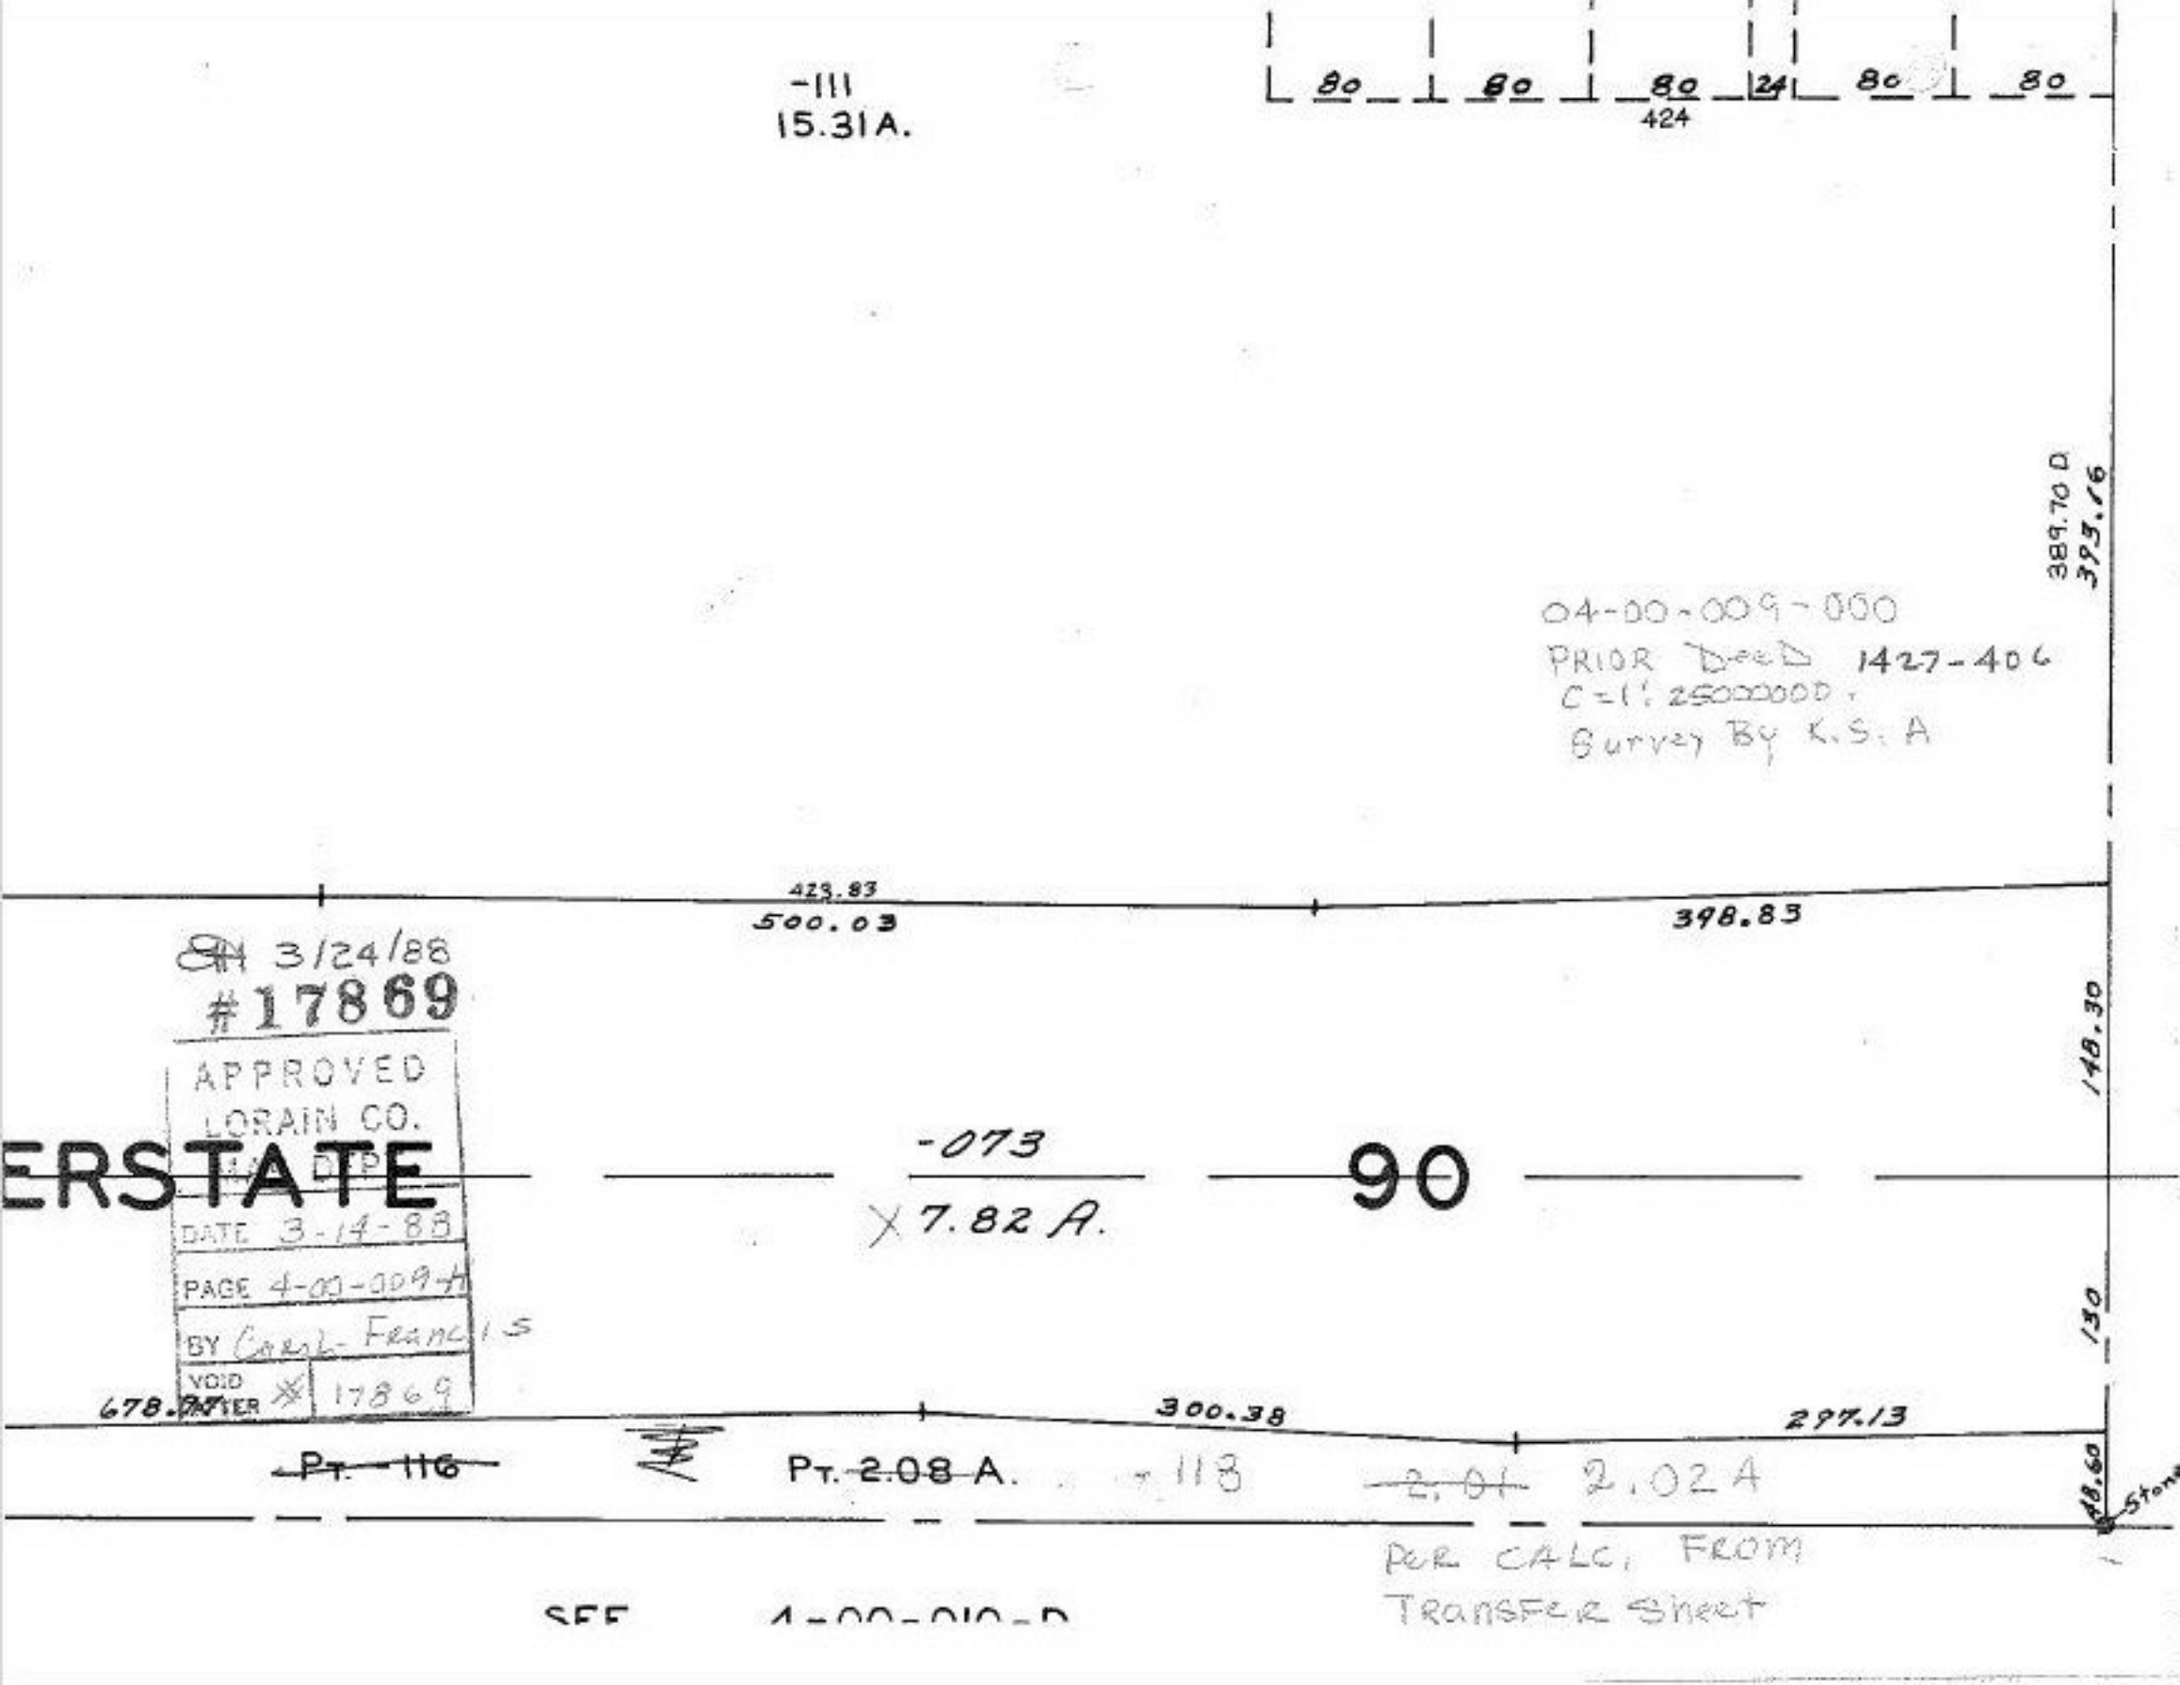
-111
15.31A.
80
80
80
424
24
80
80
389.70 D
393.16
04-00-009-000
PRIOR Deed 1427-406
C=1:2500000D.
Survey By K.S.A
423.83
500.03
398.85
3/24/88
#17869
APPROVED
LORAIN CO.
DATE 3-14-88
PAGE 4-00-009-A
BY Carol Francis
VOID AFTER # 17869
ERSTATE
-073
X 7.82 A.
90
148.30
130
678.
300.38
297.13
Pt. 116
Pt. 2.08 A.
-113
2.01
2.02 A
PER CALC. FROM
TRANSFER Sheet
48.60
Ston
SEE 4-00-010-D