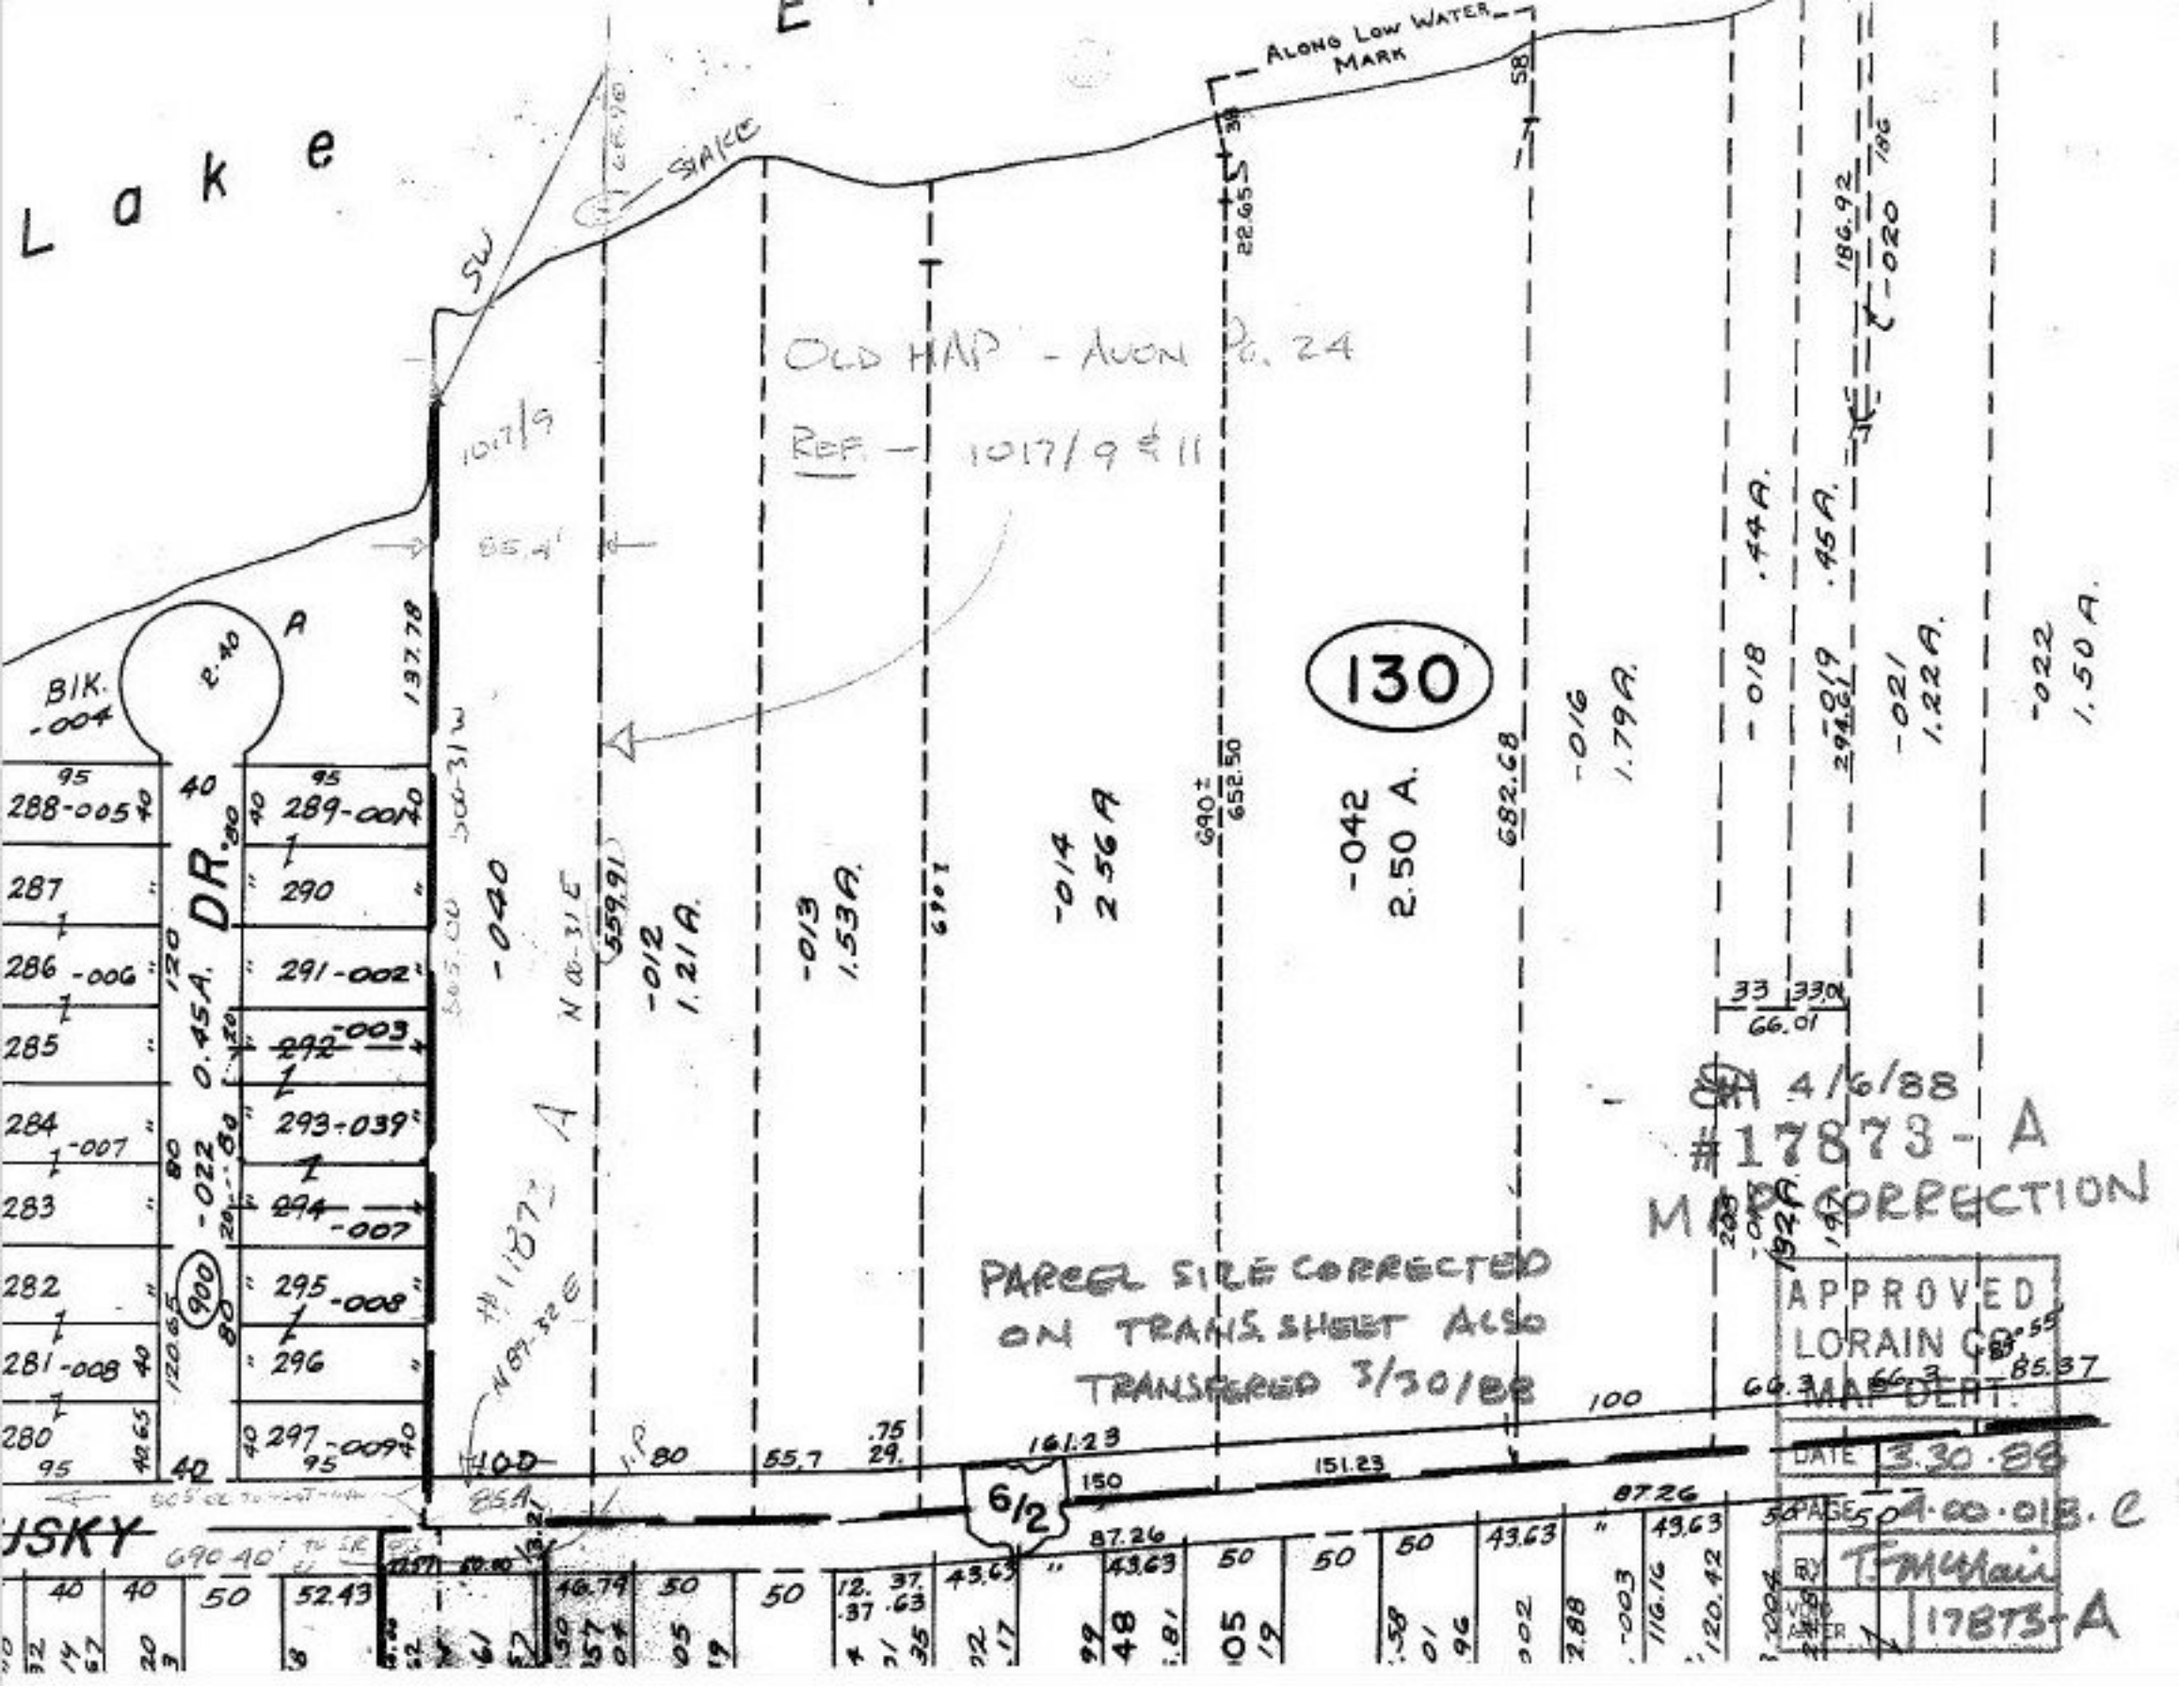

Lake
ALONG LOW WATER MARK
SIAKE
SW
OLD MAP - AVON Pg. 24
REF. - 1017/9 & 11
1017/9
85.4'
BLK. -004
2.40
A
137.78
288-005
289-001
287
290
286 -006
291-002
285
292 -003
284 -007
293-039
283
294 -007
282
295 -008
281 -008
296
280
297 -009
DR.
0.45A.
-022
900
-040
N 00-31 E
559.91
-012 1.21 A.
-013 1.53A.
-014 2.56 A
690±
652.50
130
-042 2.50 A.
682.68
-016 1.79A.
-018 .44A.
-019 .45A.
294.61
-021 1.22A.
-022 1.50 A.
186.92
-020
33
33.01
66.01
#17873 A
N 89-32 E
PARCEL SIZE CORRECTED ON TRANS. SHEET ALSO TRANSFERED 3/30/88
4/6/88
#17873 - A
MAP CORRECTION
APPROVED
LORAIN CO.
MAP DEPT.
DATE 3.30.88
PAGE 4.00.018.C
BY T. McMain
17873-A
6/2
161.23
151.23
87.26
100
66.3
85.37
USKY
690.40'