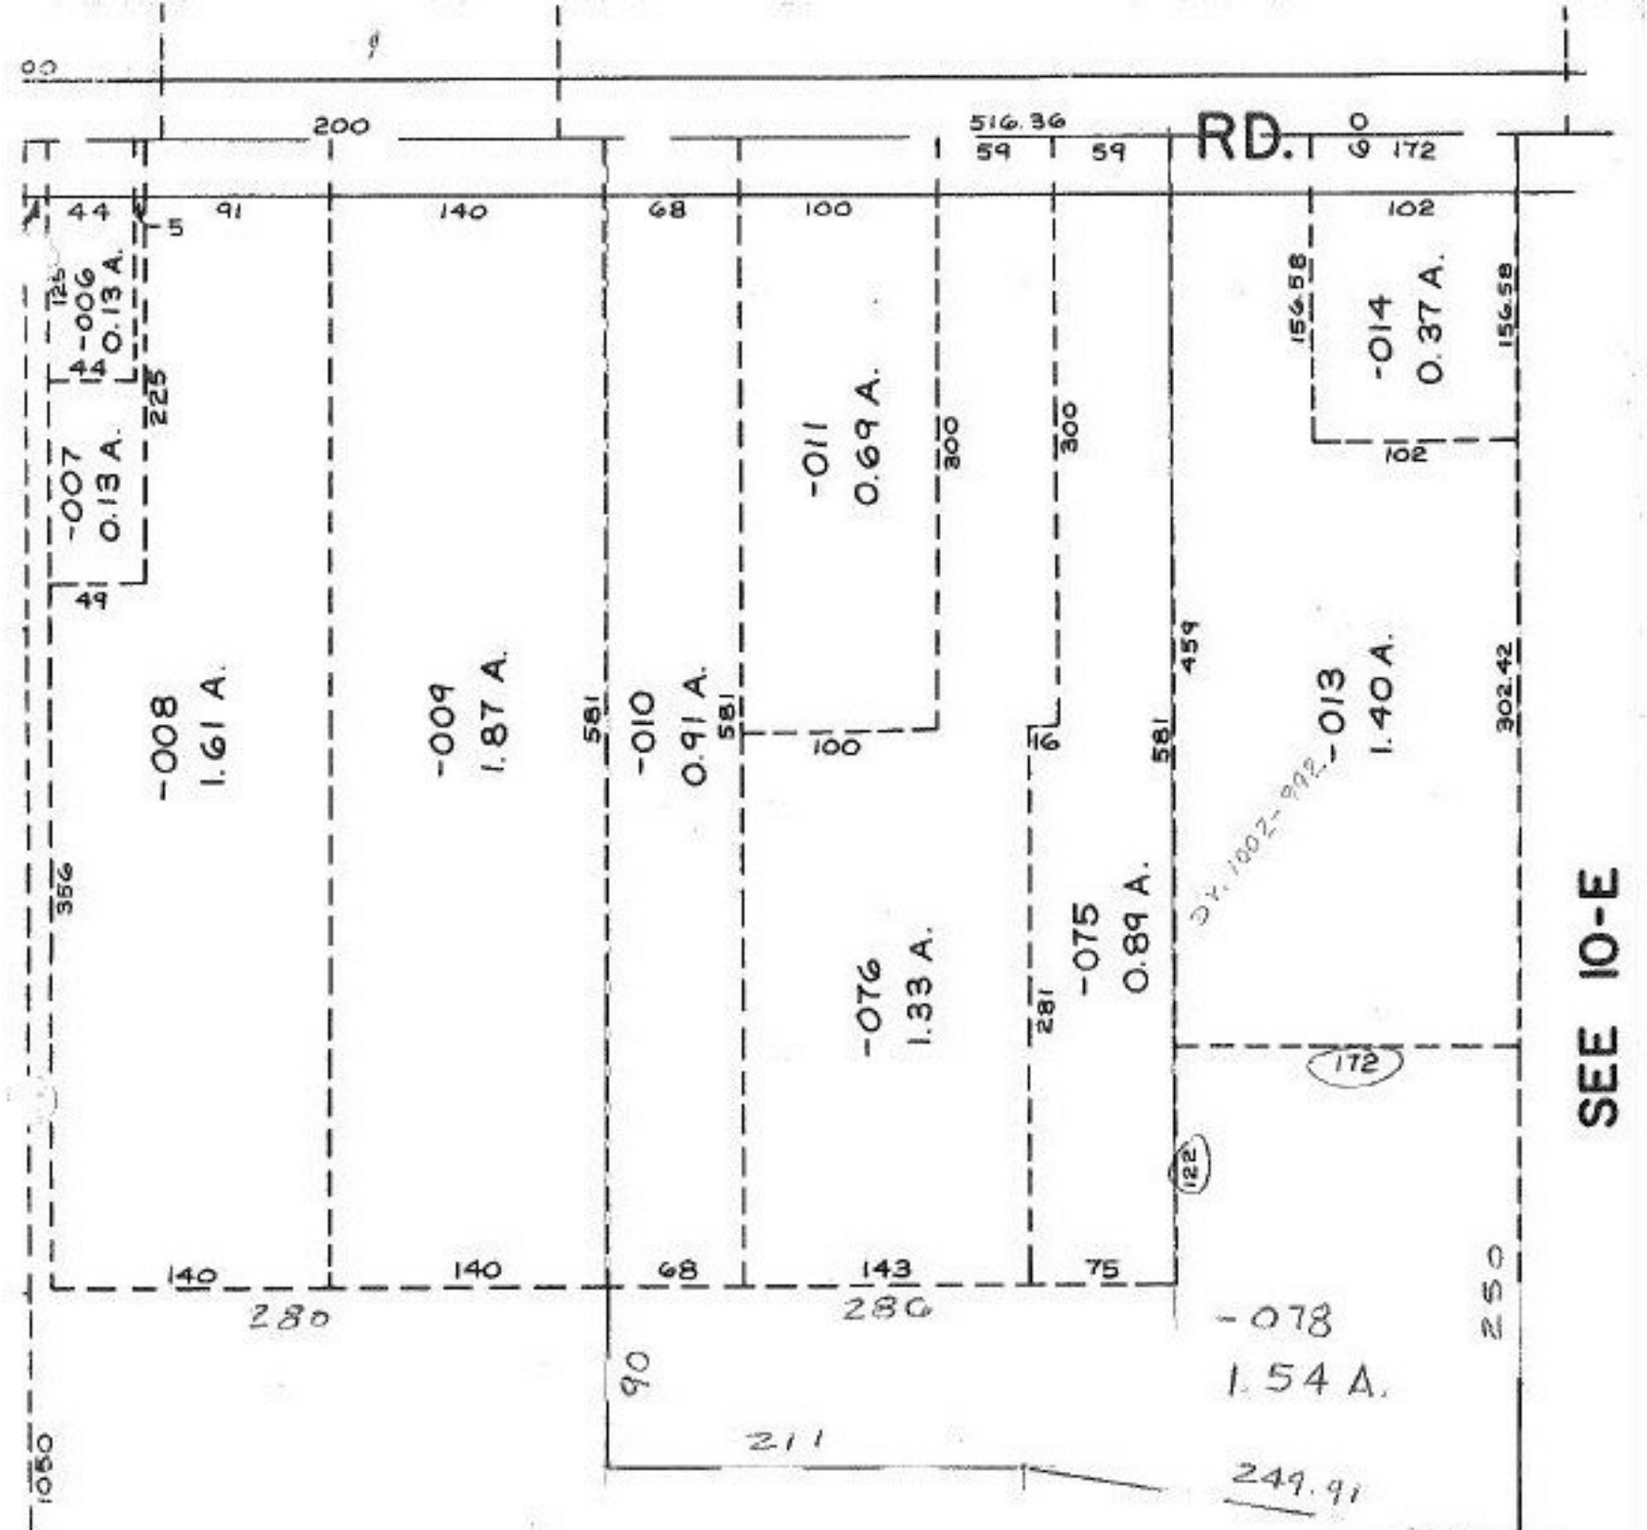

4/20/88
#17875

APPROVED
LORAIN CO.
MAP DEPT.
DATE 3-17-88
PAGE 10-00-020-
BY Carol Francis
VOID AFTER 17875

- 079
~~-015~~
~~8.03 A.~~
6.49 A.

10-00-020-103-
PRIOR Deed 858-678
Survey By Laundon-Simon. CAHL & Assoc.

Black River