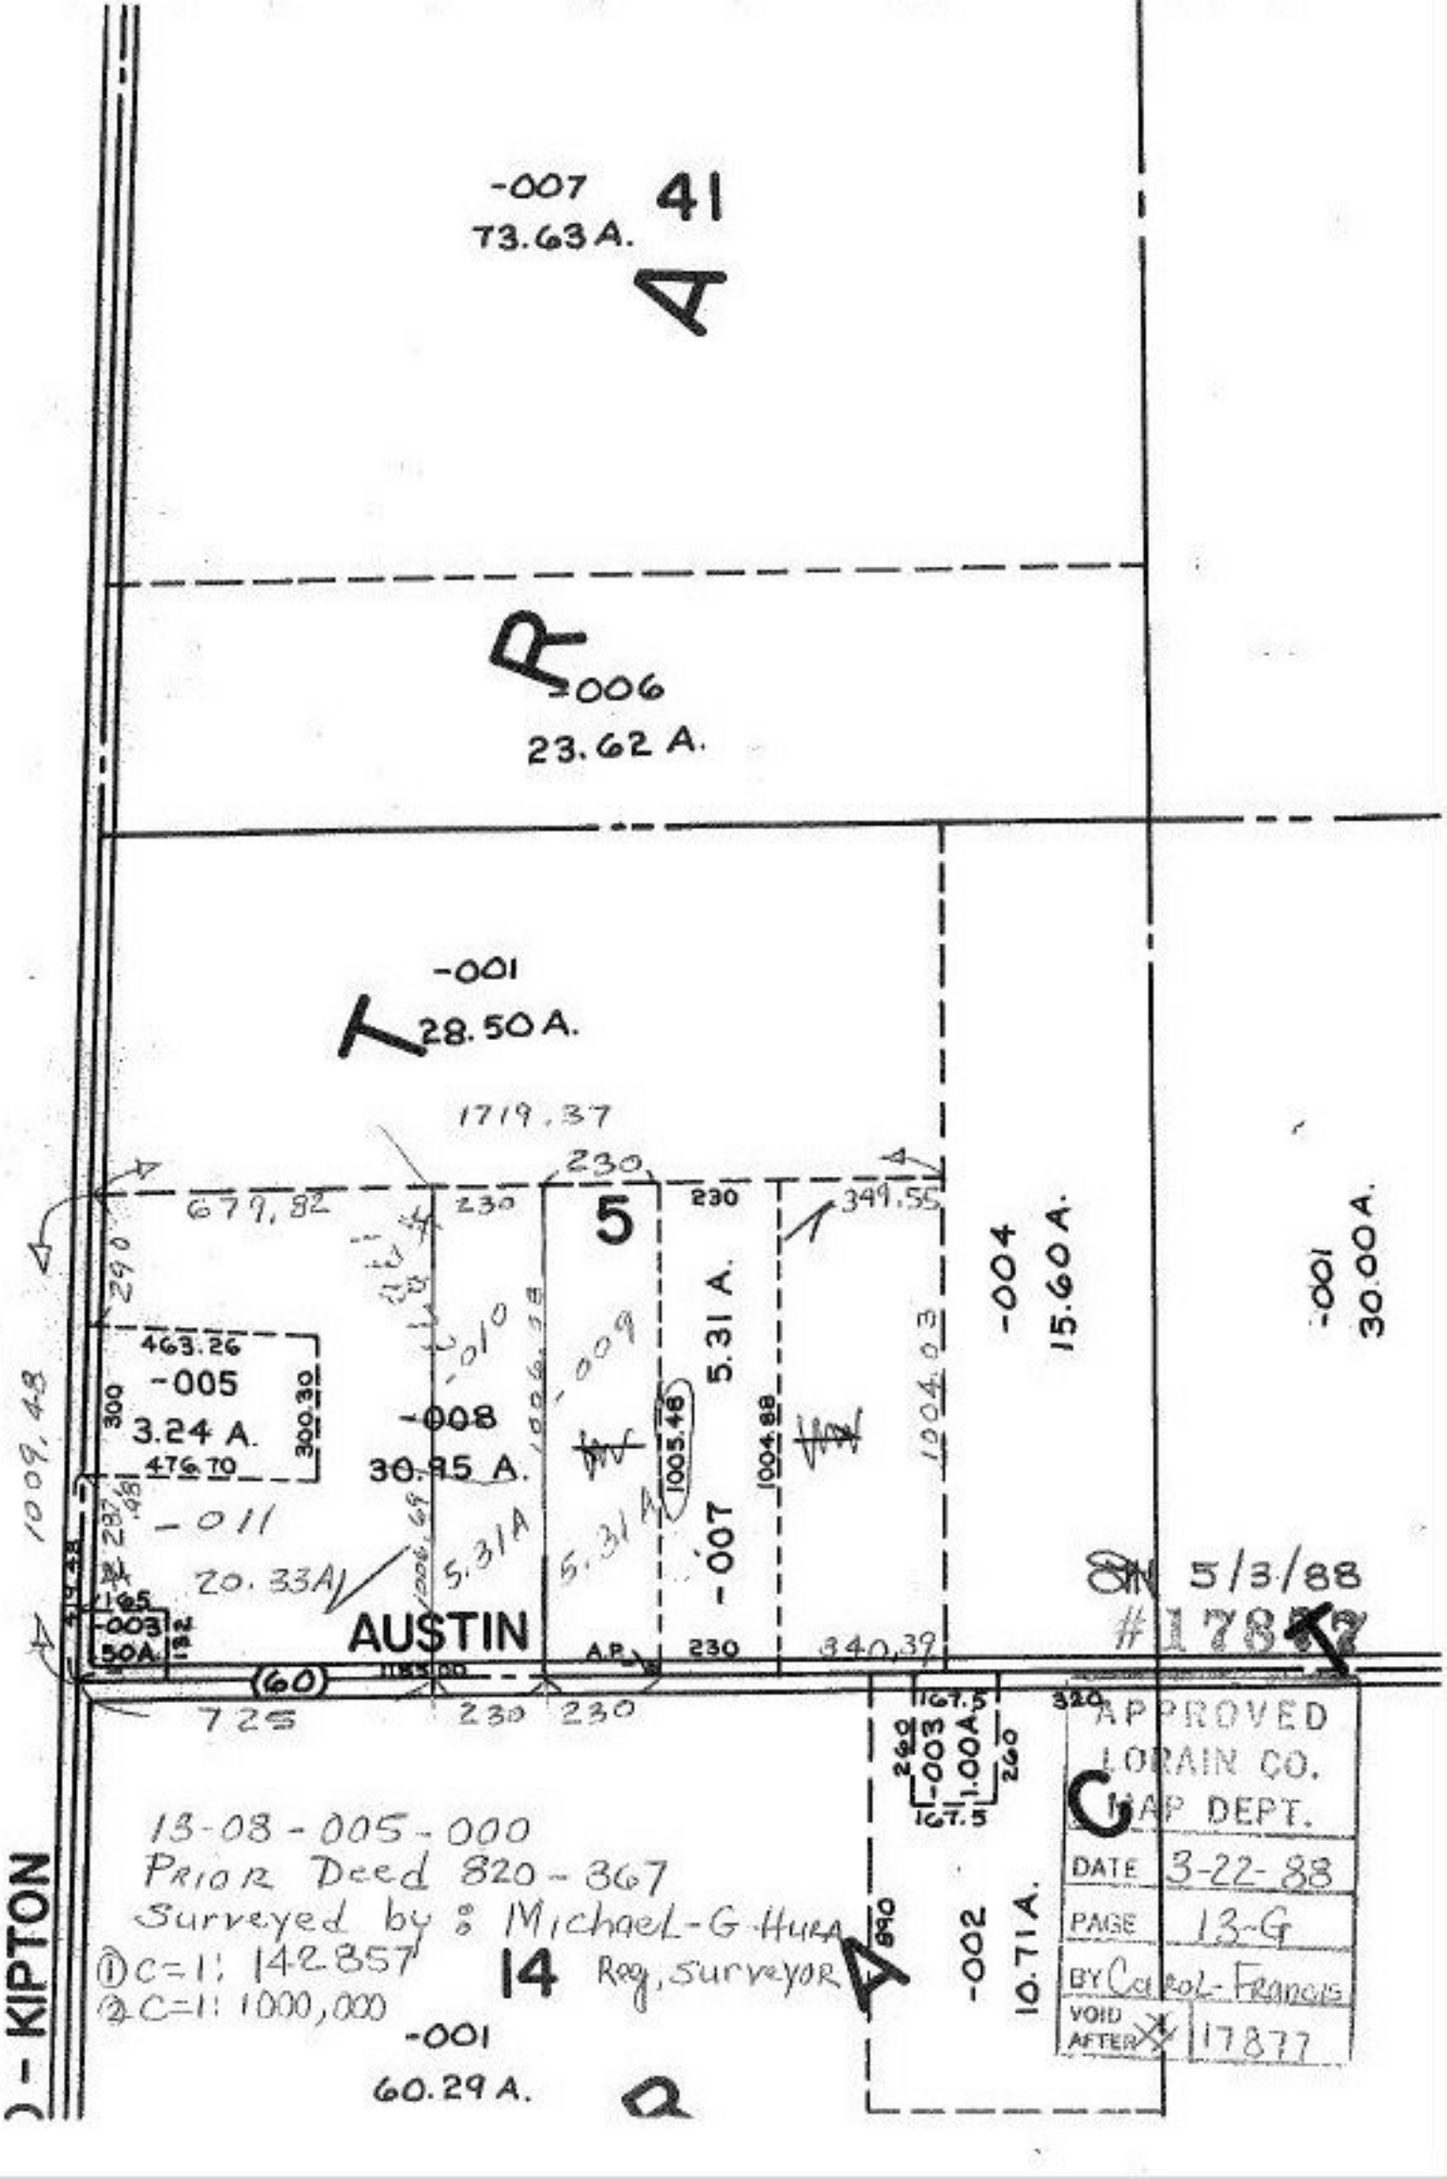

-007
73.63 A.
41
A
R
-006
23.62 A.
-001
T
28.50 A.
1719.37
230
679.82
230
5
230
349.55
-004
15.60 A.
-001
30.00 A.
463.26
-005
3.24 A.
476.70
300
300.30
-008
30.95 A.
-010
-009
5.31 A.
1005.48
1004.88
1004.03
-007
1009.48
-011
20.33A
5.31A
5.31A
-003
50A.
AUSTIN
A.P.
230
340.39
(60)
725
230
230
167.5
320
260
-003
1.00A
260
167.5
-002
10.71 A.
890
A
C
-001
60.29 A.
KIPTON
13-08-005-000
Prior Deed 820-367
Surveyed by: Michael-G-Hura
① C=1: 142857
② C=1: 1000,000
14
Reg. surveyor
5/3/88
#17877
APPROVED
LORAIN CO.
MAP DEPT.
DATE 3-22-88
PAGE 13-G
BY Carol-Francis
VOID AFTER 17877