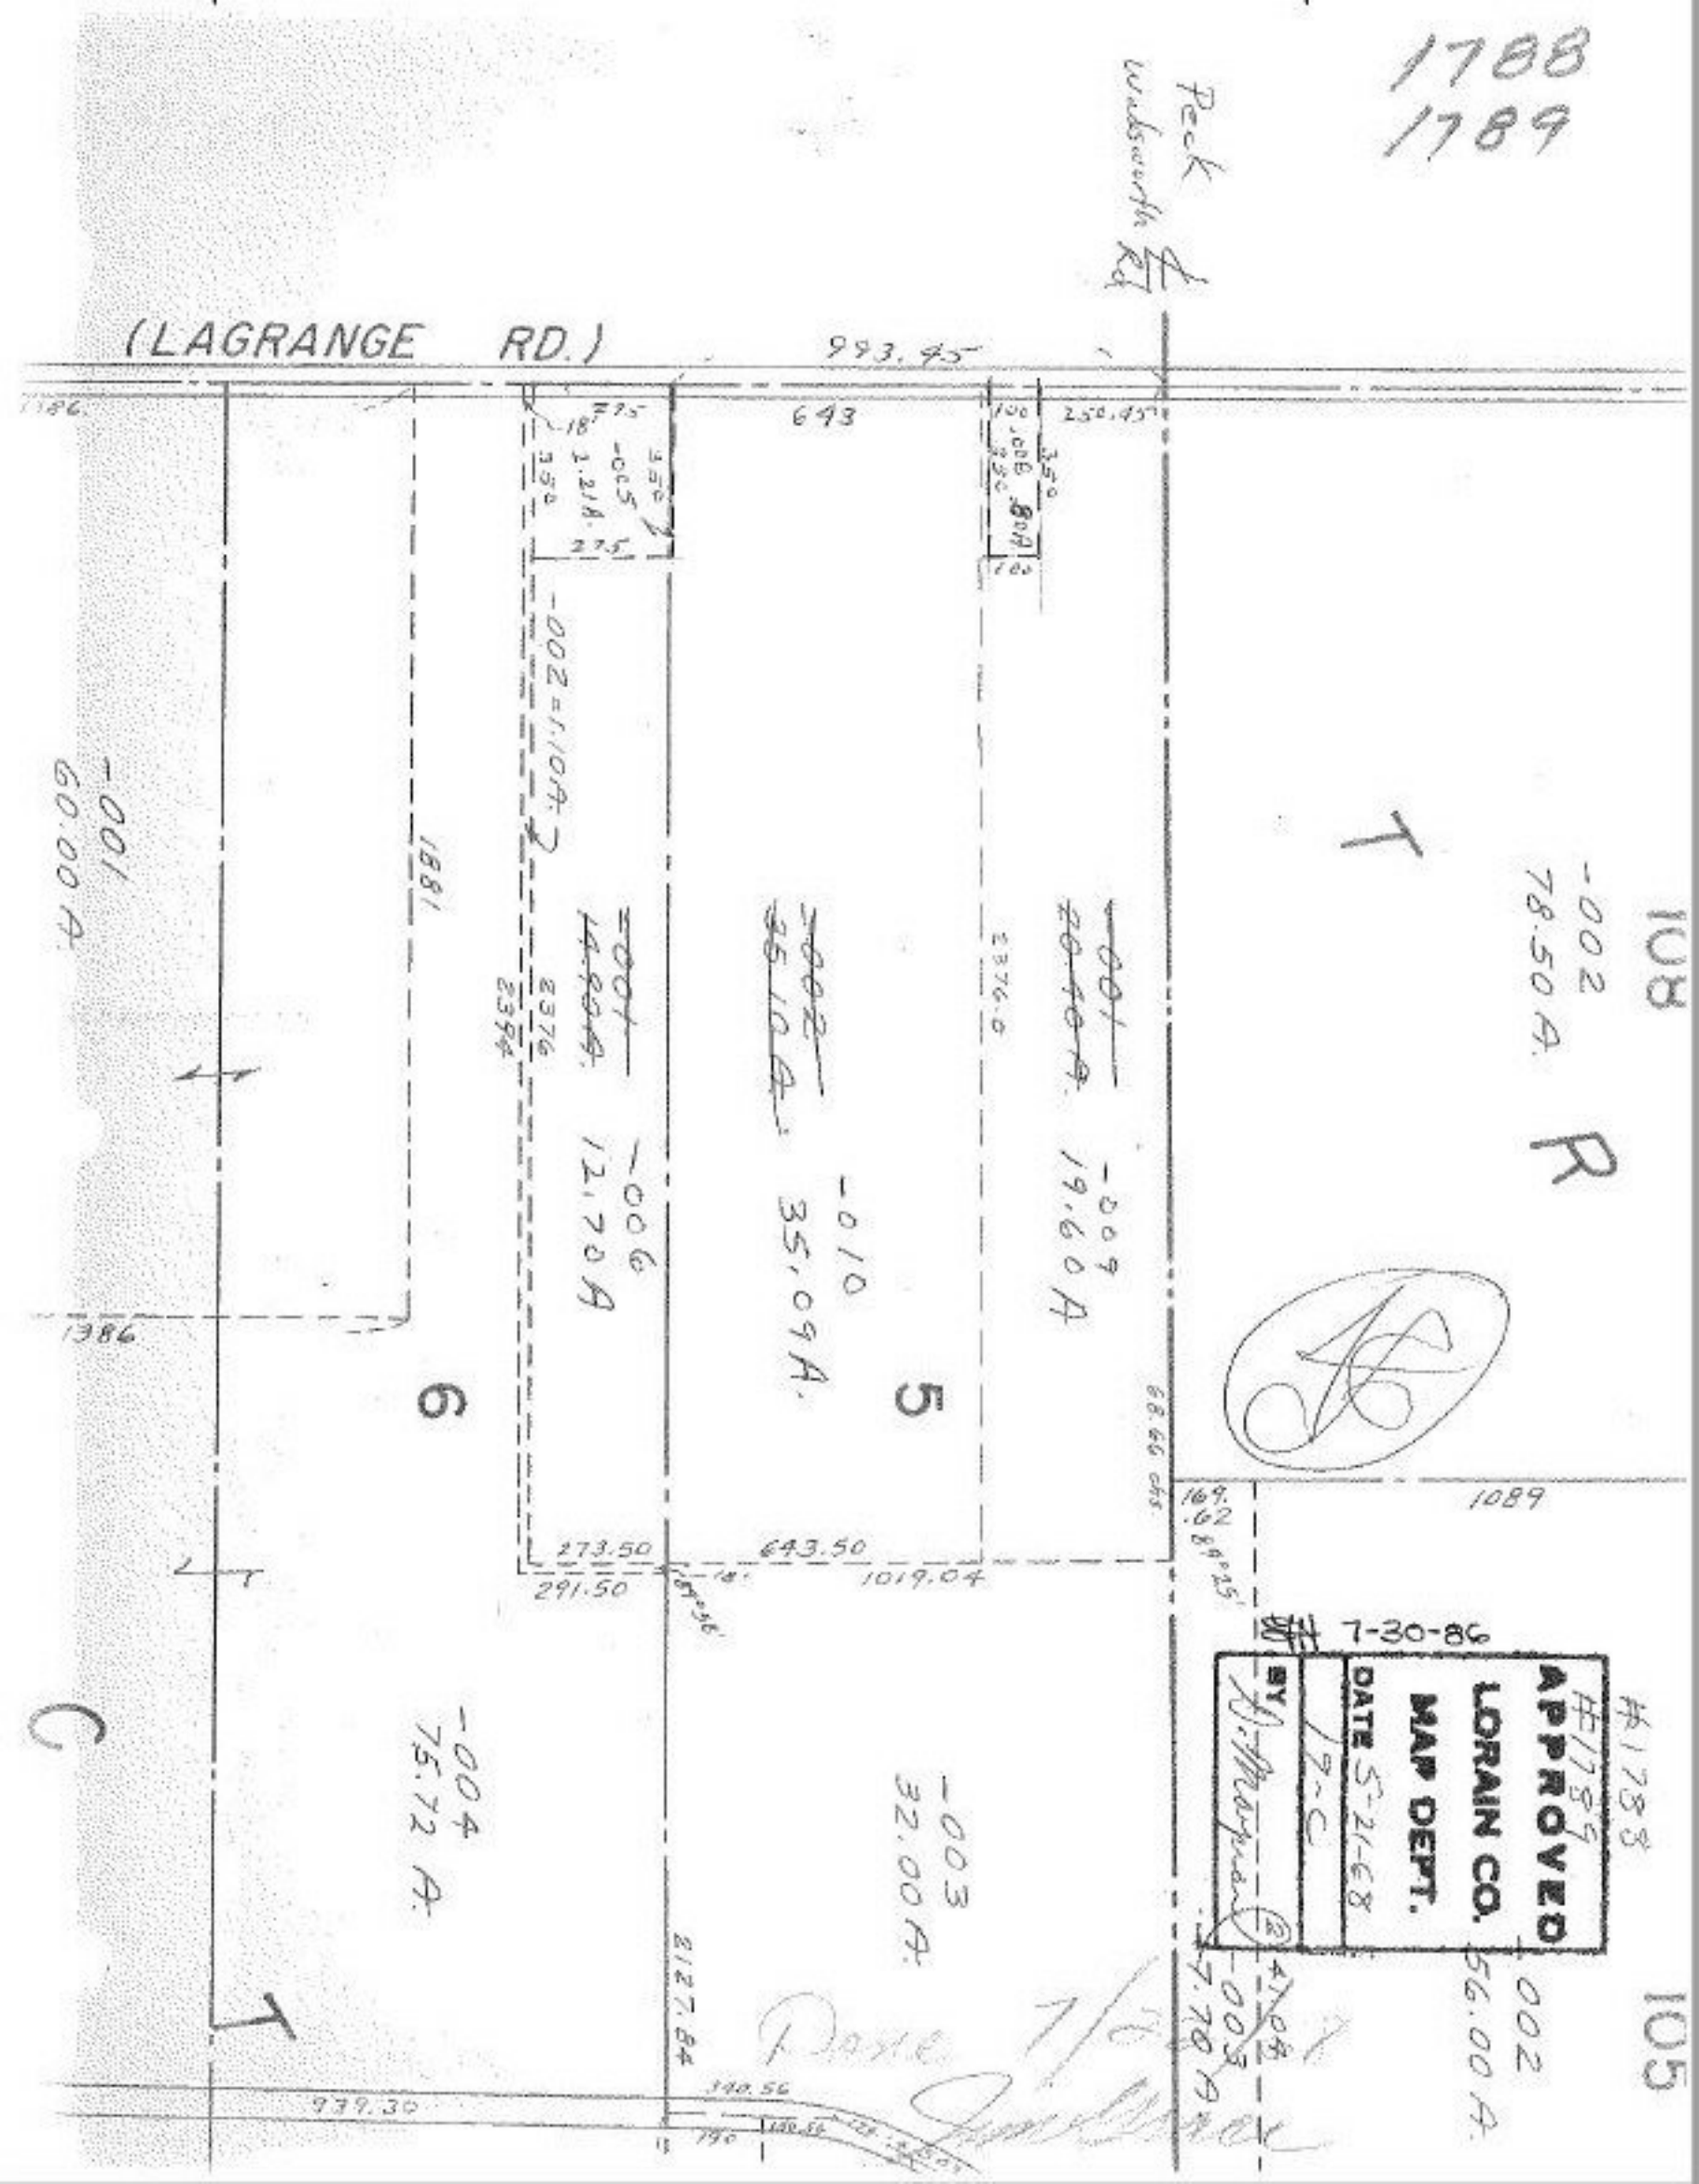
1788
1789
Peck Wadsworth Rd
(LAGRANGE RD.)
993.45
643
250.45
-001
60.00 A.
1881
-002=1.10 A.
-001
14.90 A.
-002
35.10 A.
-001
20.40 A.
-006
12.70 A
-010
35.09 A.
-009
19.60 A
-002
78.50 A.
108
R
T
1386
6
5
1089
273.50
643.50
291.50
1019.04
169.62
7-30-86
#1788
#1789
APPROVED
LORAIN CO.
MAP DEPT.
DATE 5-21-68
BY
-004
75.72 A.
-003
32.00 A.
-002
56.00 A.
105
C
T
2127.84
939.30
340.56
Date 7/28/87