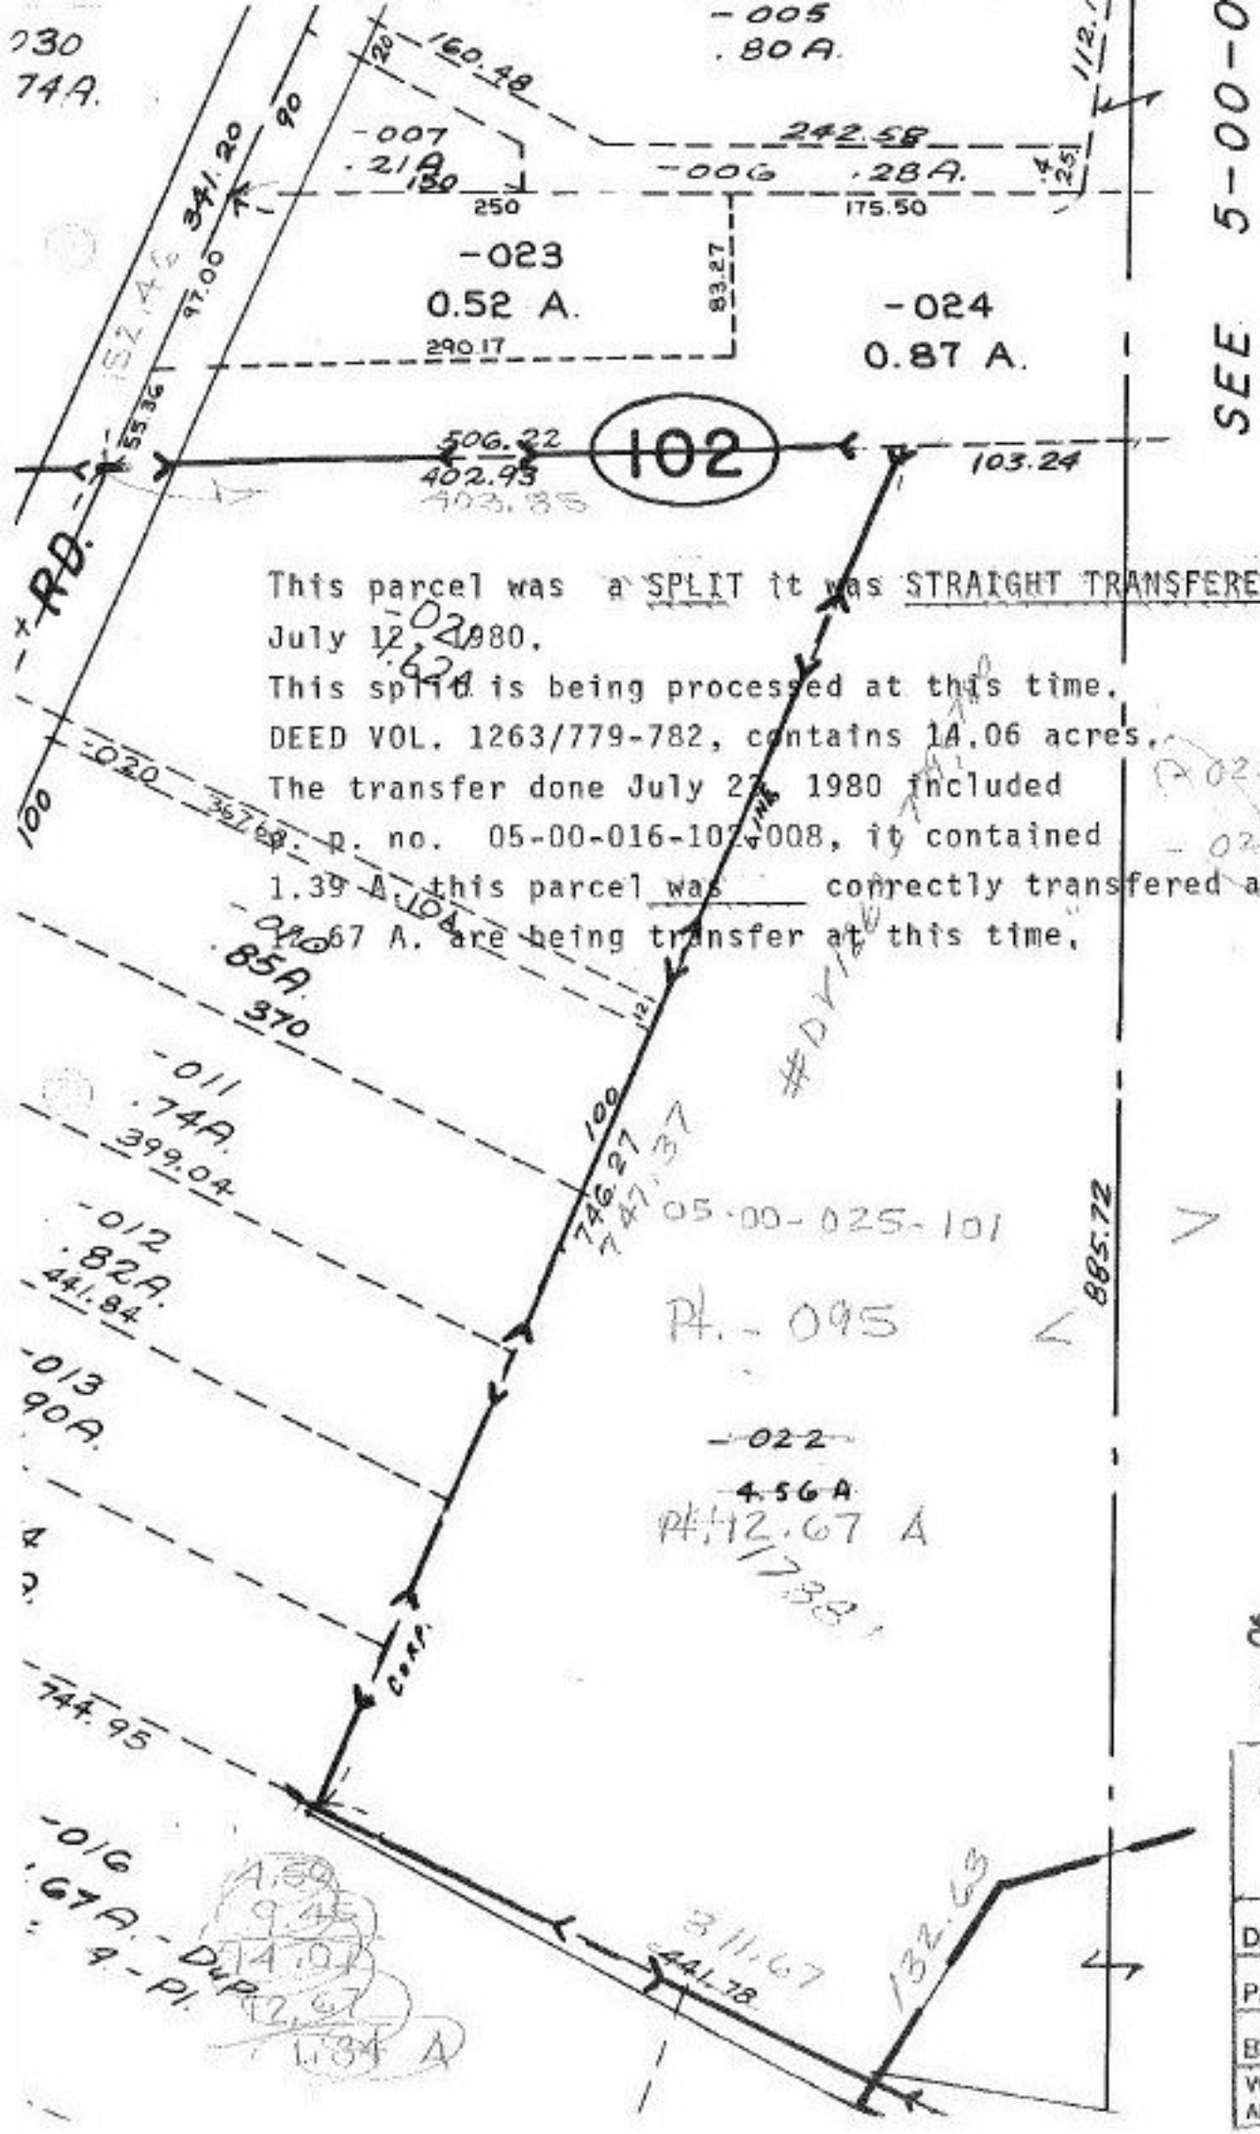

This parcel was a SPLIT it was STRAIGHT TRANSFERED July 12, 1980.
This split is being processed at this time.
DEED VOL. 1263/779-782, contains 14.06 acres.
The transfer done July 22, 1980 included p. p. no. 05-00-016-102-008, it contained 1.39 A. this parcel was correctly transfered at that time.
12.67 A. are being transfer at this time.

SH 4/4/88
#17881

APPROVED
LORAIN CO.
MAP DEPT.

DATE 3-24-88
PAGE 5-00-016-B
BY Carol Francis
VOID AFTER 17881