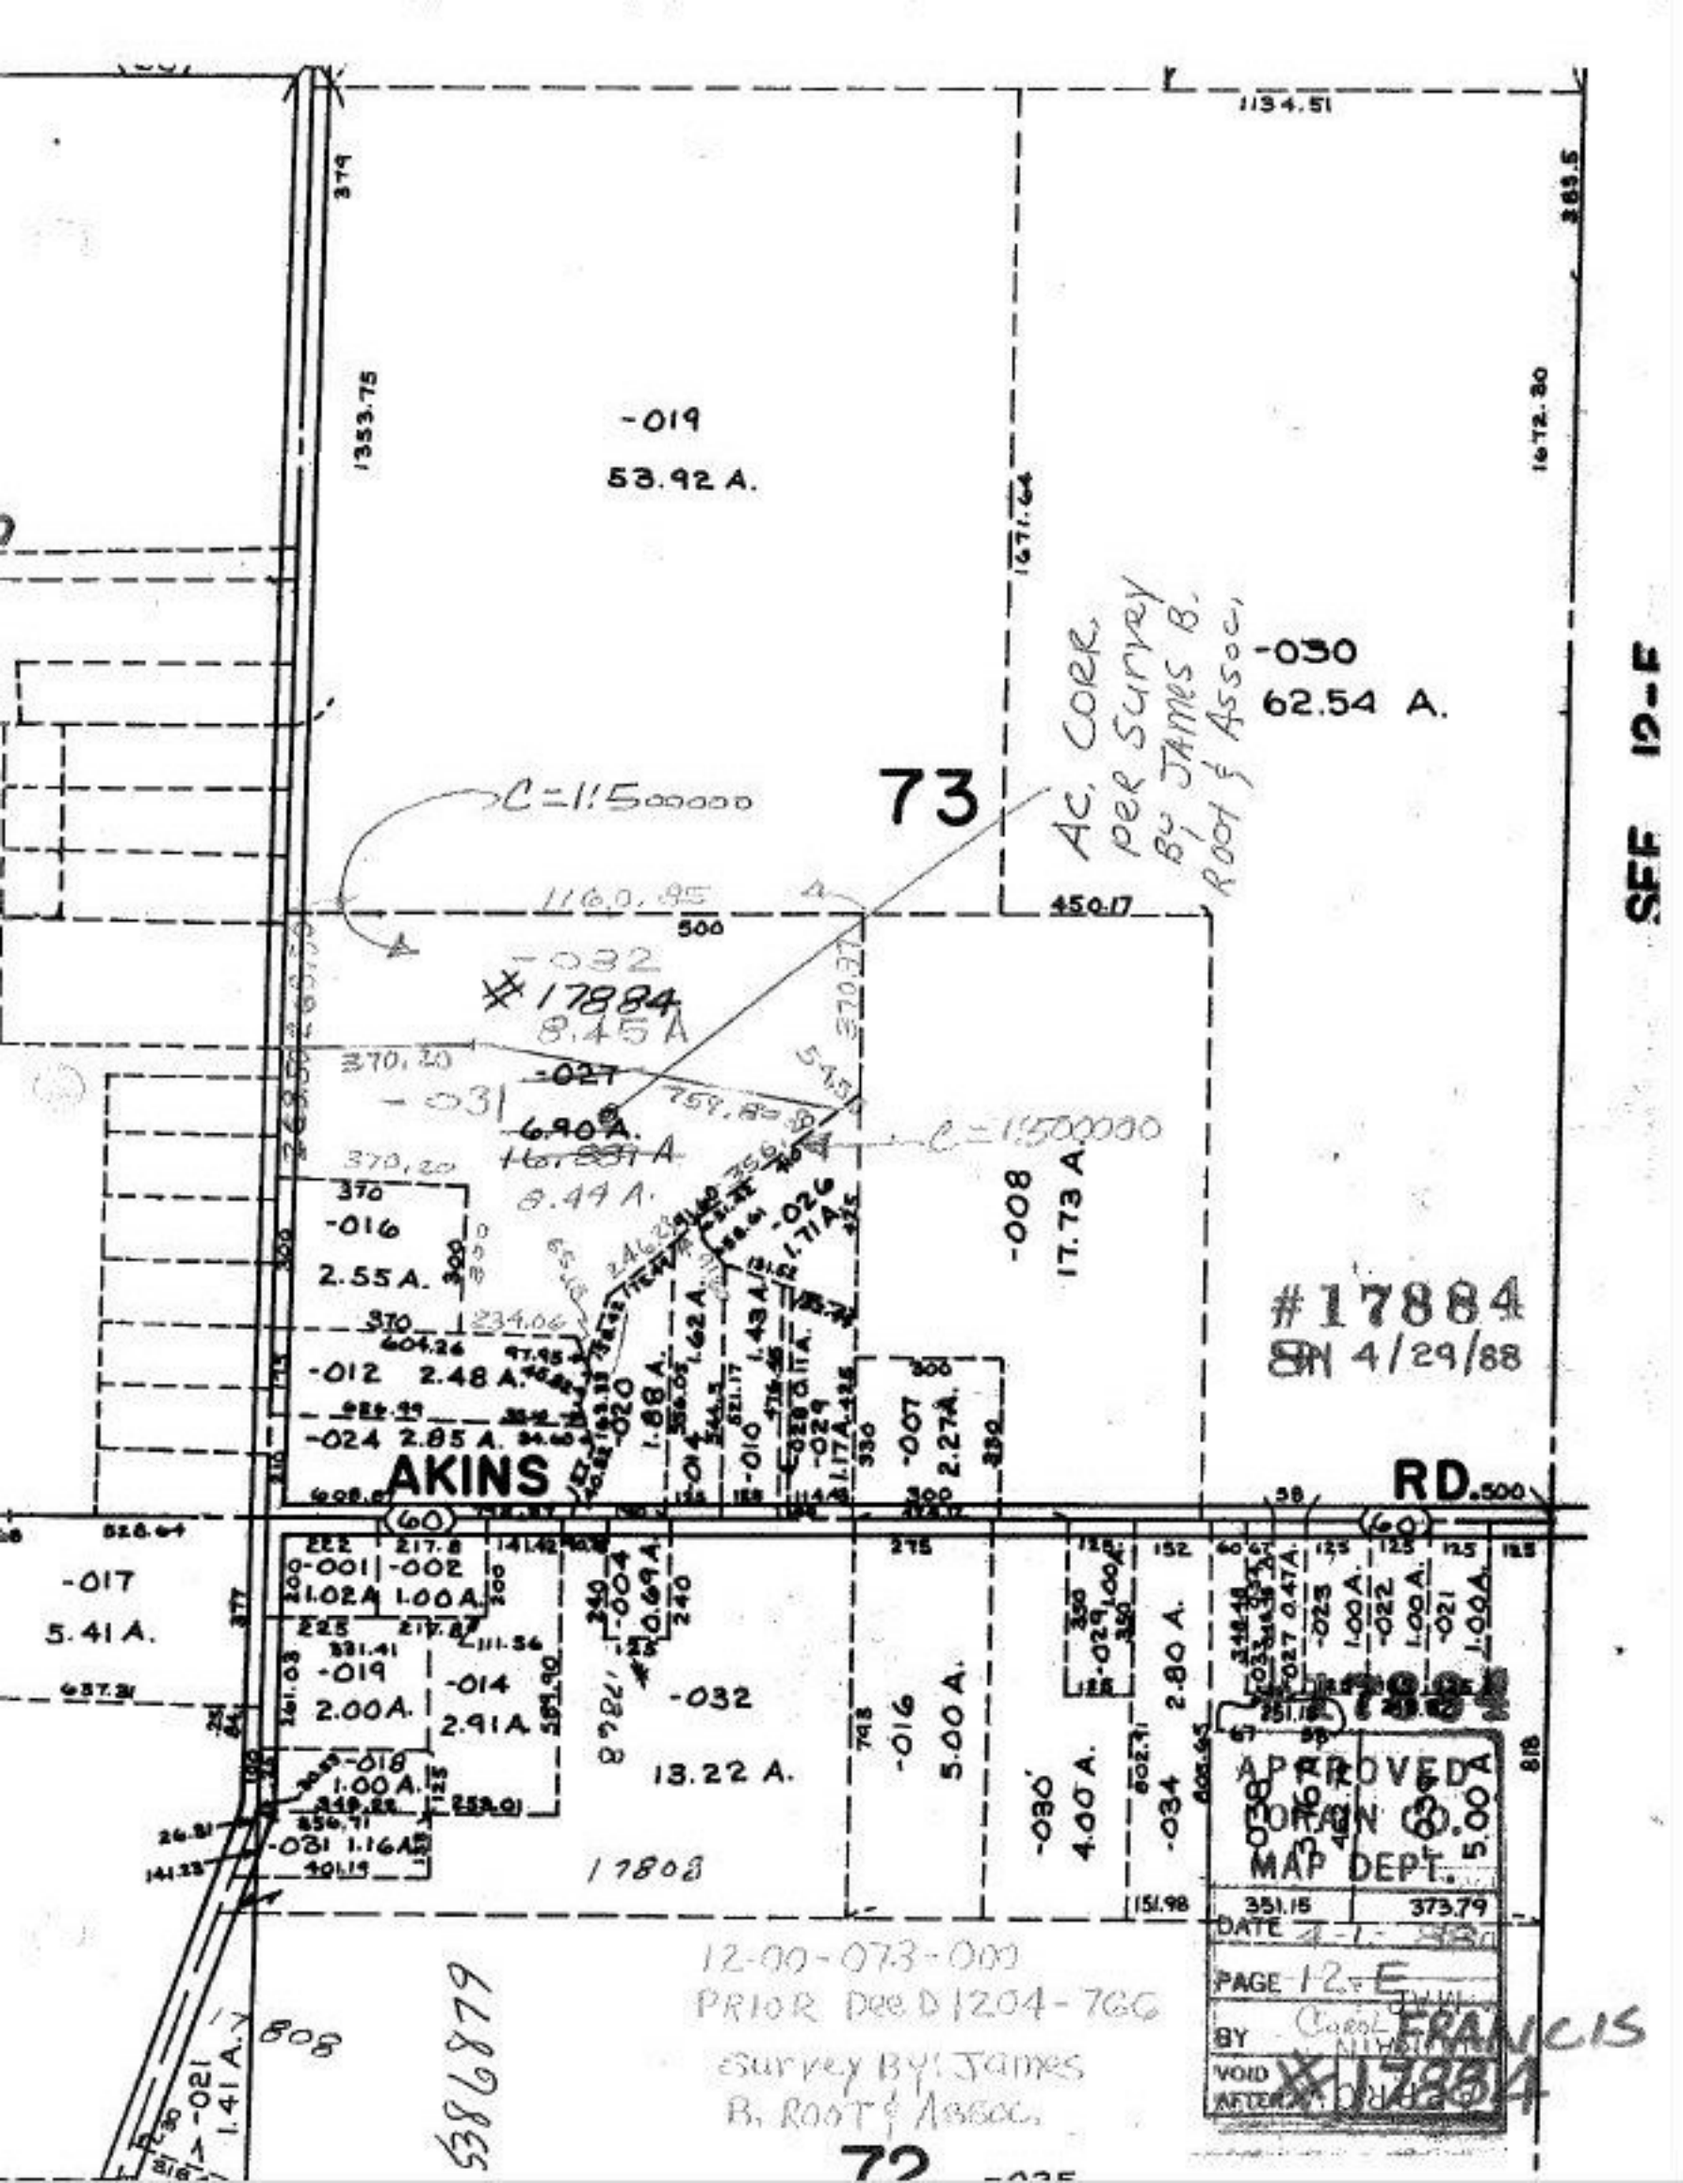
1134.51
-019
53.92 A.
1353.75
1672.30
-030
62.54 A.
AC. CORR. per Survey By JAMES B. ROOT & Assoc.
73
C=1150000
1160.95
450.17
-032
#17884
8.45A
370.20
-027
6.90A.
-031
8.44A.
C=1500000
-008
17.73 A
-016
2.55 A.
-012 2.48 A.
-024 2.85 A.
-026
1.71A.
-029
1.17A.
-020
1.88 A.
-010
1.43A.
-007
2.27A.
#17884
SN 4/29/88
AKINS
RD.
60
-017
5.41 A.
-001 1.02A
-002 1.00A.
-019
2.00A.
-014
2.91A.
-018
1.00A.
-021 1.16A.
-004
0.69A.
-032
13.22 A.
-016
5.00 A.
-030
4.00 A.
-029
1.00A.
2.80 A.
-034
-038
-023
-022
-021
17884
APPROVED
MAP DEPT.
351.15
373.79
DATE 4-1-88
PAGE 12-E
BY Carol
VOID
AFTER
FRANCIS
#17884
538879
-021
1.41 A.
805
17808
12-00-073-000
PRIOR DEED 1204-766
Survey BY: James B. Root & Assoc.
72
SEE 12-F