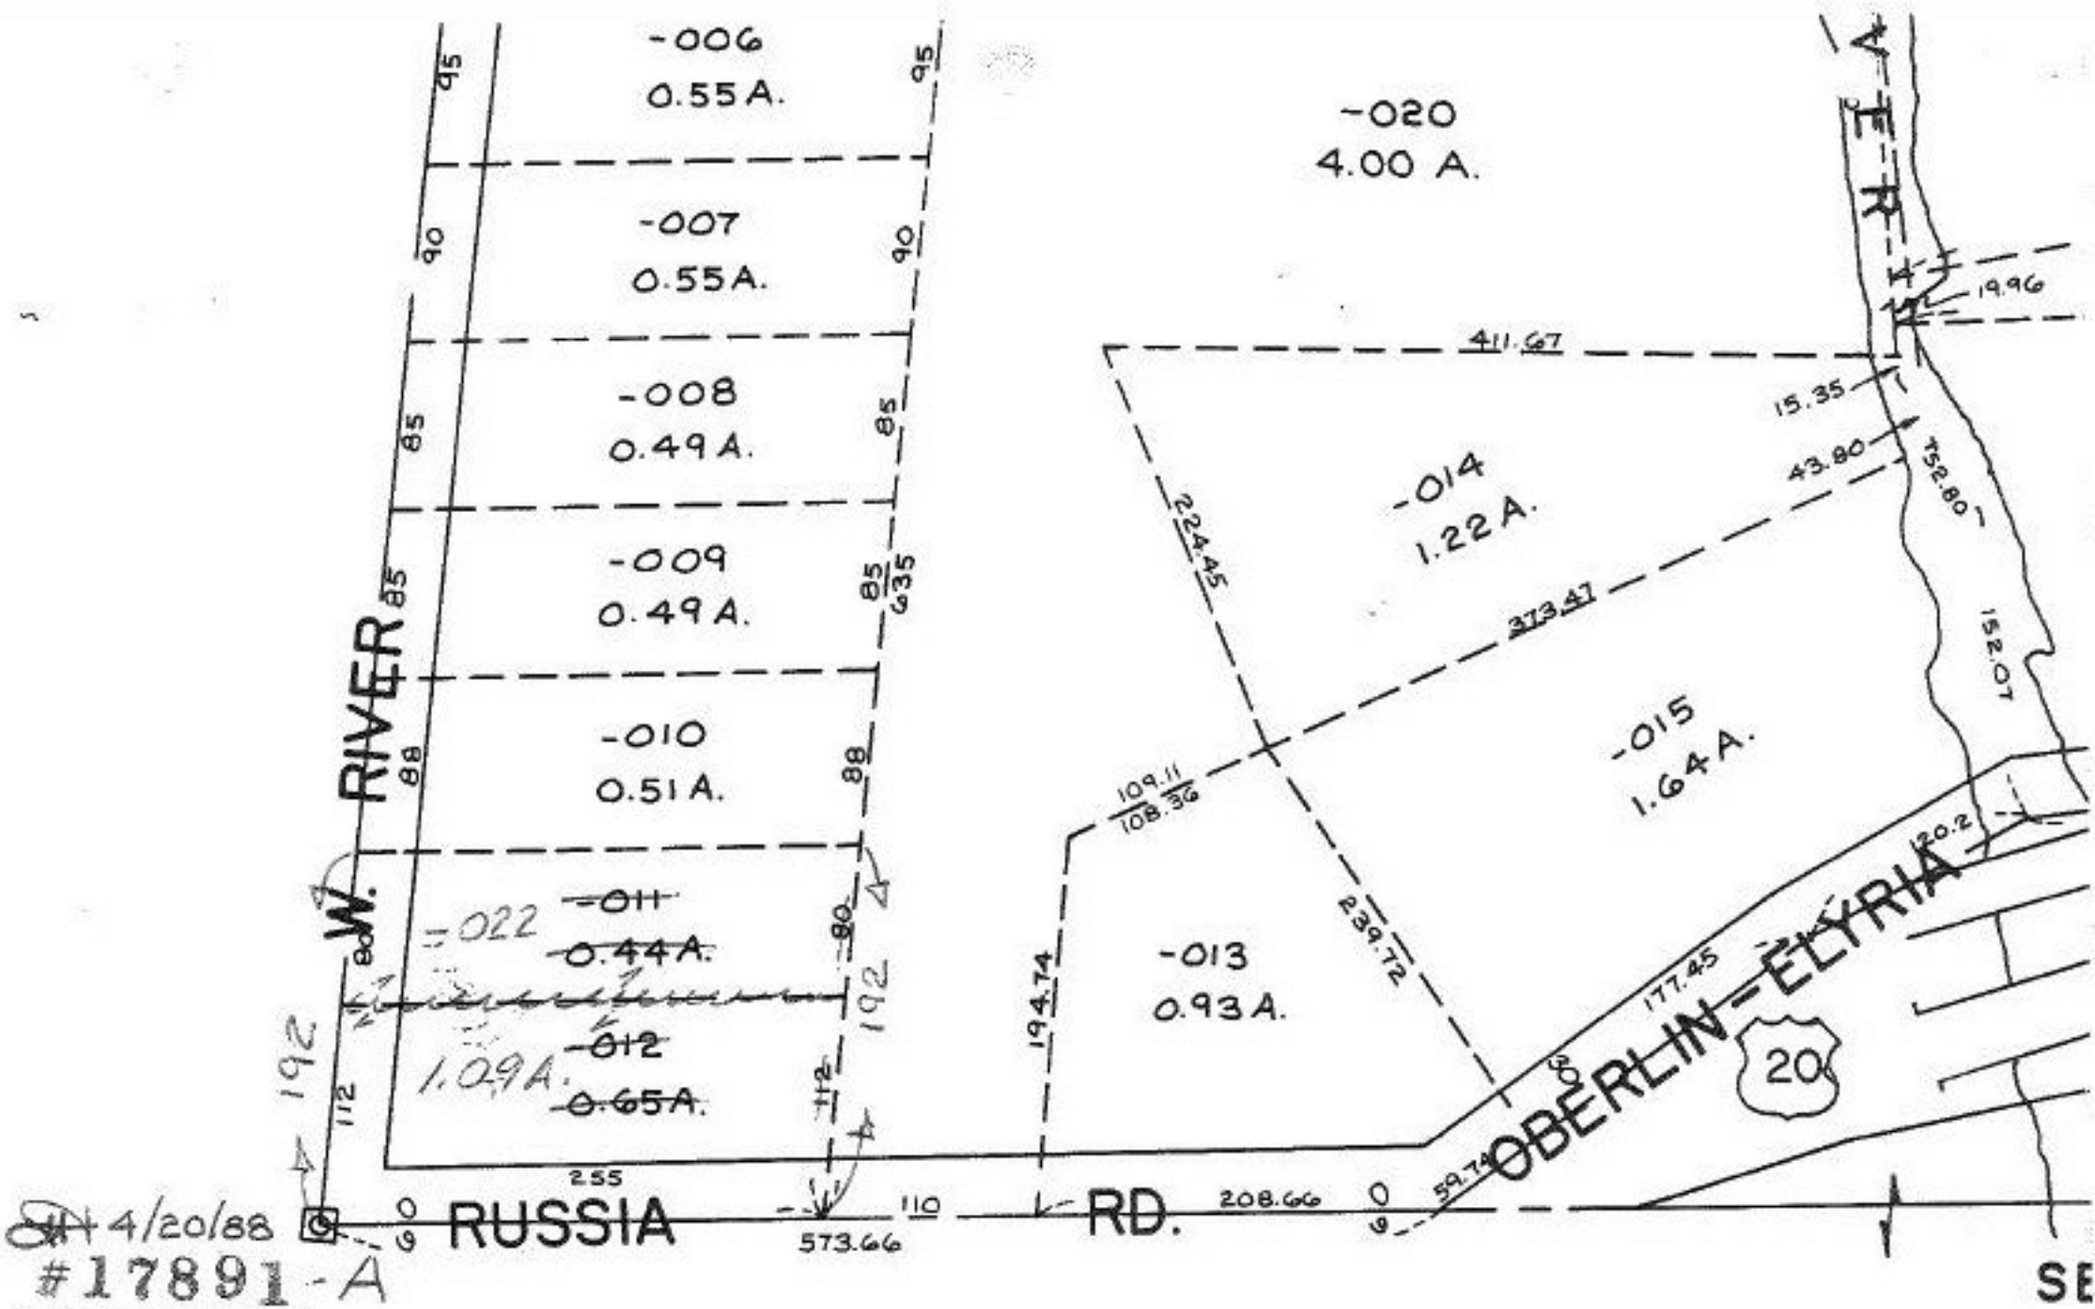

4/20/88

#17891-A

APPROVED
LORAIN CO.
MAP DEPT.

DATE 4-6-88

PAGE 10-00-003 F

BY CAROL FRANCIS

VOID 17891- A

COMBINATION

10-00-003-122-