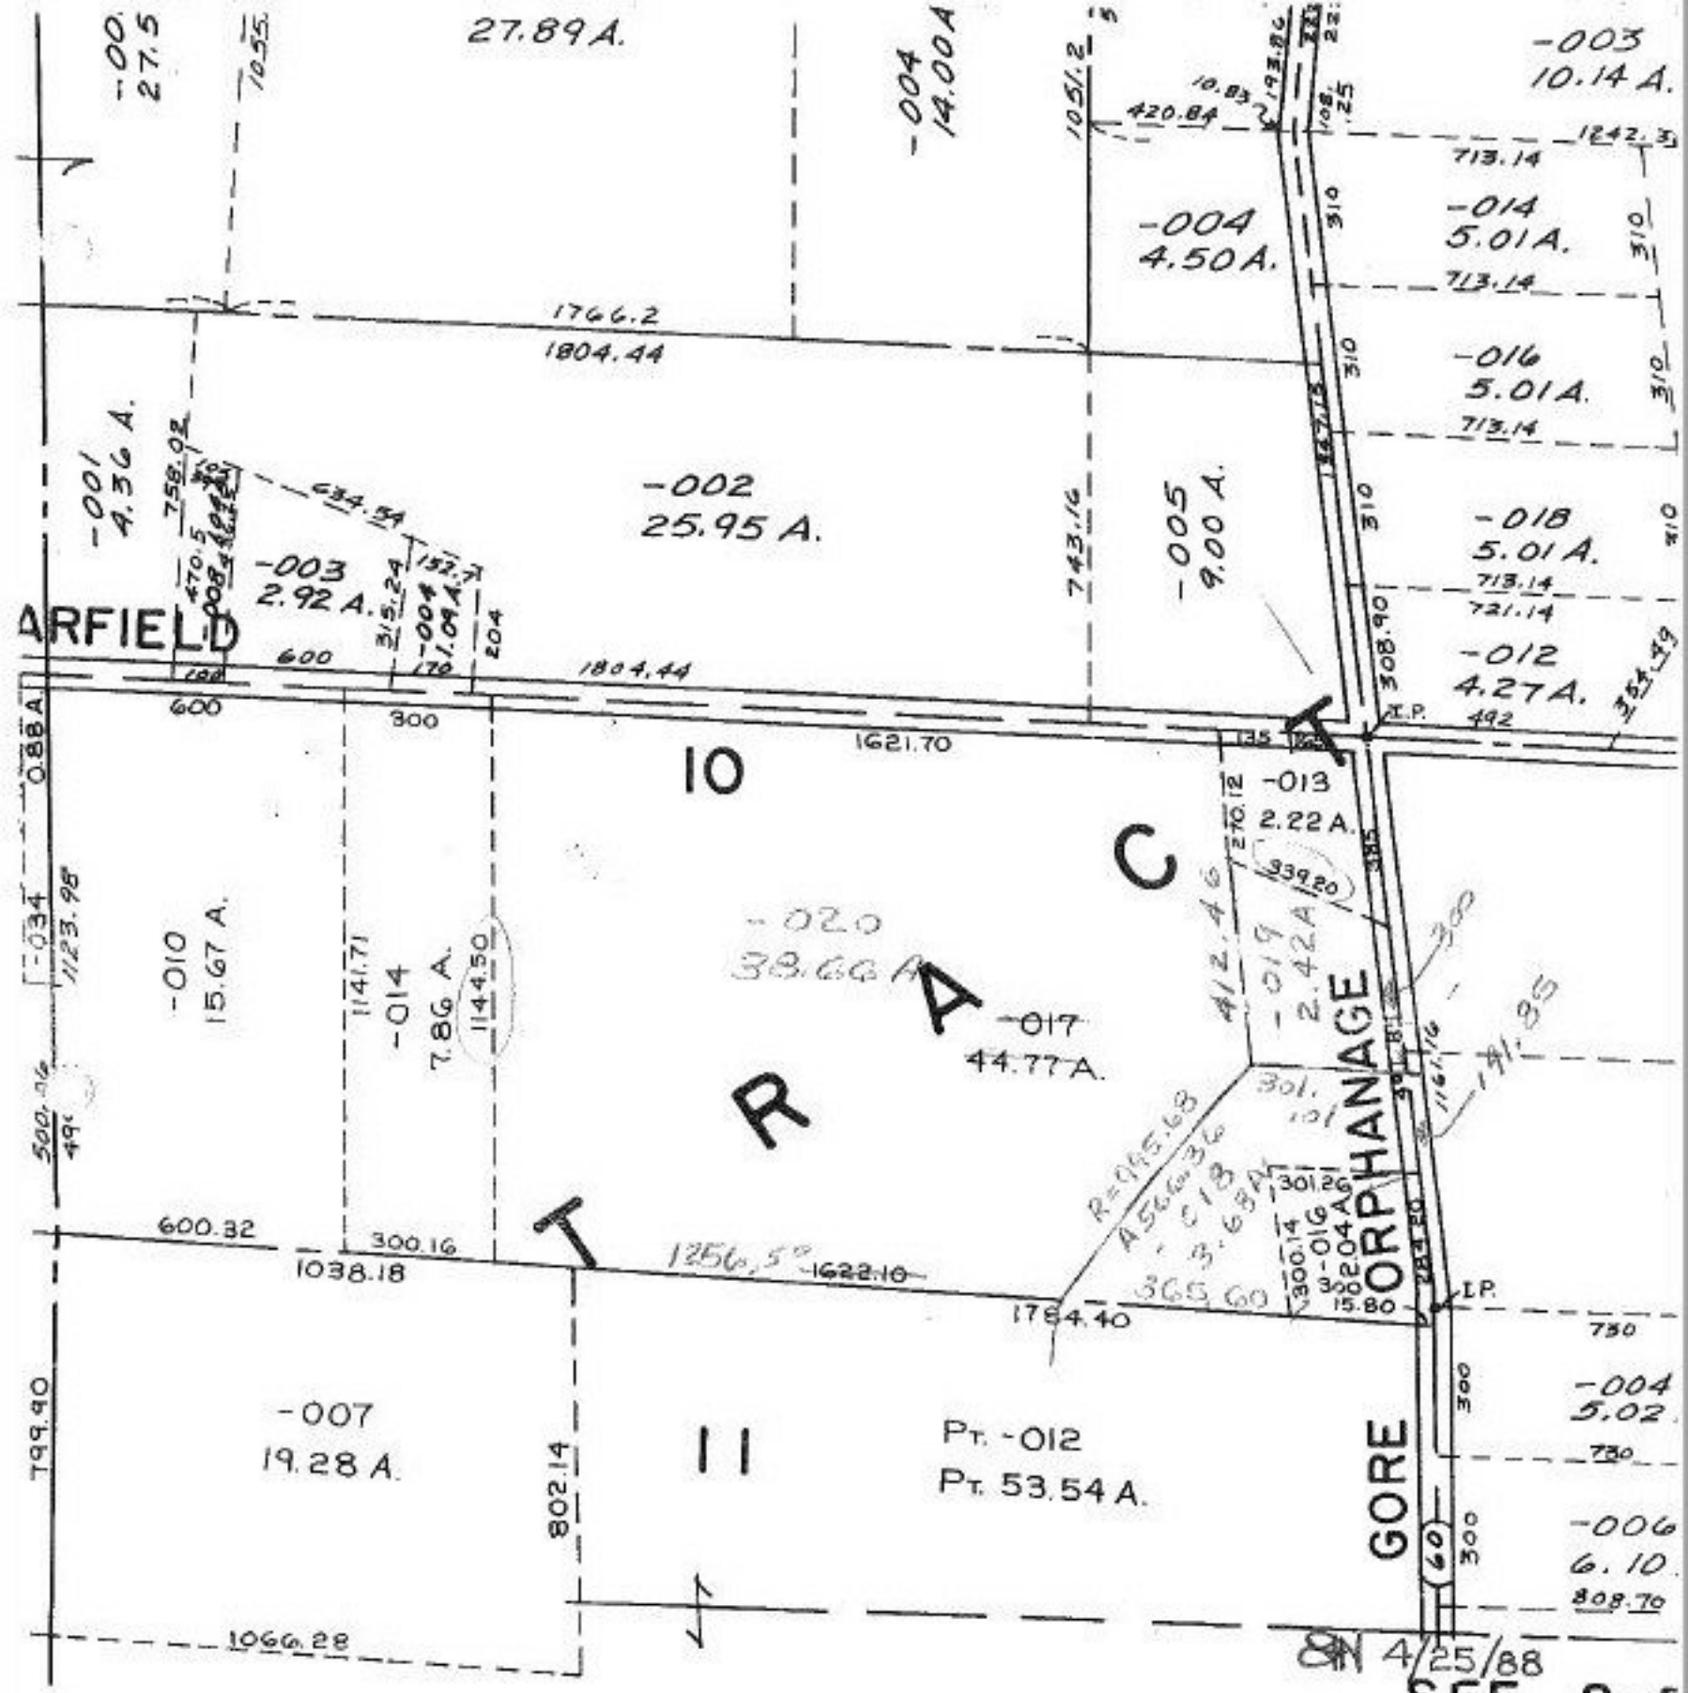

8N 4/25/88

SEE 8-E

#17892

APPROVED
LORAIN CO.
MAP DEPT.

DATE 4-5-88

PAGE 8-A

BY CAROL FRANCIS

VOID AFTER 17892

08-14-010-000

PRIOR Deed 1345 Pg. 650

SURVEY BY
WILLIAM B. BARTON
Reg. Surveyor

① C=1:200000
② C=1:166666