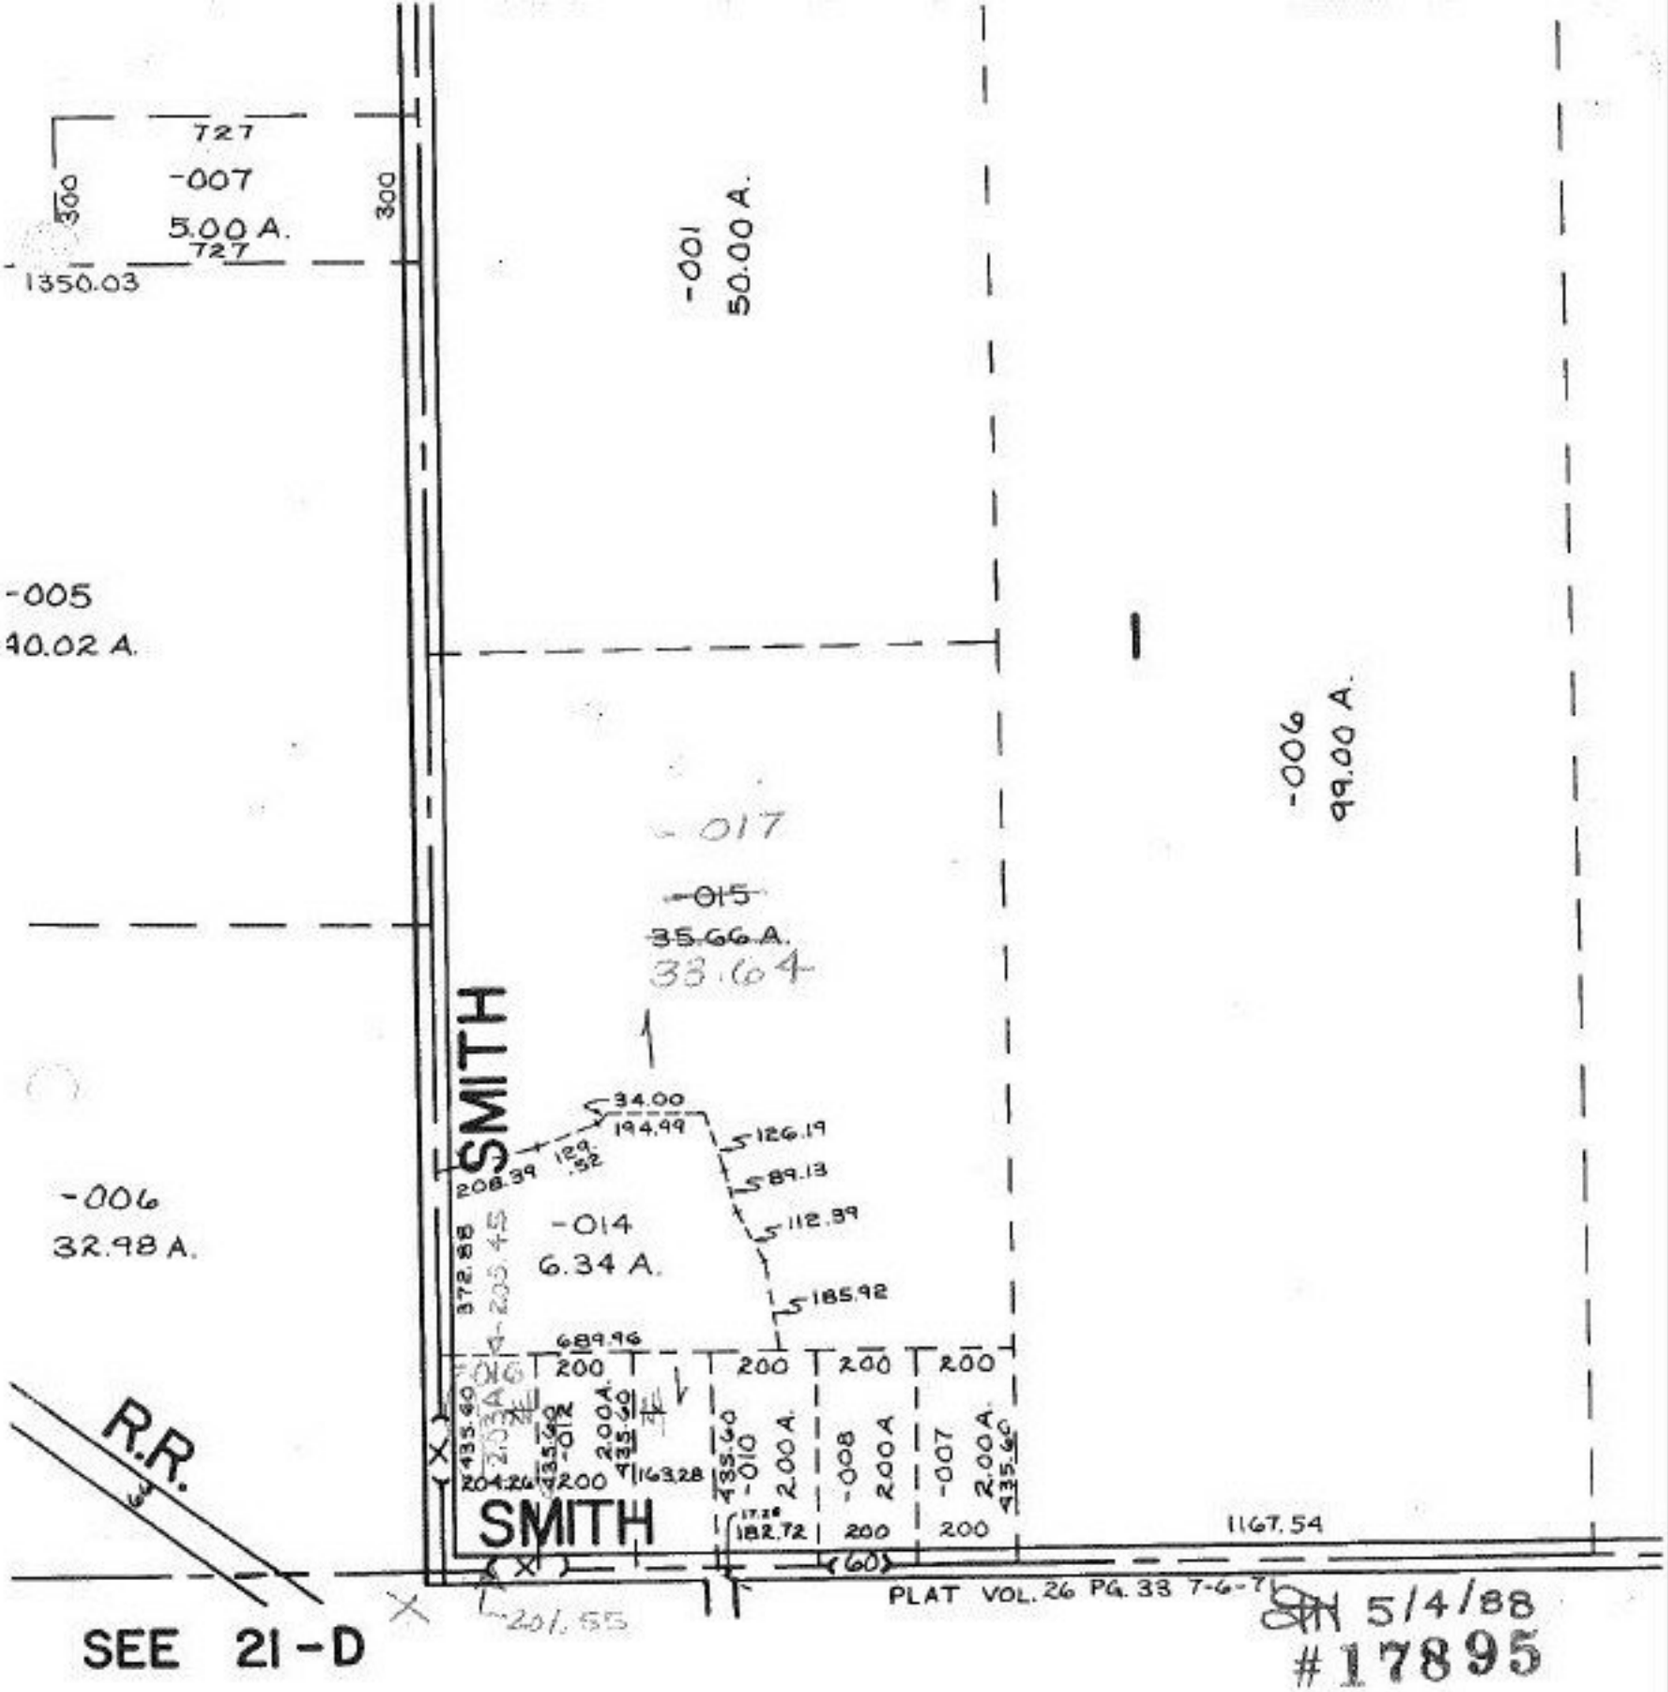


5/4/88
#17895

18-00-001-000

PRIOR 1180-383
DEED
SURVEY BY
WILLIAM B.
BARTON - Reg.
Surveyor
C=P 250000

| APPROVED LORAIN CO. MAP DEPT. | |
|---|---|
| DATE 4-6-88 | |
| PAGE 18-H | |
| BY Carol Francis | |
| VOID AFTER | 17895 |