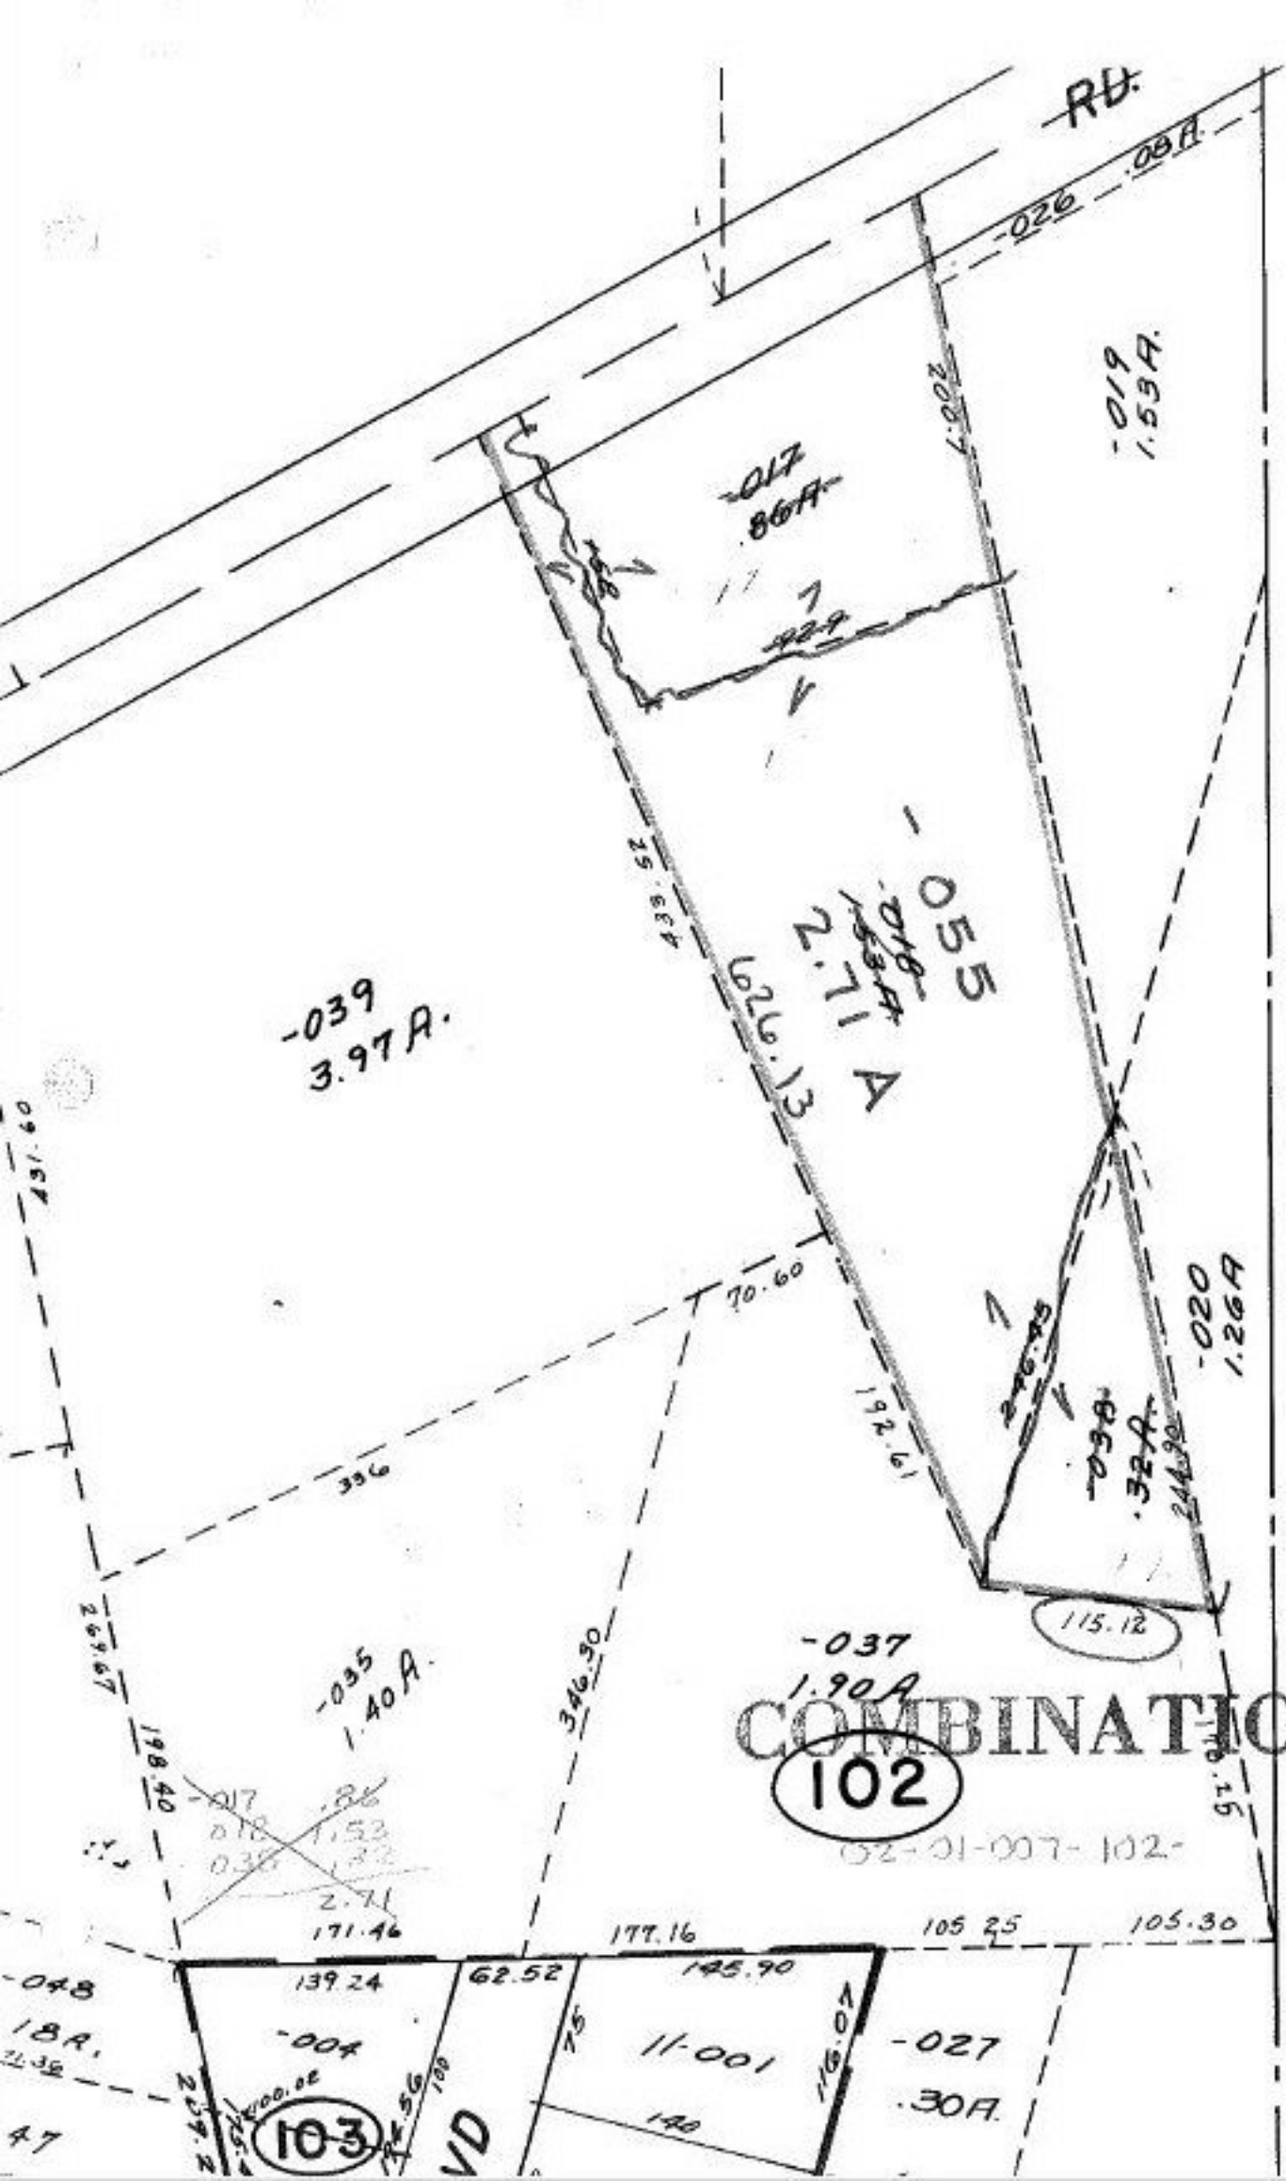

4/25/88
#17897-A

APPROVED
LORAIN CO.
MAP DEPT.
DATE 4-8-88
PAGE 2-01-007B
BY CAROL-FRANCIS
VOID AFTER ✕ 17897-A