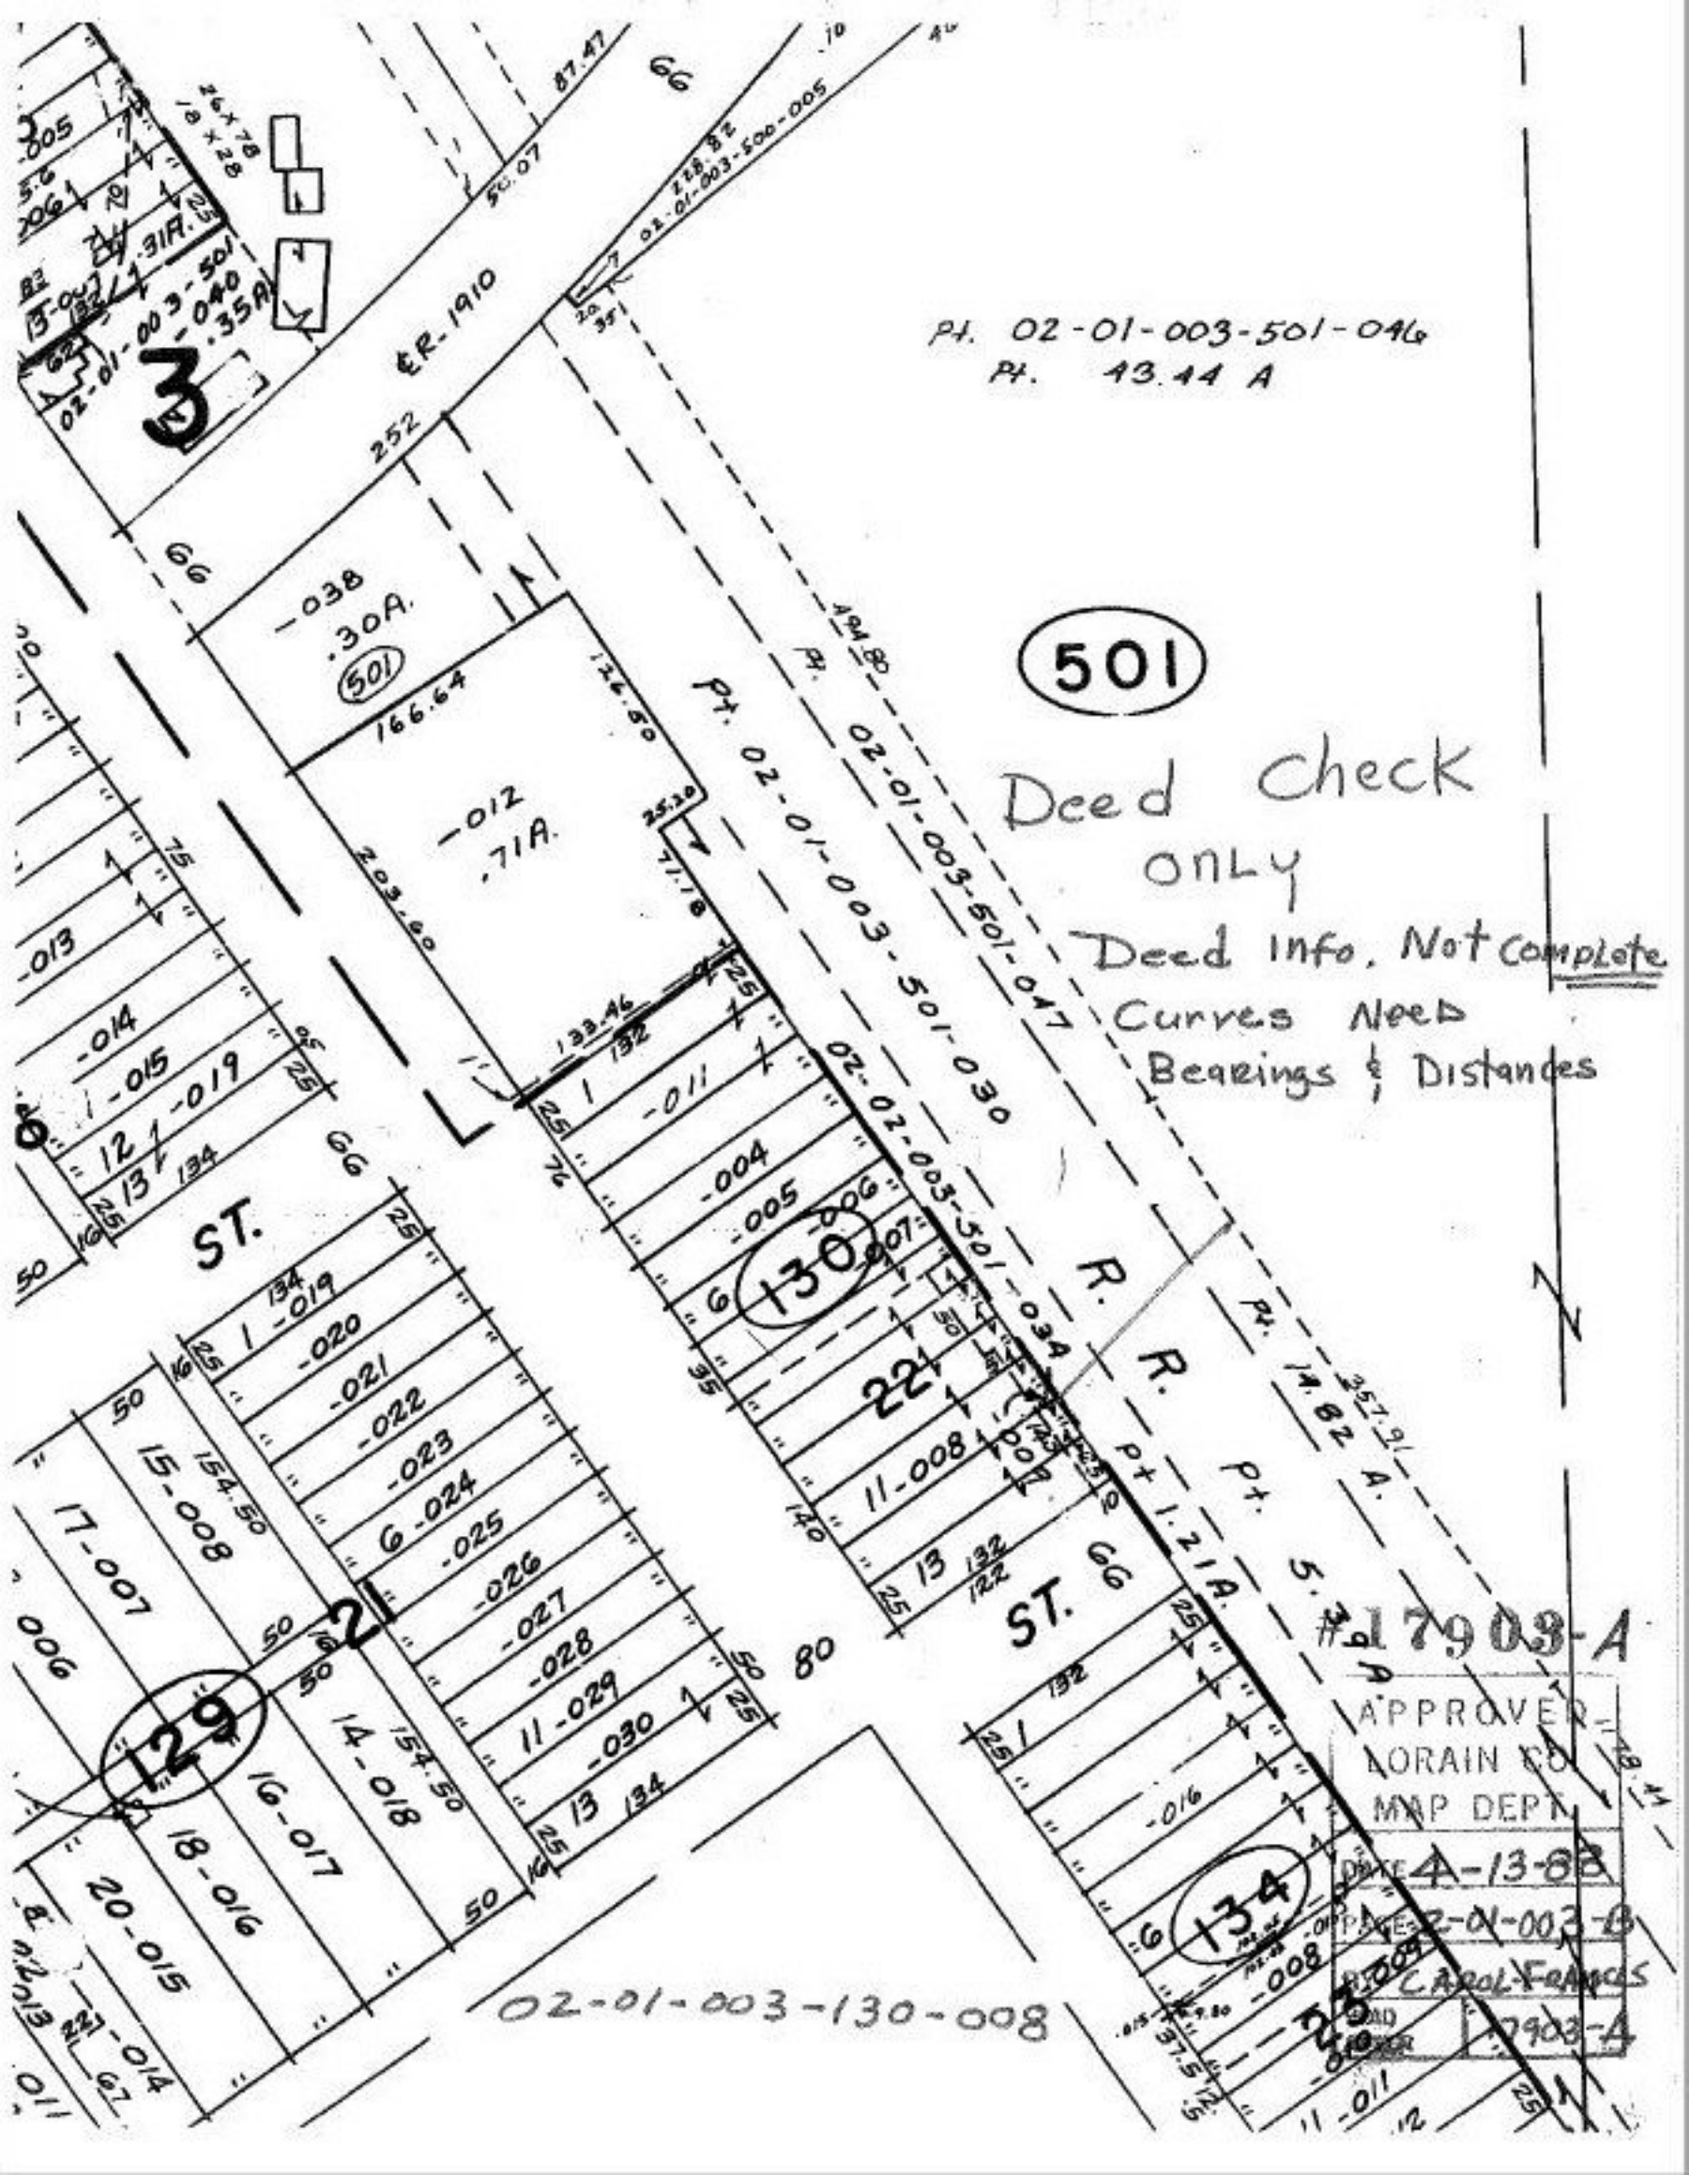
Pt. 02-01-003-501-046
Pt. 43.44 A
501
Deed Check
ONLY
Deed Info. Not Complete
Curves Need
Bearings & Distances
02-01-003-501-030
02-01-003-501-017
02-02-003-501-034
02-01-003-130-008
ER-1910
R. R.
ST.
#17903-A
APPROVED
LORAIN CO
MAP DEPT
DATE 4-13-88
CARROL FRANCIS
17903-A