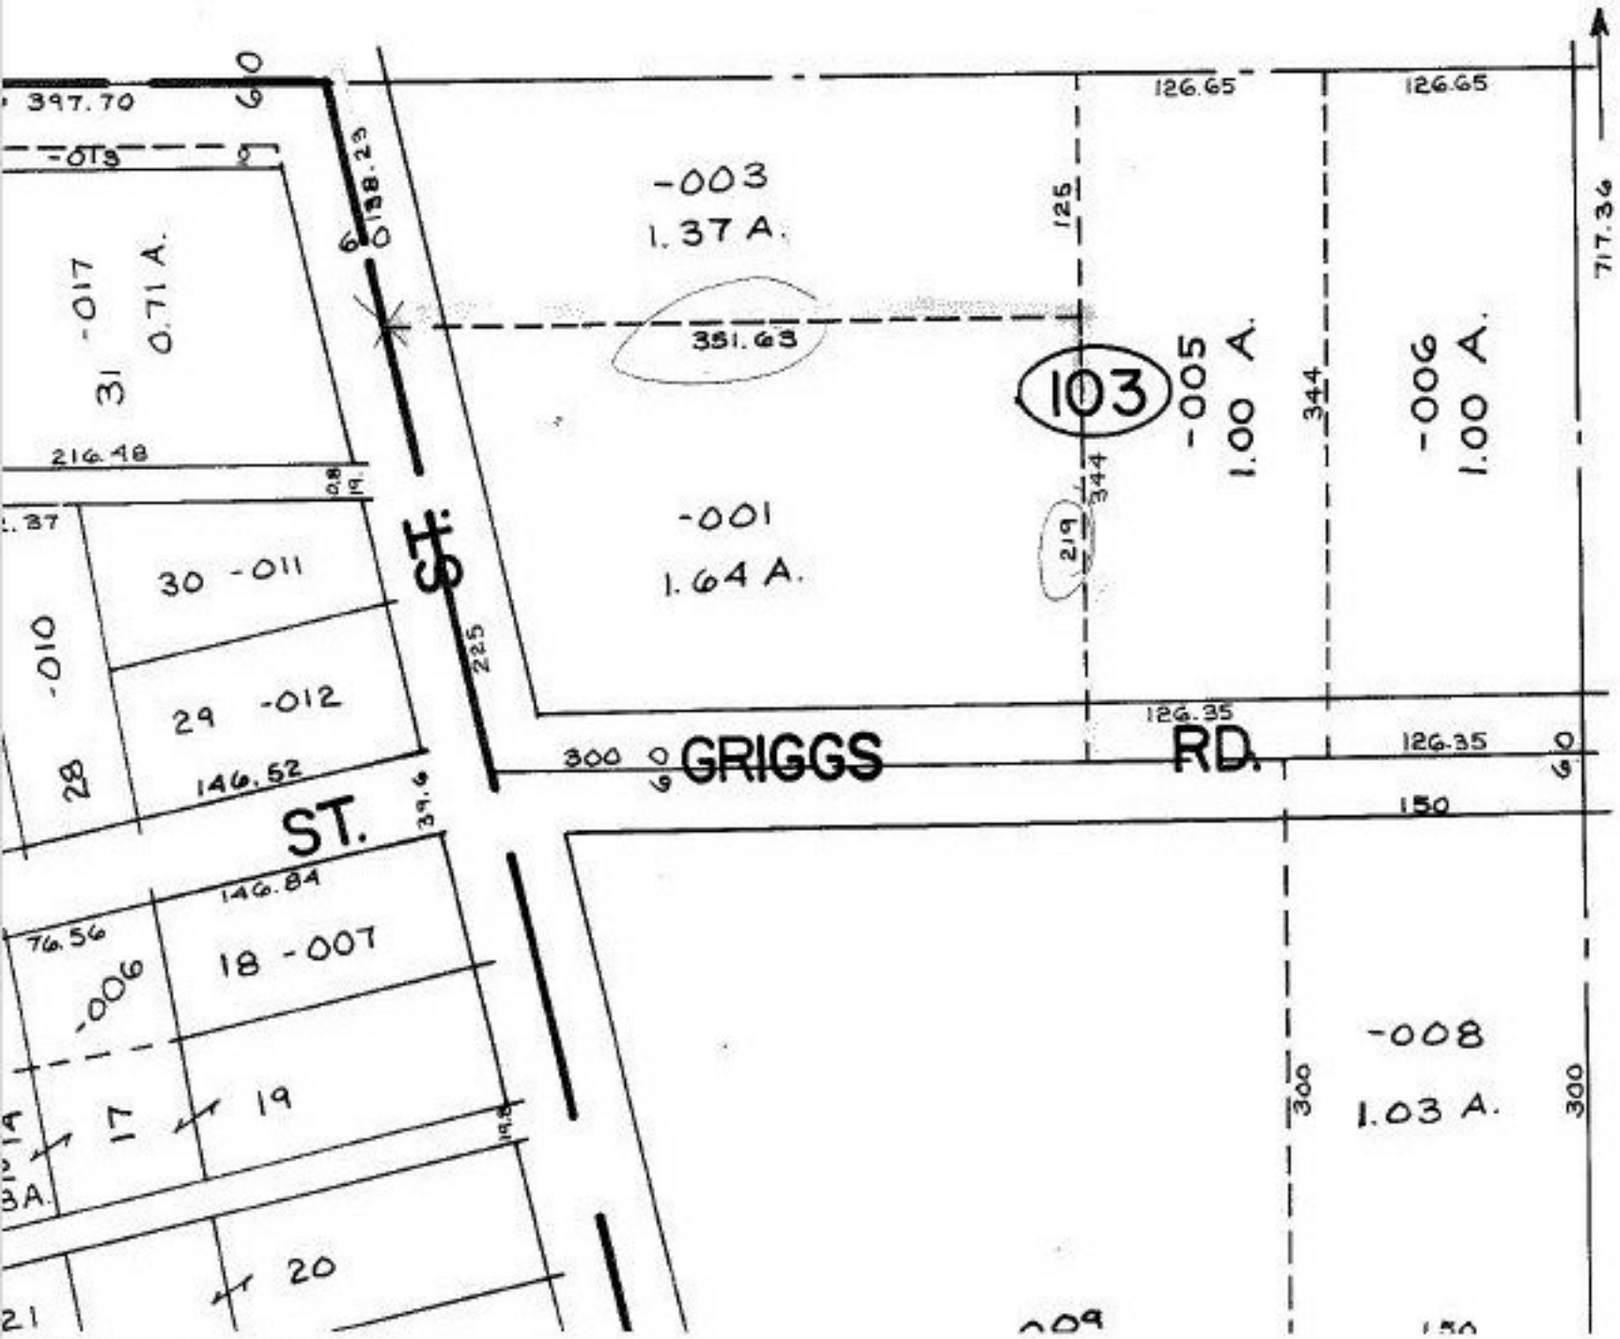
397.70
60
-013
-017
0.71 A.
31
216.48
138.23
-003
1.37 A.
125
126.65
126.65
717.34
351.63
103
-005
1.00 A.
344
-006
1.00 A.
-001
1.64 A.
344
219
ST.
225
30 -011
-010
29 -012
28
146.52
ST.
39.6
300
GRIGGS
RD.
126.35
126.35
60
150
146.84
76.56
18 -007
-006
17
19
19.8
20
21
-008
1.03 A.
300
300