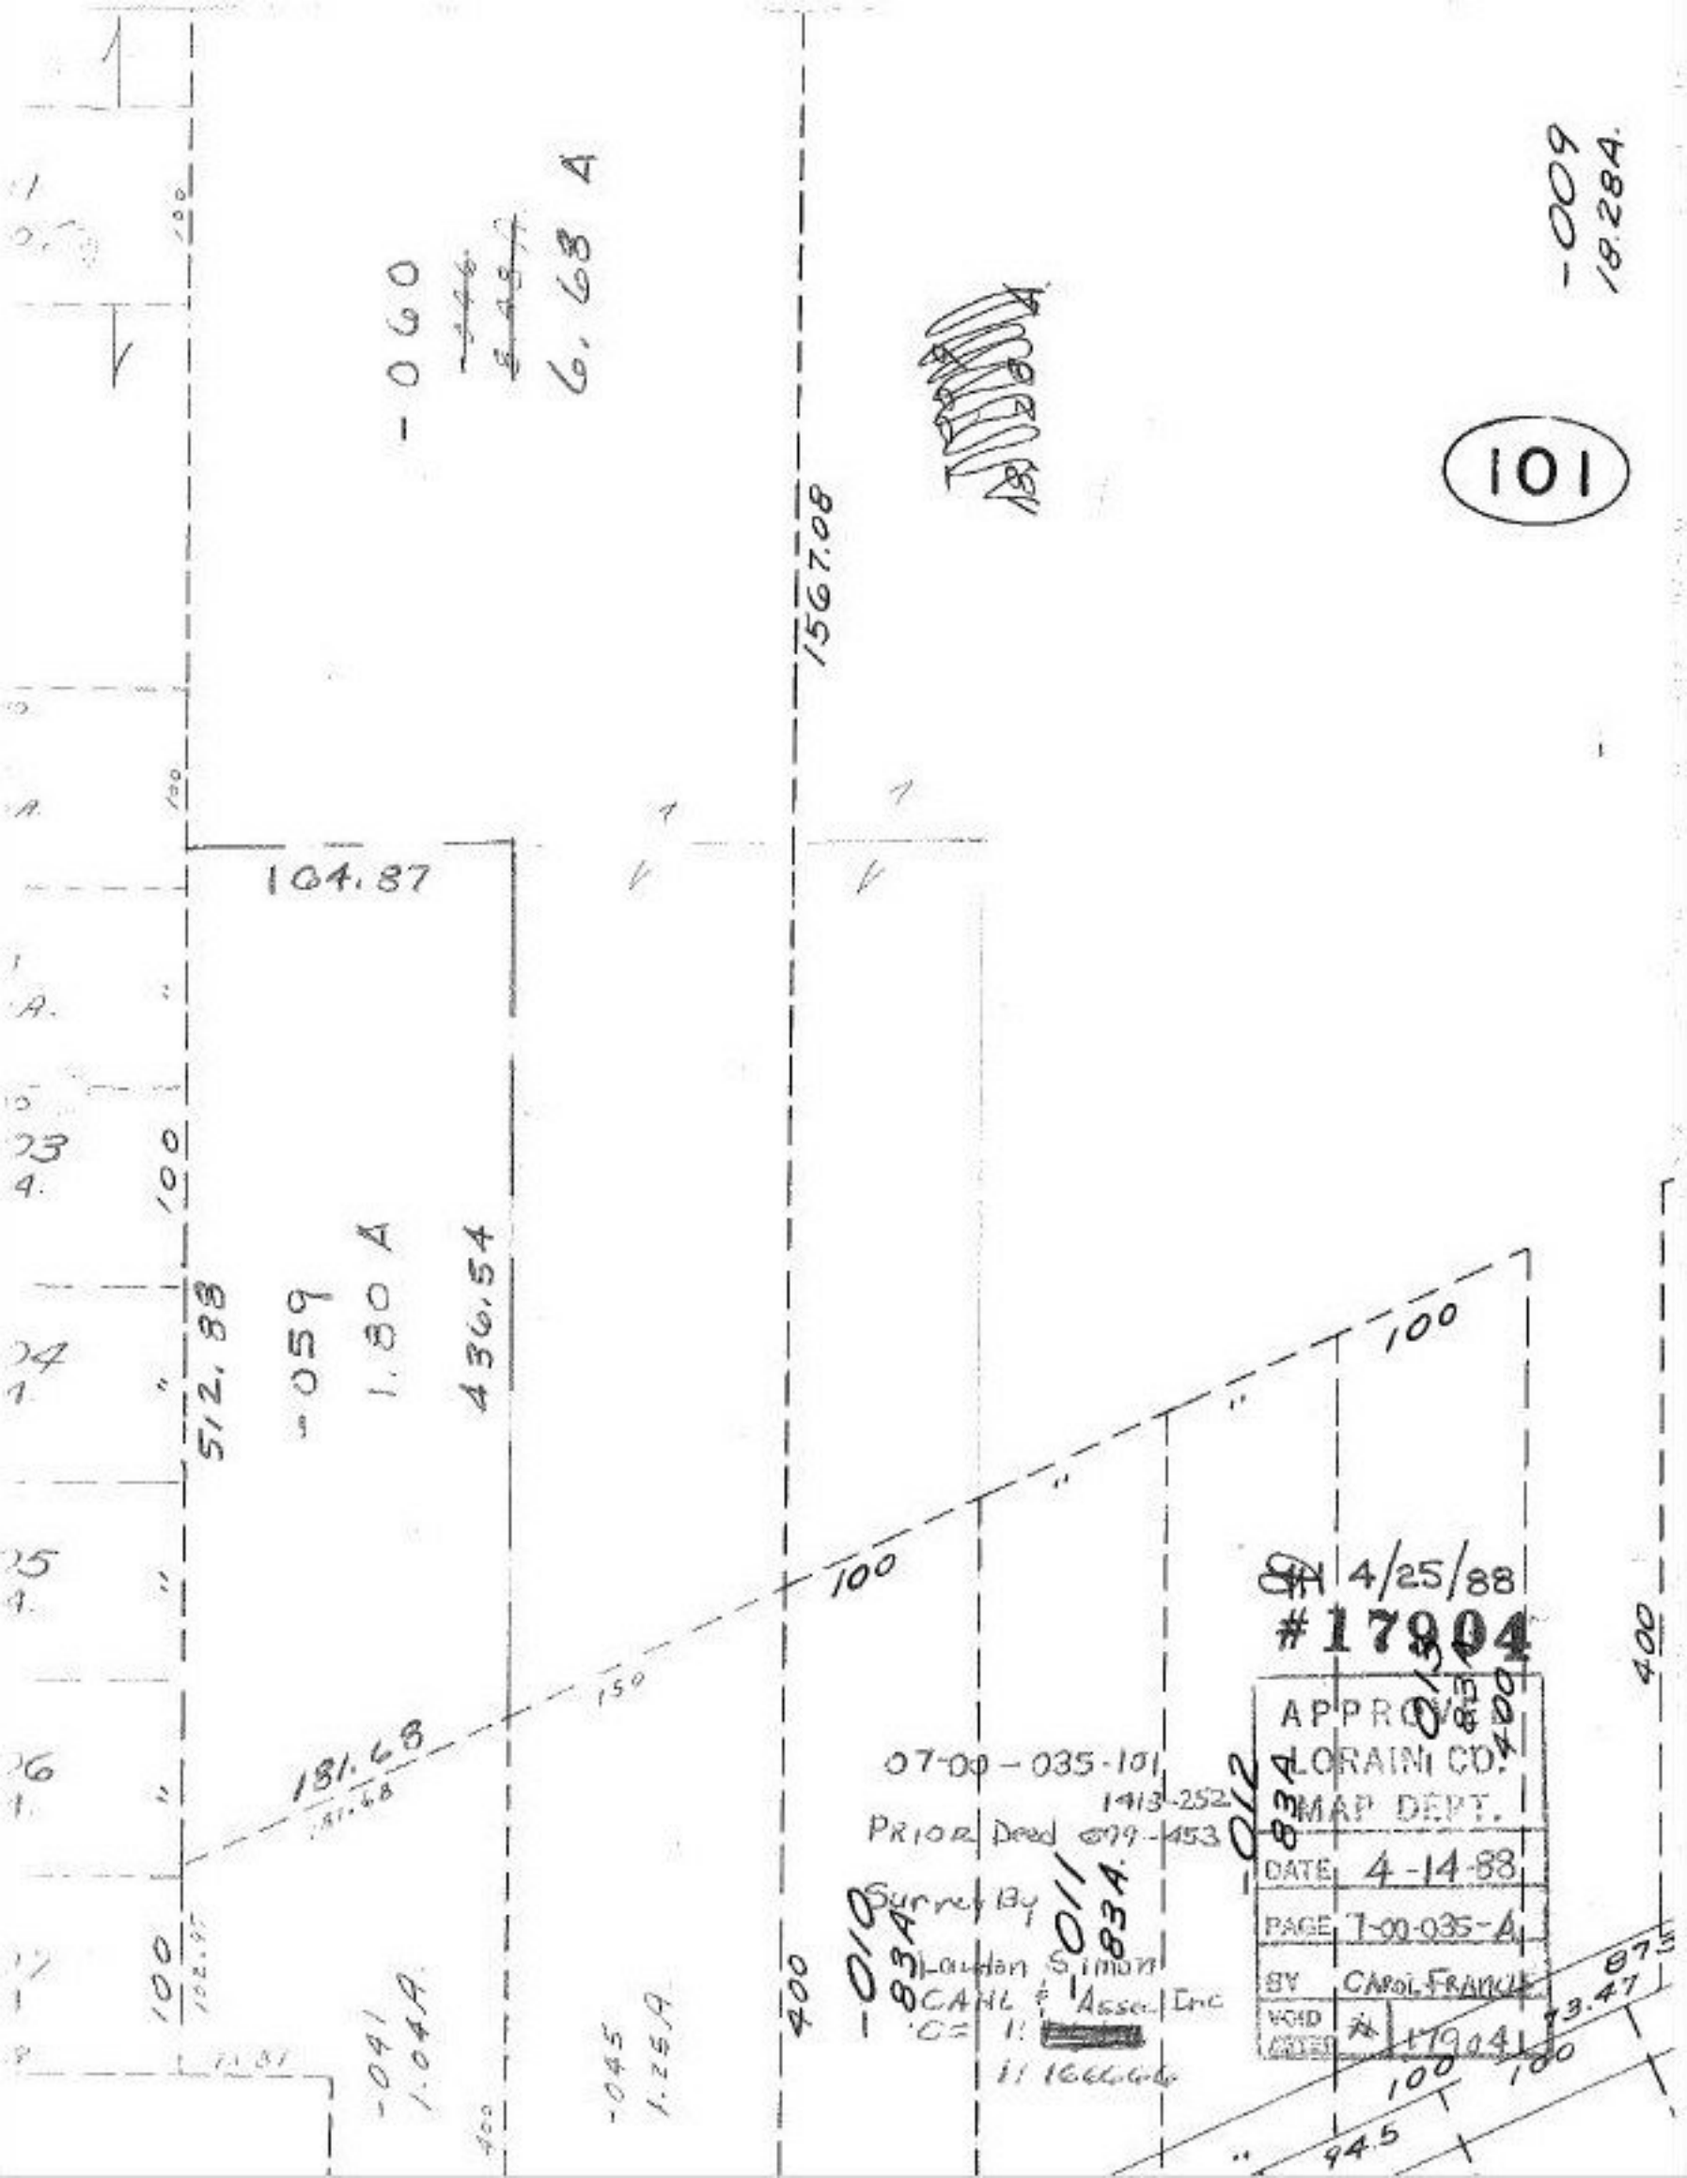
101
-009
18.28A.
-060
6.68 A
1567.08
104.87
512.88
-059
1.80 A
436.54
181.68
100
150
400
-041
1.04A
-045
1.25A
-010
83A
-011
83A
-012
83A
-013
83A
07-00-035-101
1413-252
PRIOR Deed 079-453
Surrey By
Landon Simon
CAHL & Assoc Inc
C= 1: [redacted]
1: 166666
4/25/88
#17904
APPROVED
LORAIN CO.
MAP DEPT.
DATE 4-14-88
PAGE 7-00-035-A
BY CAROL FRANCIS
VOID
ASTER
17904
73.47
94.5