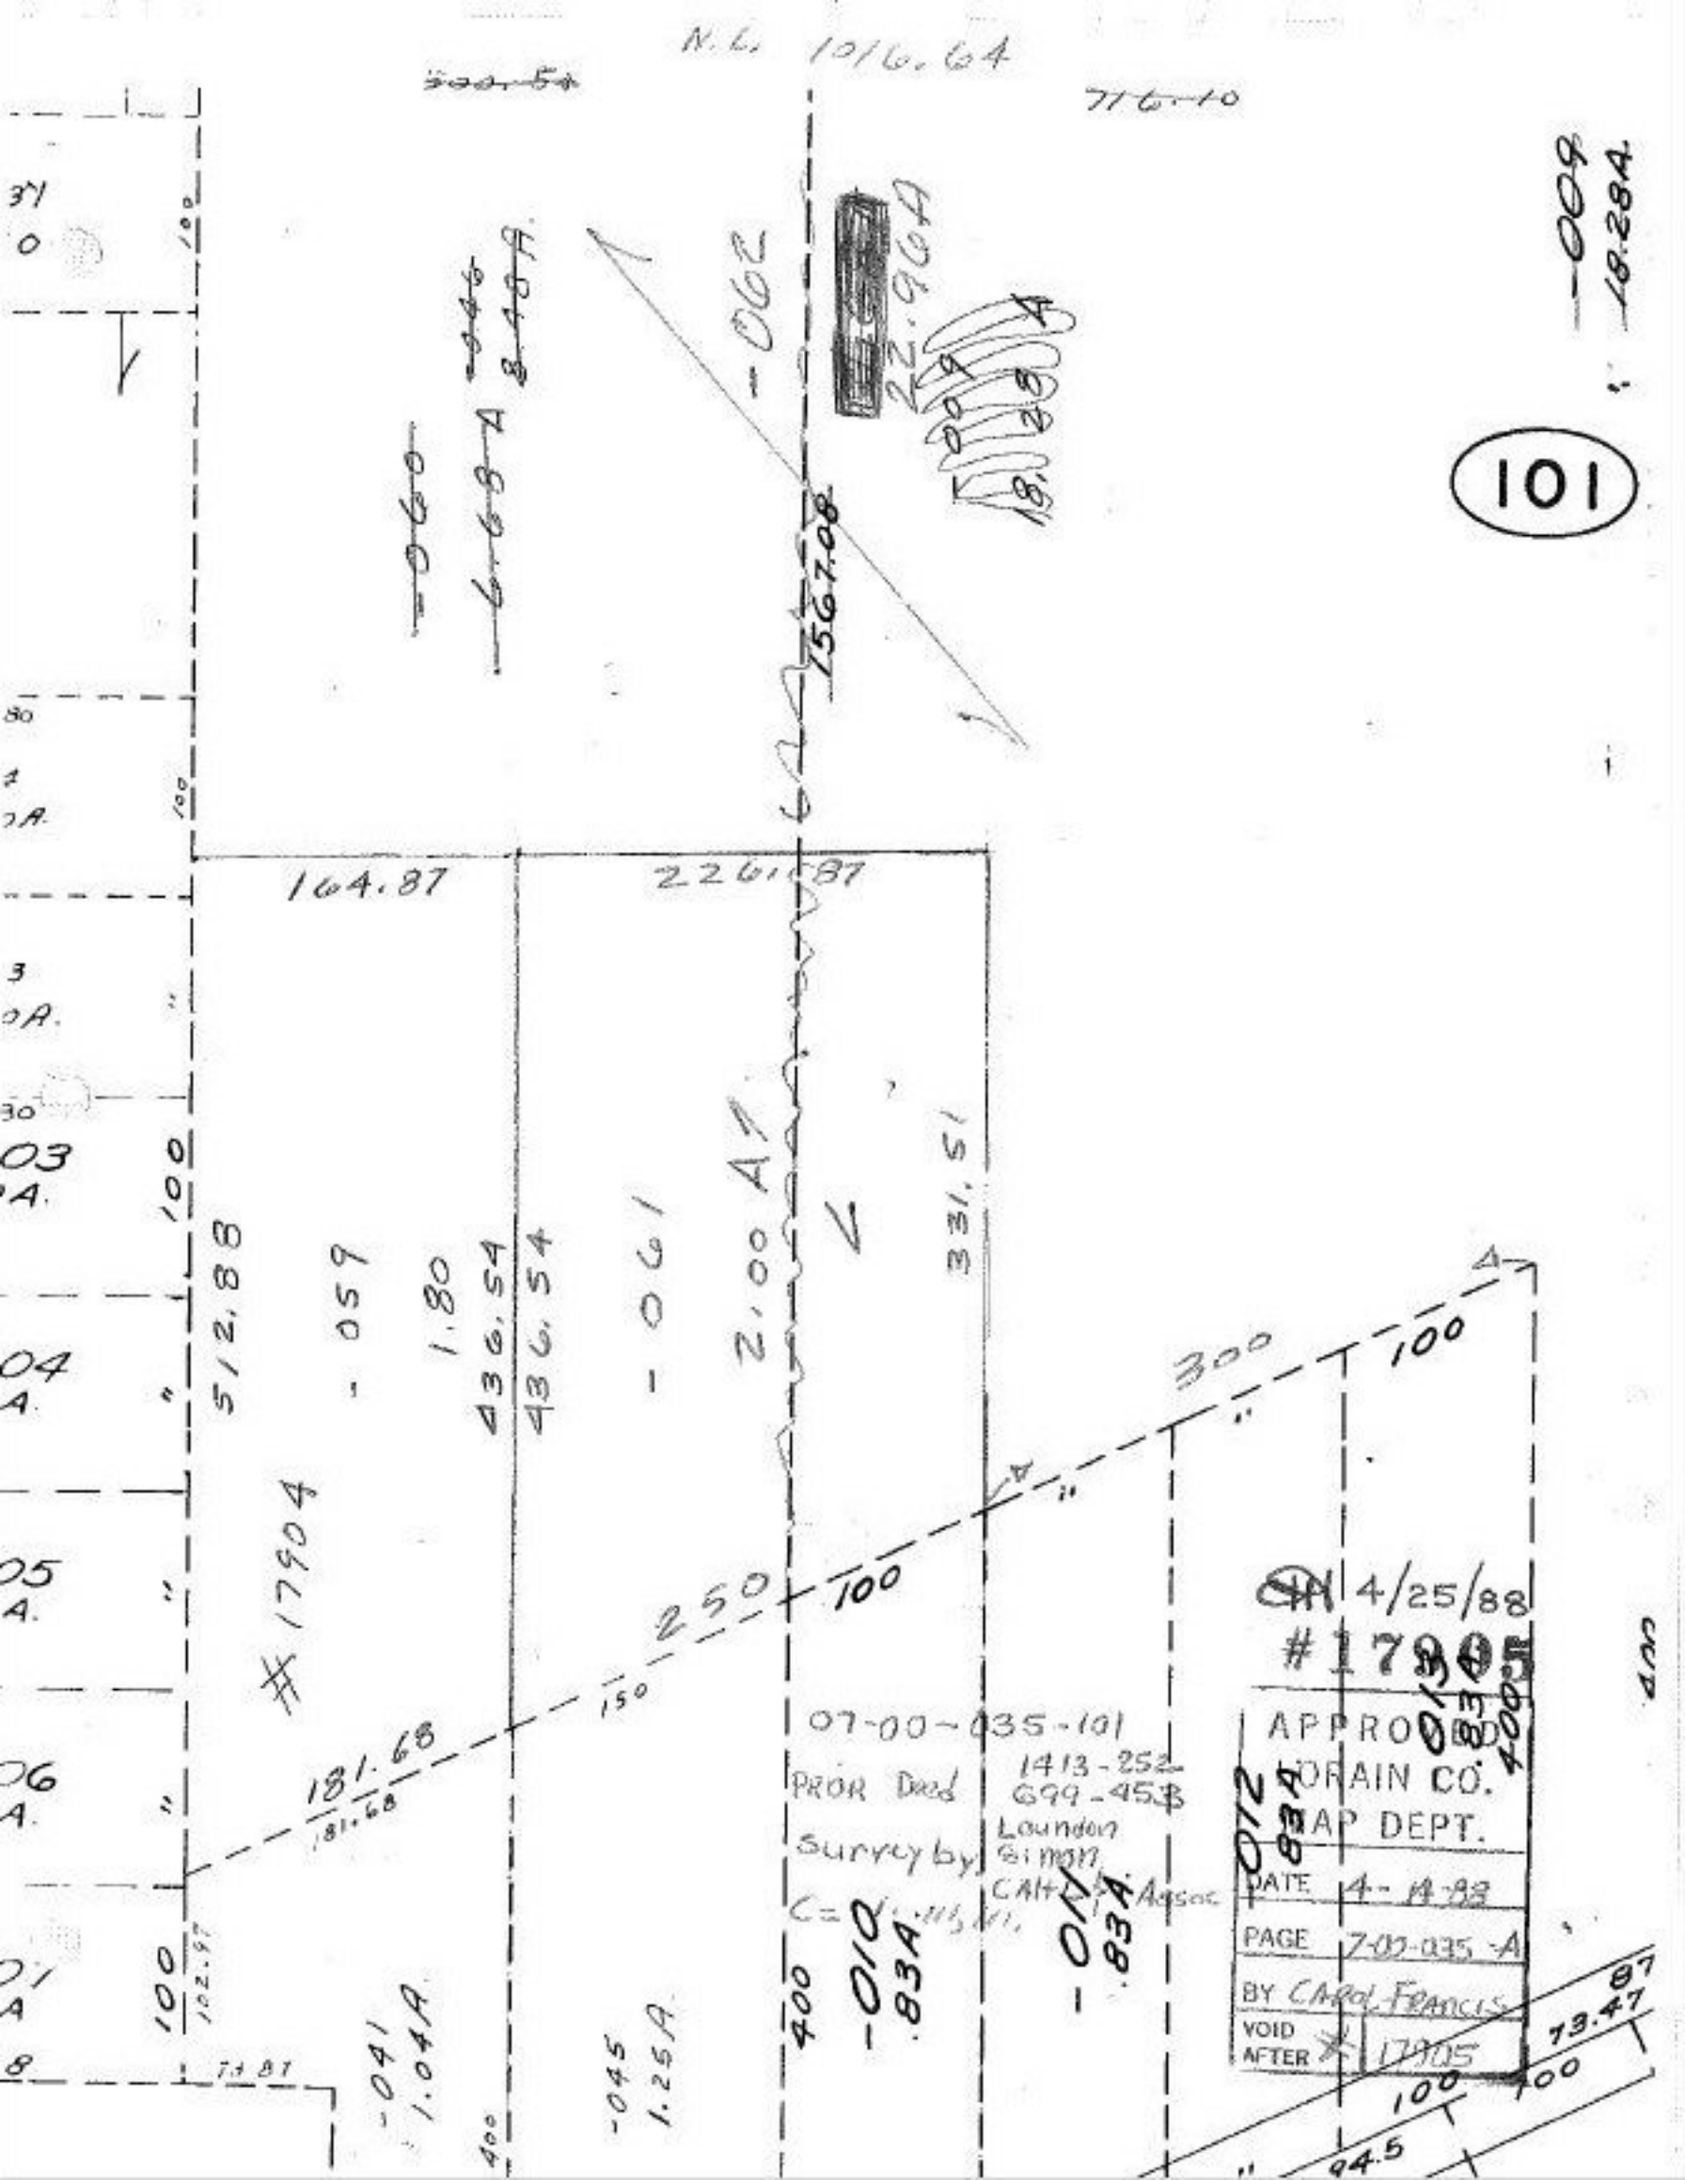
N. L. 1016.64
776.10
-009
18.284
101
-062
22.904
-060
6.693 A
8.46 A
1567.08
164.87
2261.87
2.00 AT
331.51
-059
1.80
436.54
436.54
512.88
#17904
-061
300
100
250
100
150
181.68
181.68
100
102.87
73.87
-041
1.04 A.
-045
1.25 A.
400
-010
.834
-011
.834
07-00-035-101
PRIOR Deed 1413-252
699-453
Launder
Survey by Simon
CALTEC Assoc
4/25/88
#17905
APPROVED
DRAIN CO.
MAP DEPT.
DATE 4-18-88
PAGE 7-07-035-A
BY Carol Francis
VOID AFTER # 17905
012
834
400
73.47
94.5