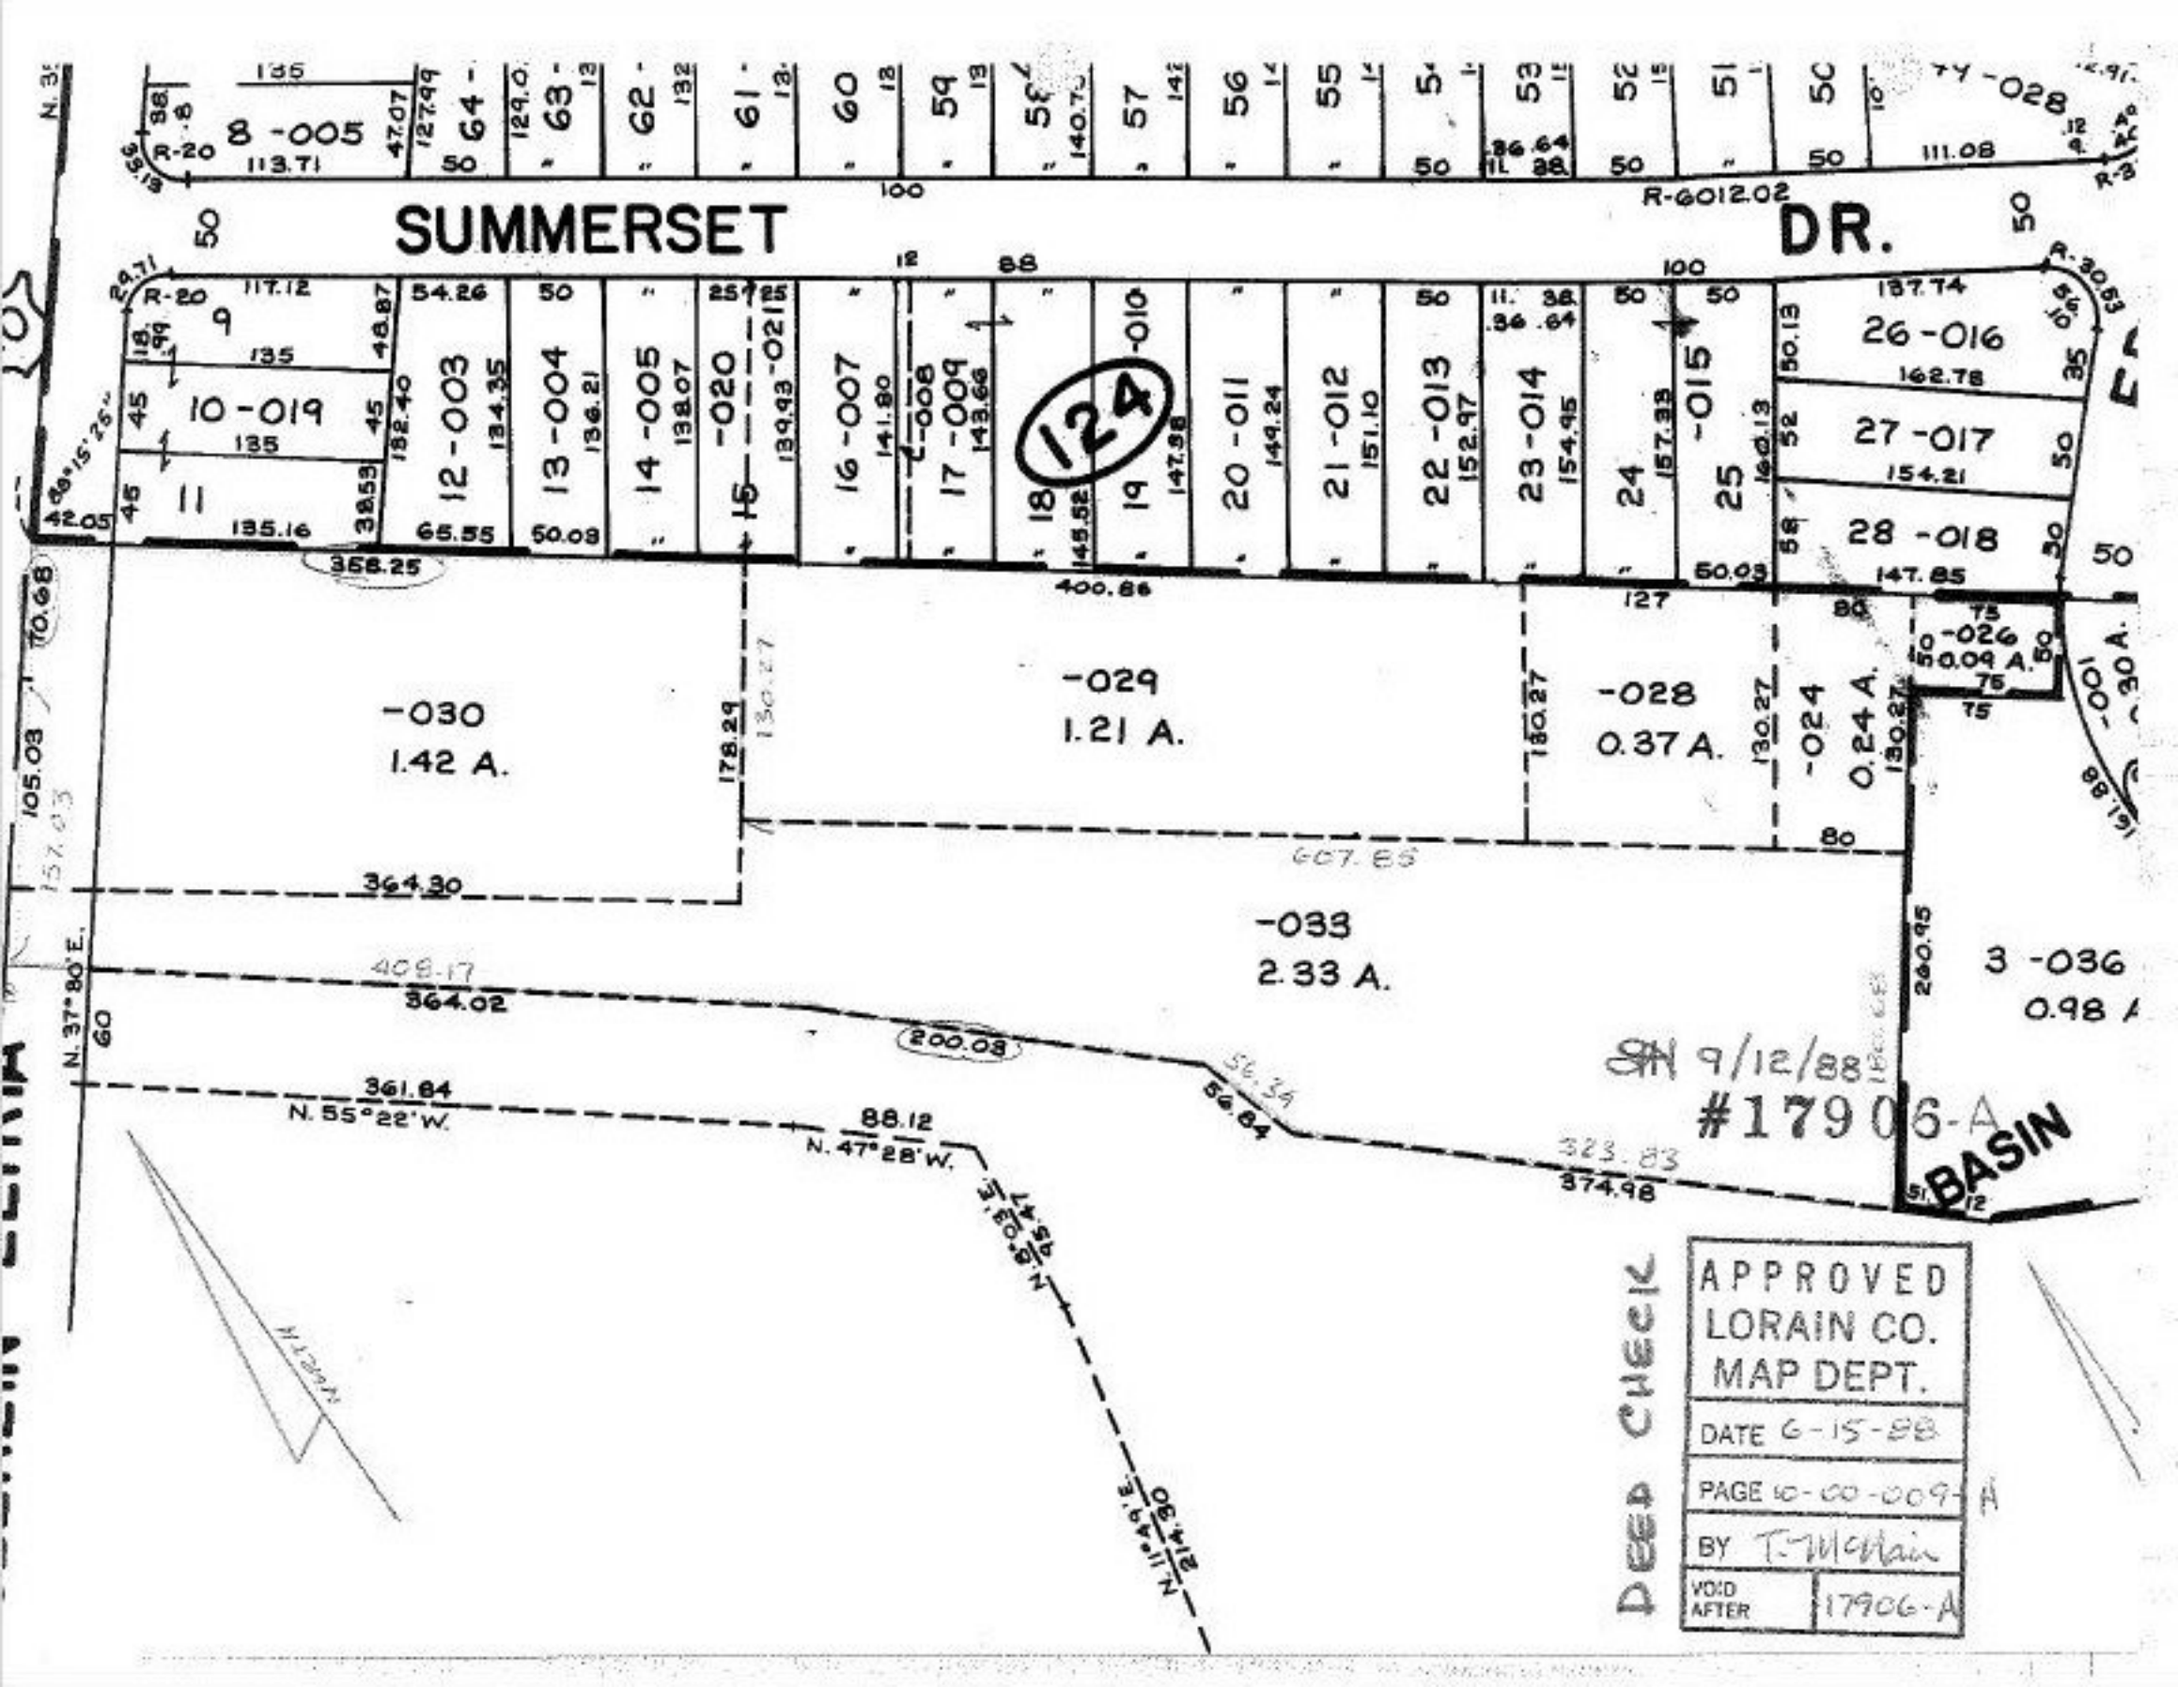
SUMMERSET
DR.
8 -005
113.71
64 -
63 -
62 -
61 -
60
59
57
56
55
54
53
52
51
50
111.08
R-6012.02
9
10 -019
135
11
135.16
12 -003
134.35
65.55
13 -004
136.21
50.03
14 -005
138.07
-020
139.93
16 -007
141.80
17 -009
143.66
18
145.52
19
147.38
20 -011
149.24
21 -012
151.10
22 -013
152.97
23 -014
154.95
24
157.33
25
160.13
26 -016
162.78
27 -017
154.21
28 -018
147.85
-030
1.42 A.
-029
1.21 A.
-028
0.37 A.
-024
0.24 A.
-026
0.04 A.
-001
0.30 A.
-033
2.33 A.
3 -036
0.98 A
400.86
364.30
364.02
361.84
N. 55° 22' W.
88.12
N. 47° 28' W.
200.08
56.34
56.84
323.83
374.98
N. 37° 80' E.
N. 15° 03' E.
N. 11° 49' E.
214.90
240.95
178.29
130.27
180.27
667.65
SN 9/12/88
#17906-A
BASIN
DEED CHECK
APPROVED
LORAIN CO.
MAP DEPT.
DATE 6-15-88
PAGE 10-00-009-A
BY T. McMain
VOID AFTER 17906-A