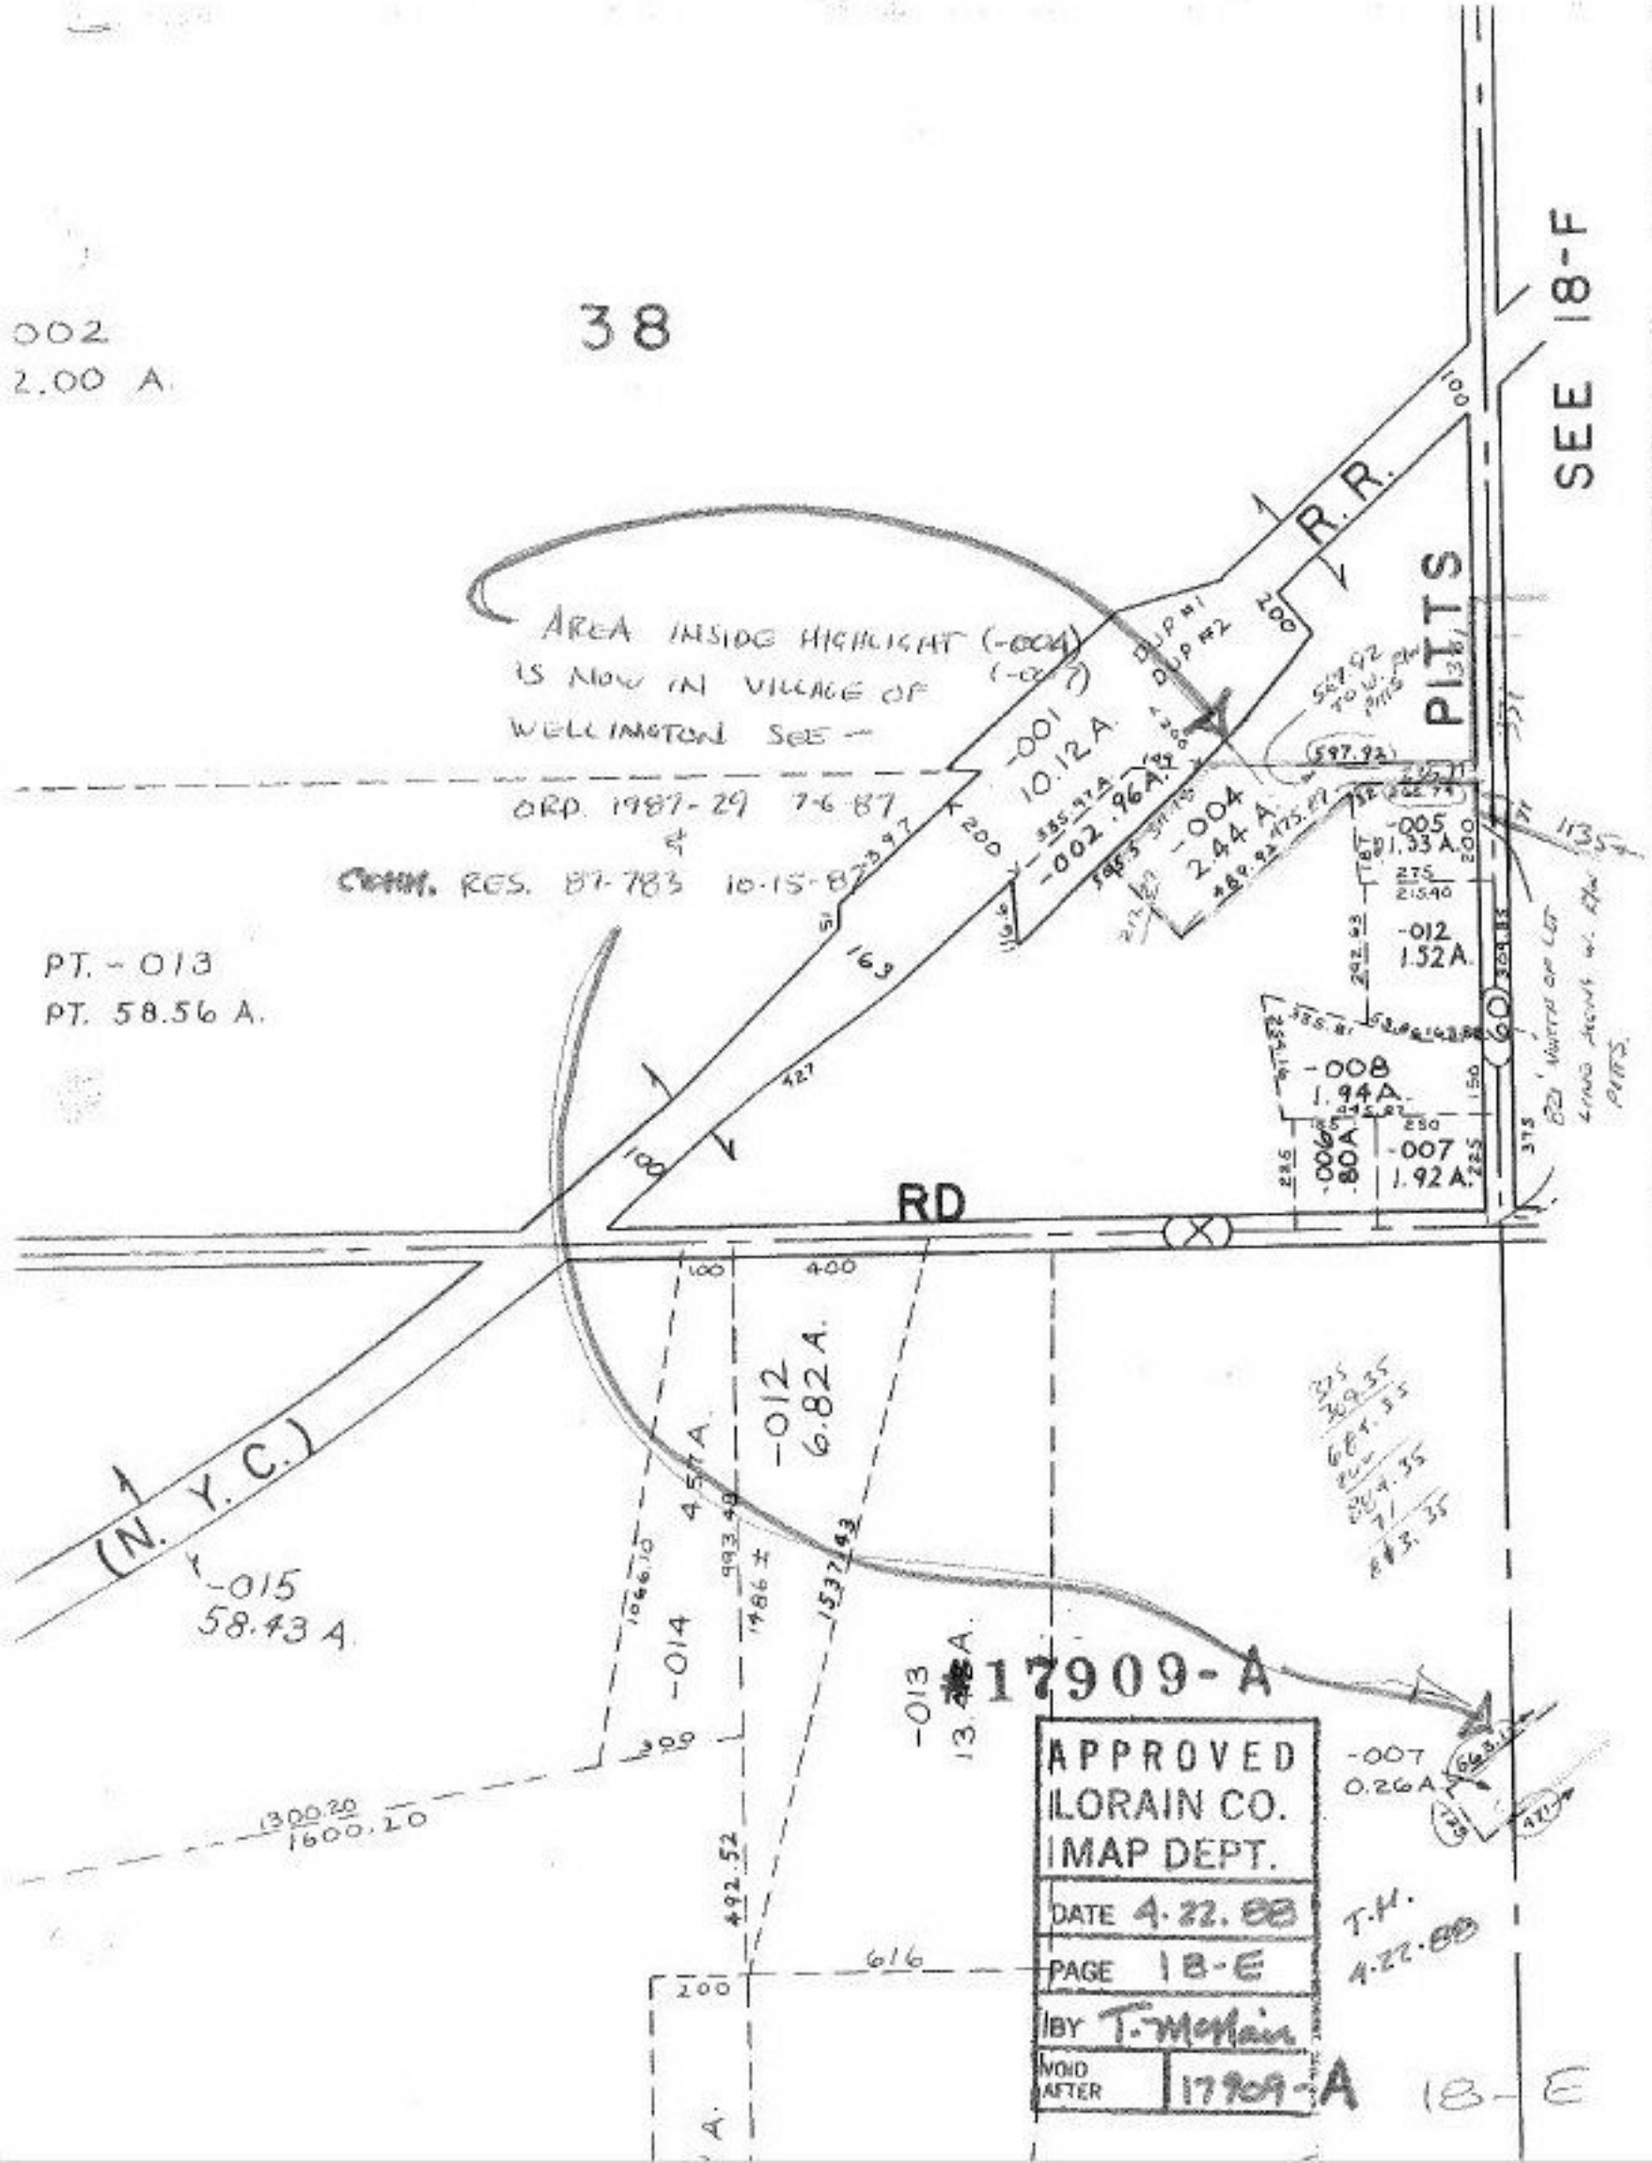
002
2.00 A.
38
SEE 18-F
R.R.
PITTS
AREA INSIDE HIGHLIGHT (-004) (-007) IS NOW IN VILLAGE OF WELLINGTON SEE --
ORD. 1987-29 7-6-87
COMM. RES. 87-783 10-15-87
PT. - 013
PT. 58.56 A.
-001
10.12 A.
-002 .96 A.
-004
2.44 A.
-005
1.33 A.
-012
1.52 A.
-008
1.94 A.
-006
.80 A.
-007
1.92 A.
RD
-012
6.82 A.
4.57 A.
(N. Y. C.)
-015
58.43 A.
-014
-013
13.46 A.
17909-A
-007
0.26 A.
APPROVED
LORAIN CO.
MAP DEPT.
DATE 4-22-88
PAGE 18-E
BY T. McMain
VOID AFTER 17909-A
T.M.
4-22-88
18-E