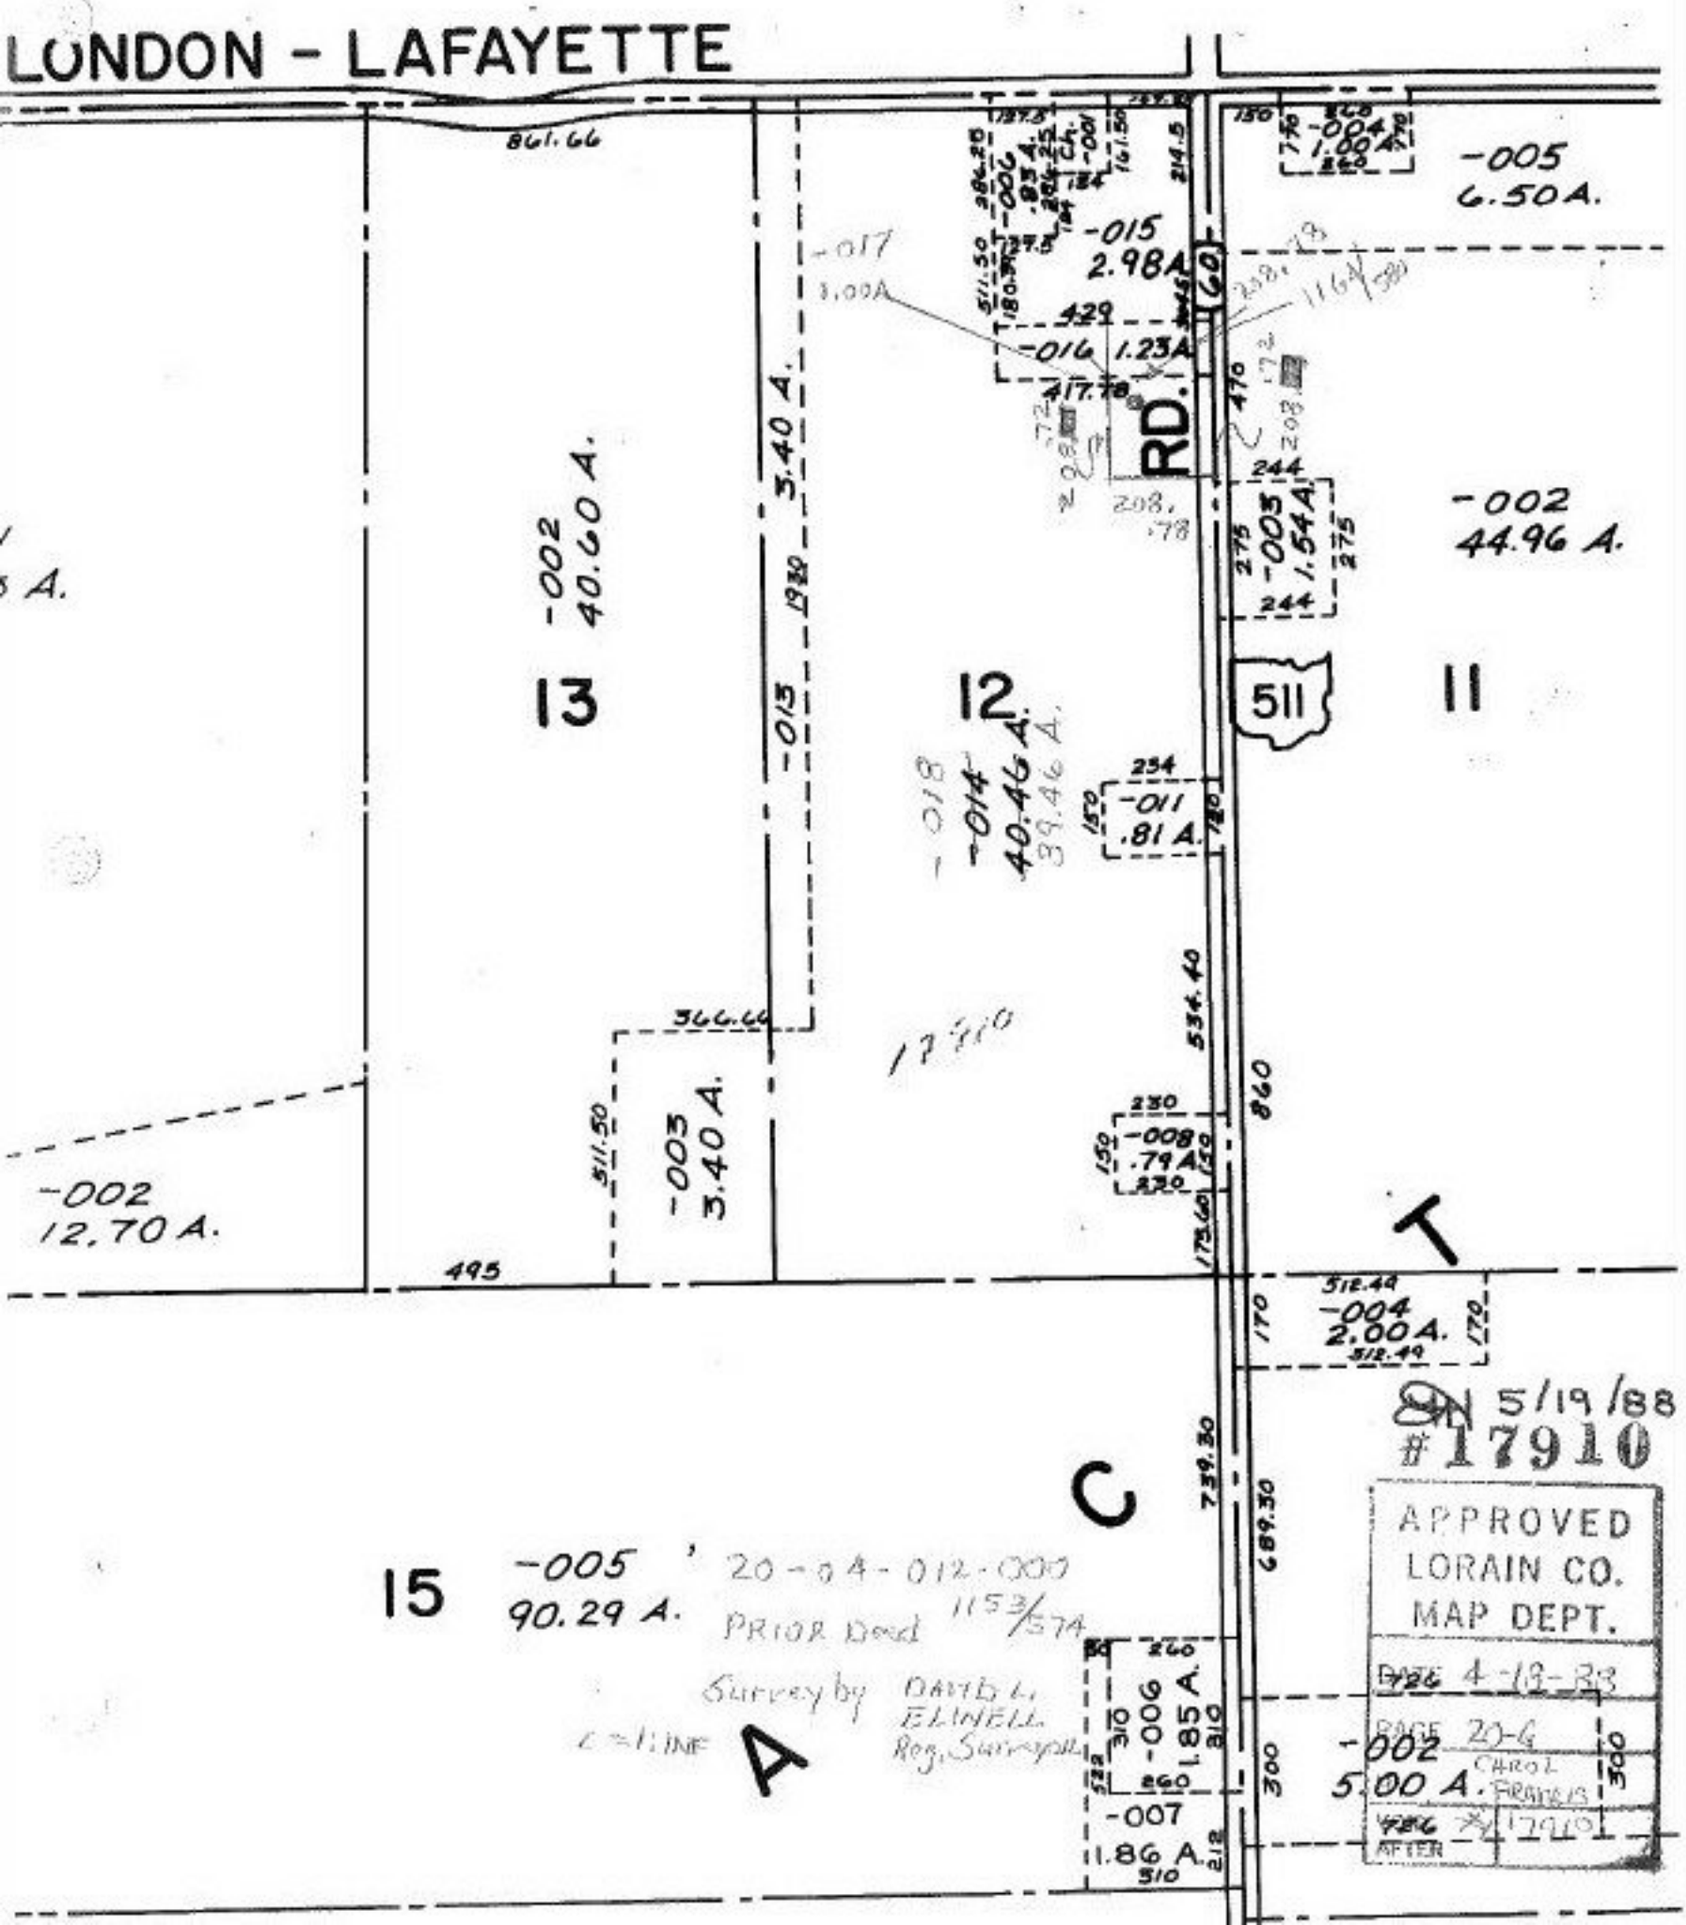
LONDON - LAFAYETTE
861.66
-005
6.50 A.
-004
1.00 A.
-015
2.98 A.
-017
1.00 A.
-016
1.23 A.
RD.
-002
44.96 A.
-003
1.54 A.
-002
40.60 A.
3.40 A.
13
12
11
511
-013
-014
40.46 A.
39.46 A.
-011
.81 A.
366.66
-003
3.40 A.
-002
12.70 A.
495
-008
.79 A.
-004
2.00 A.
T
C
15
-005
90.29 A.
20-04-012-000
PRIOR Deed 1153/574
Survey by DAVID L. ELWELL Reg. Surveyor
-006
1.85 A.
-007
1.86 A.
-002
5.00 A.
A
5/19/88
#17910
APPROVED
LORAIN CO.
MAP DEPT.
DATE 4-18-88
PAGE 20-6
CAROL FRANCIS
AFTER